


H114 Jan.

Midship Section of S.S. "T.E. Forster" 90A

Present Dimensions
Length between piers 200'-0"
Breadth Moulded 28'-0"
Depth from Top of Beam
to Top of Floor 16'-3"
693 Ton gross
Proposed Length 220 feet

1/2 Breadth 14
1/2 Girth 28'-5"
Depth as per rule 18'-5"
Length as per rule 61'-0" = 1st no
219
13.359
Under 12 depth

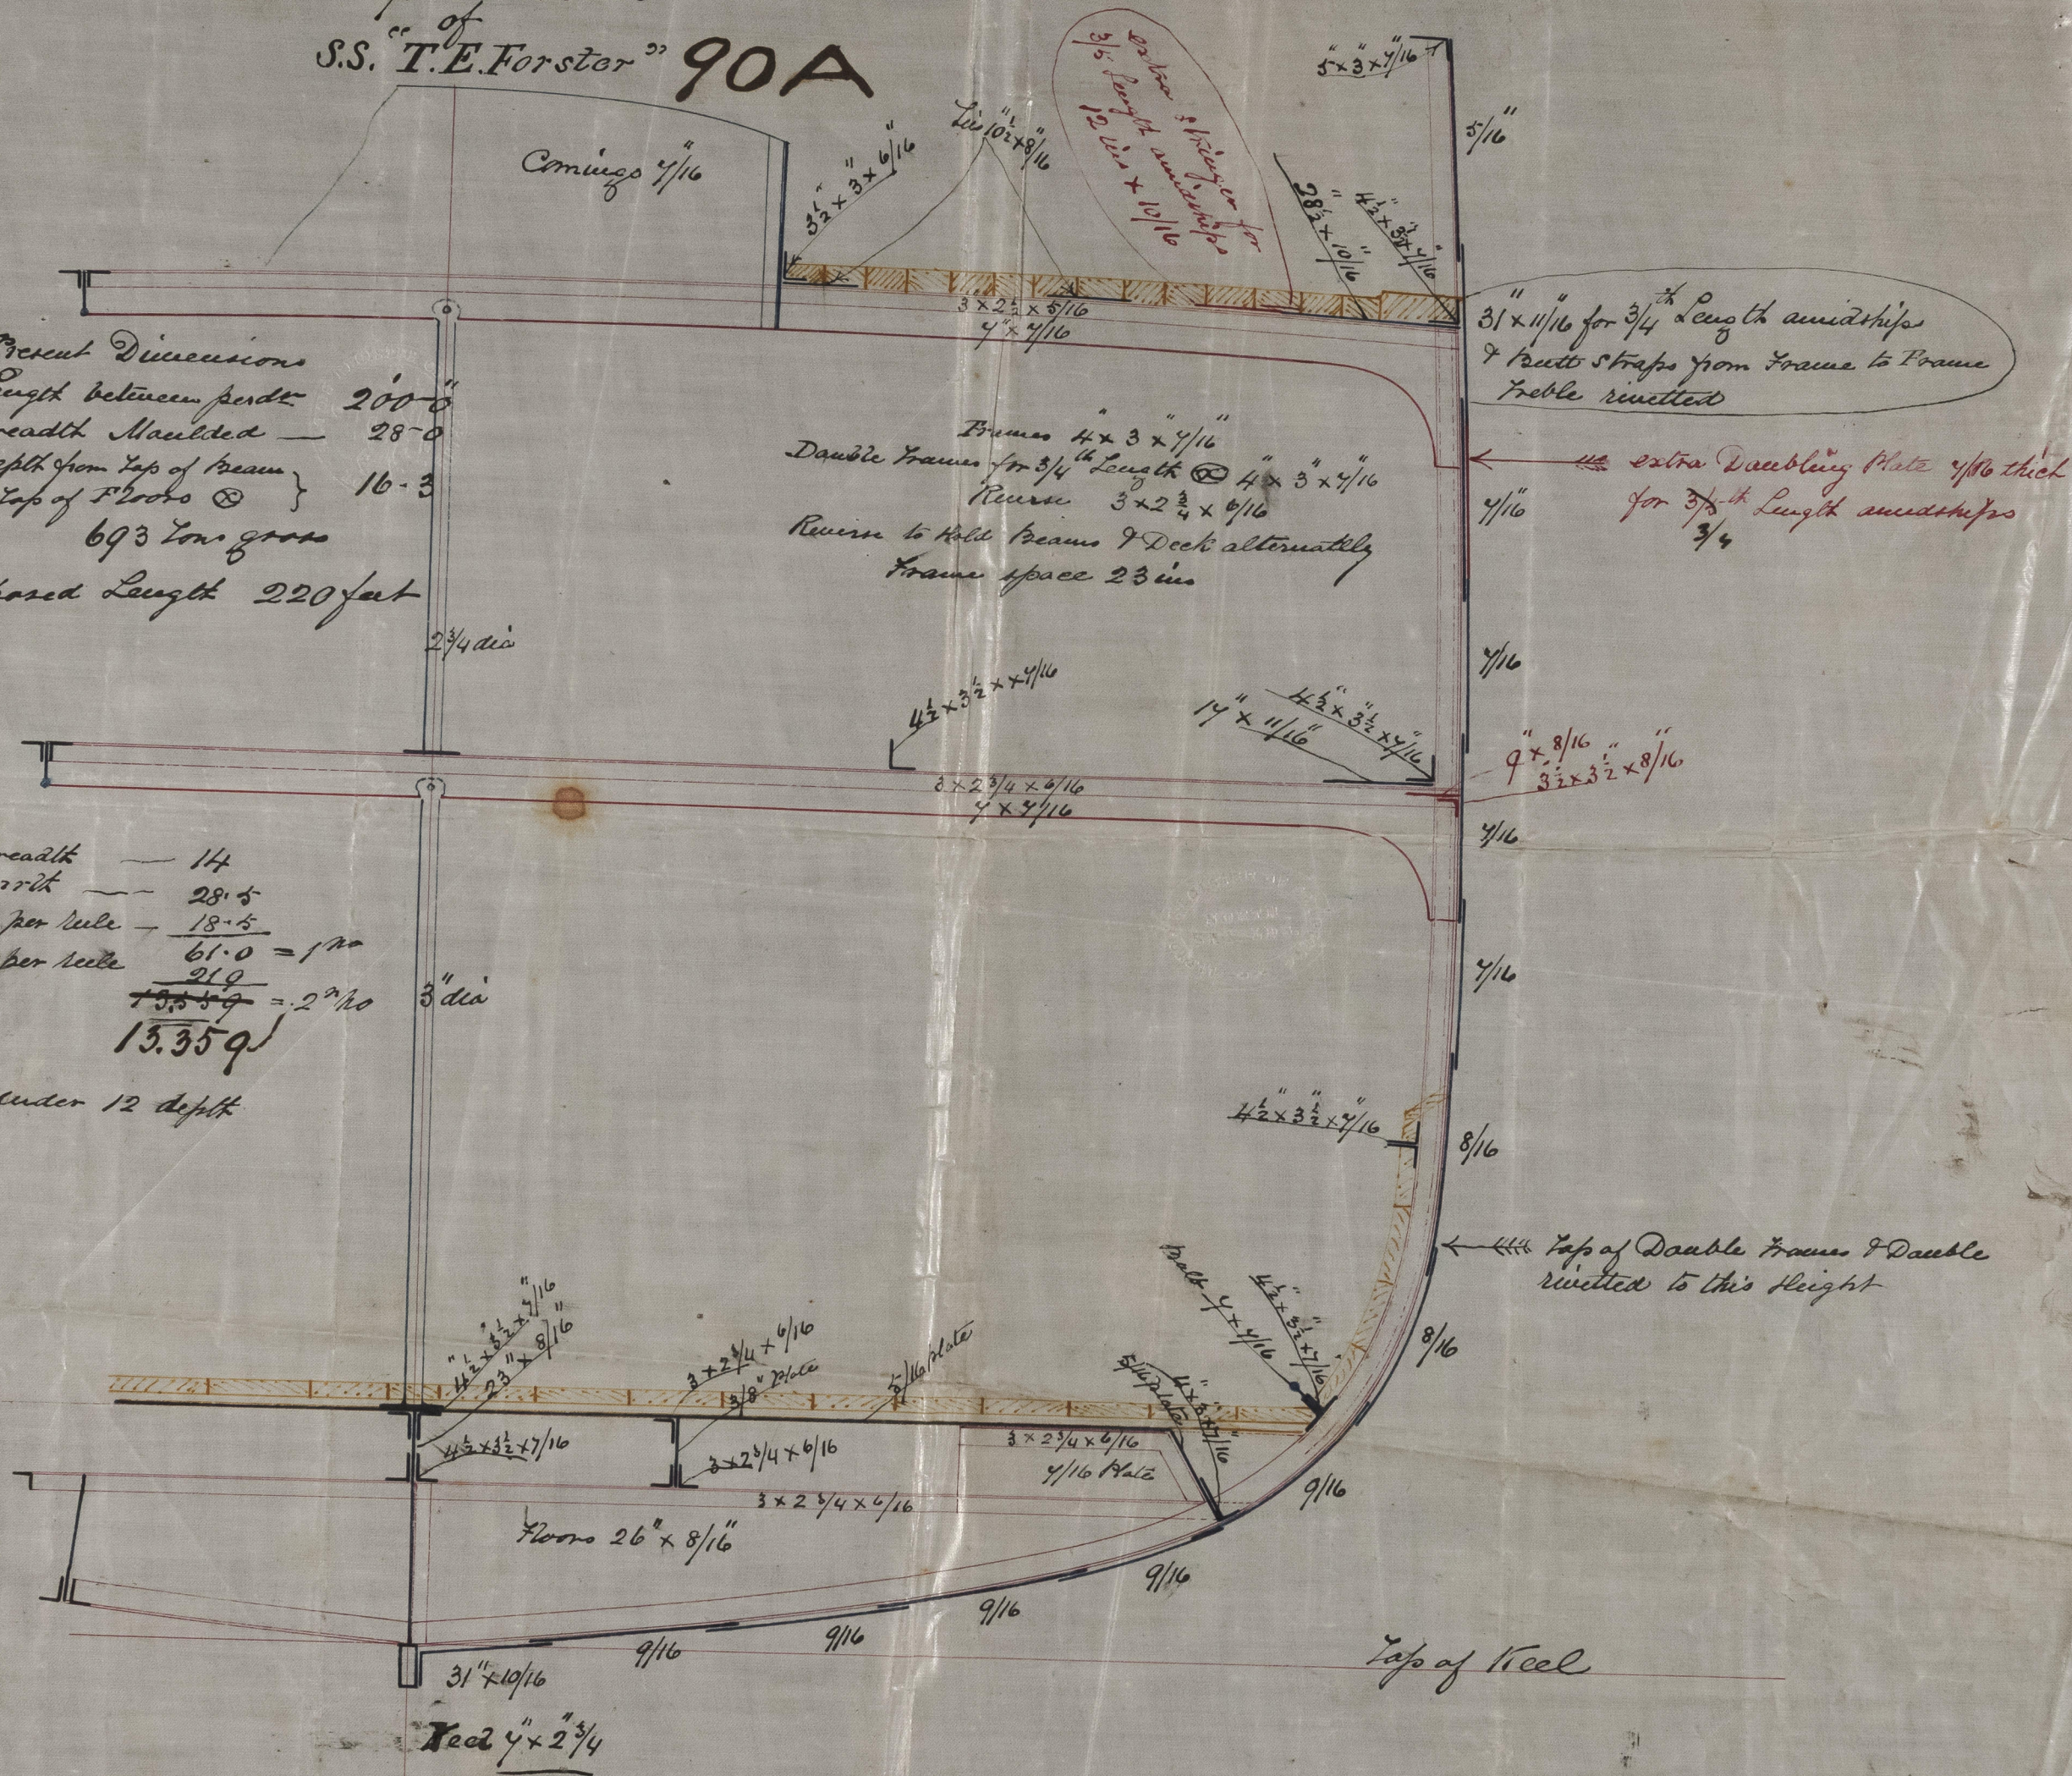

18th
Sept 9/72

Recd. London 7/9/72

for Mr. Smith
Ship Builders
North Shields
Messrs. Lloyd's Register
Foundation