


S. S. NO 132. *S. S. "Wentworth" Glasgow Report No 3626*

Length 211 feet 0 inches

Breadth 27 " 0 " = 7.81 Breadths in Length

Depth 16 " 3" = 12.98 Depths in Length

Class 100A

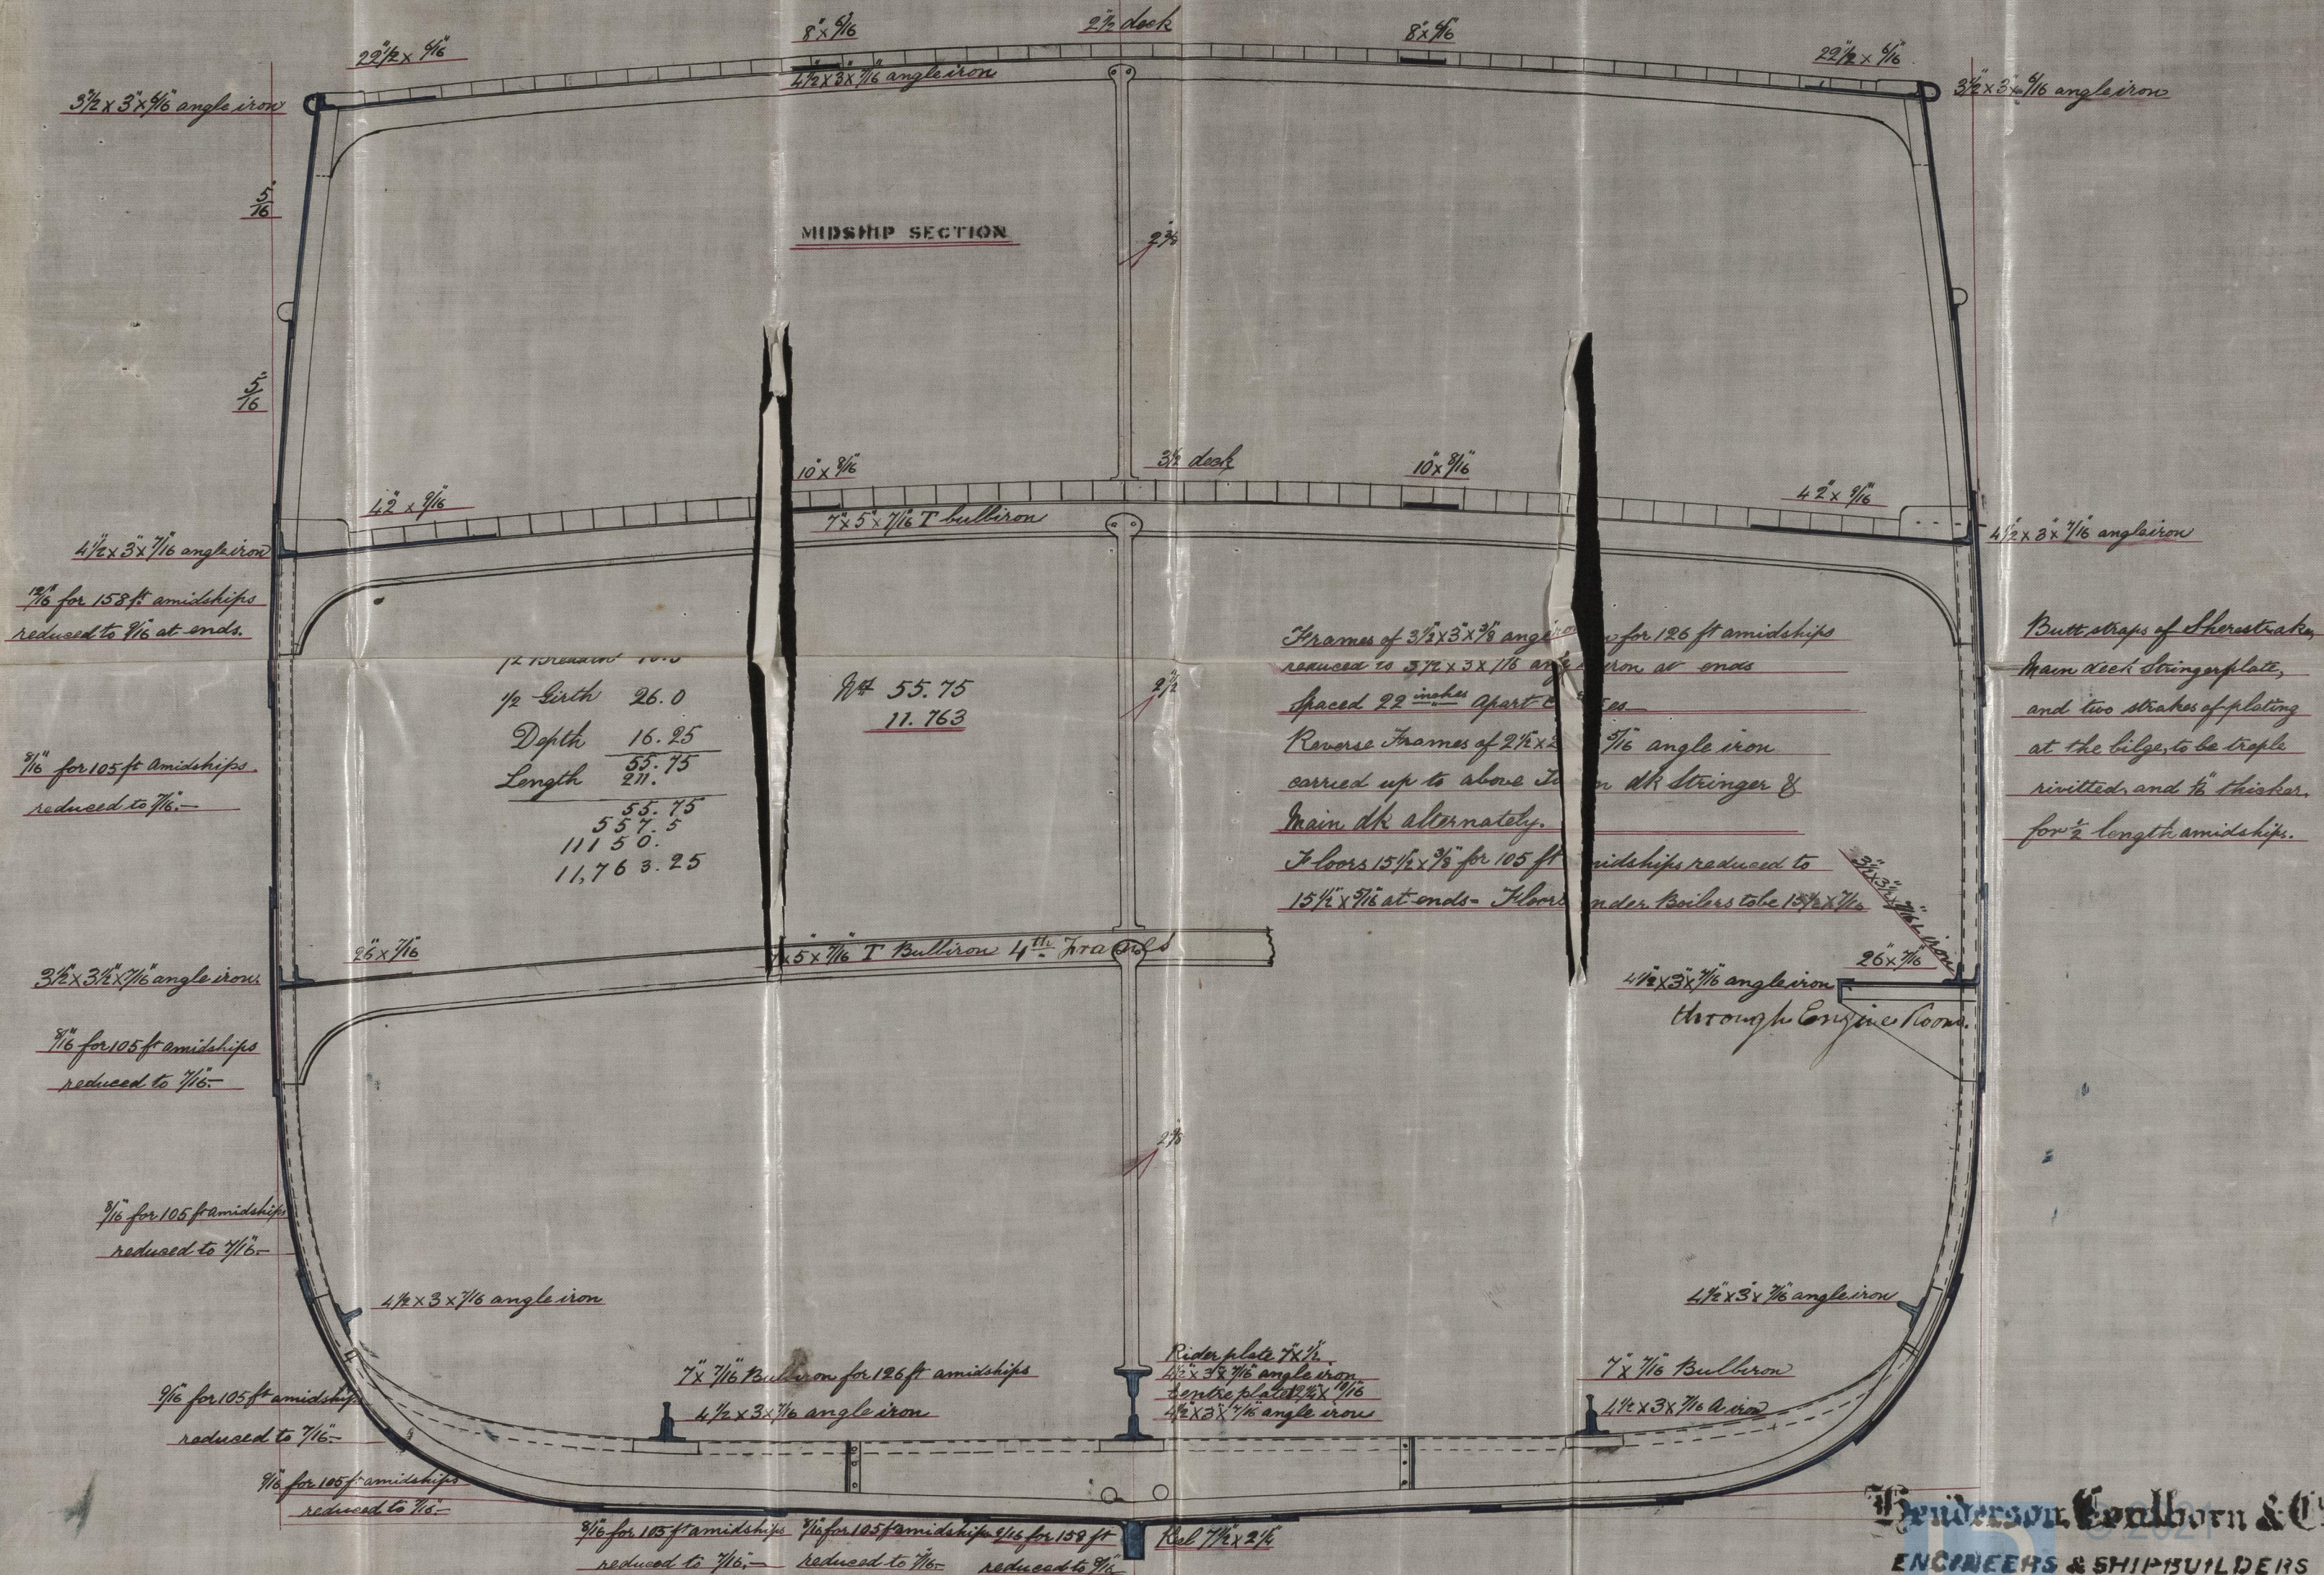

SCALE  $\frac{1}{2}$  INCH TO A FOOT

Henderson, Emlhorn & Co

## ENGINEERS & SHIPBUILDERS

*Slip Deck* **RENFREW**

IRON 206-0212