

Half moulded breadth - 12.416
 Depth from upper part of keel
 to top of upper deck beam } - 14.00
 Half girth of midship frame - 24.58
 50.996
 180.5
 254.980
 409.68
 509.96
 920.4780

Midship Section of an iron screw Steam Barge at Northfleet by Messrs Jackson & Blake proposed to Class. 90 A Throwing Deck & 9 No 3 Scale 2 inch to a foot 26/6/72


Depth to length - 12.8
 Breadth to length - 1.2

Principal Dimensions
 Length - 180.6
 Beam moulded - 24.10
 Depth, top of keel to top
 of upper deck beam - 14.0

Lloyd's Number
 9204.YY
 51.00

No for Equipment 10738.90

Rec from Mr Turner
 27/6/72

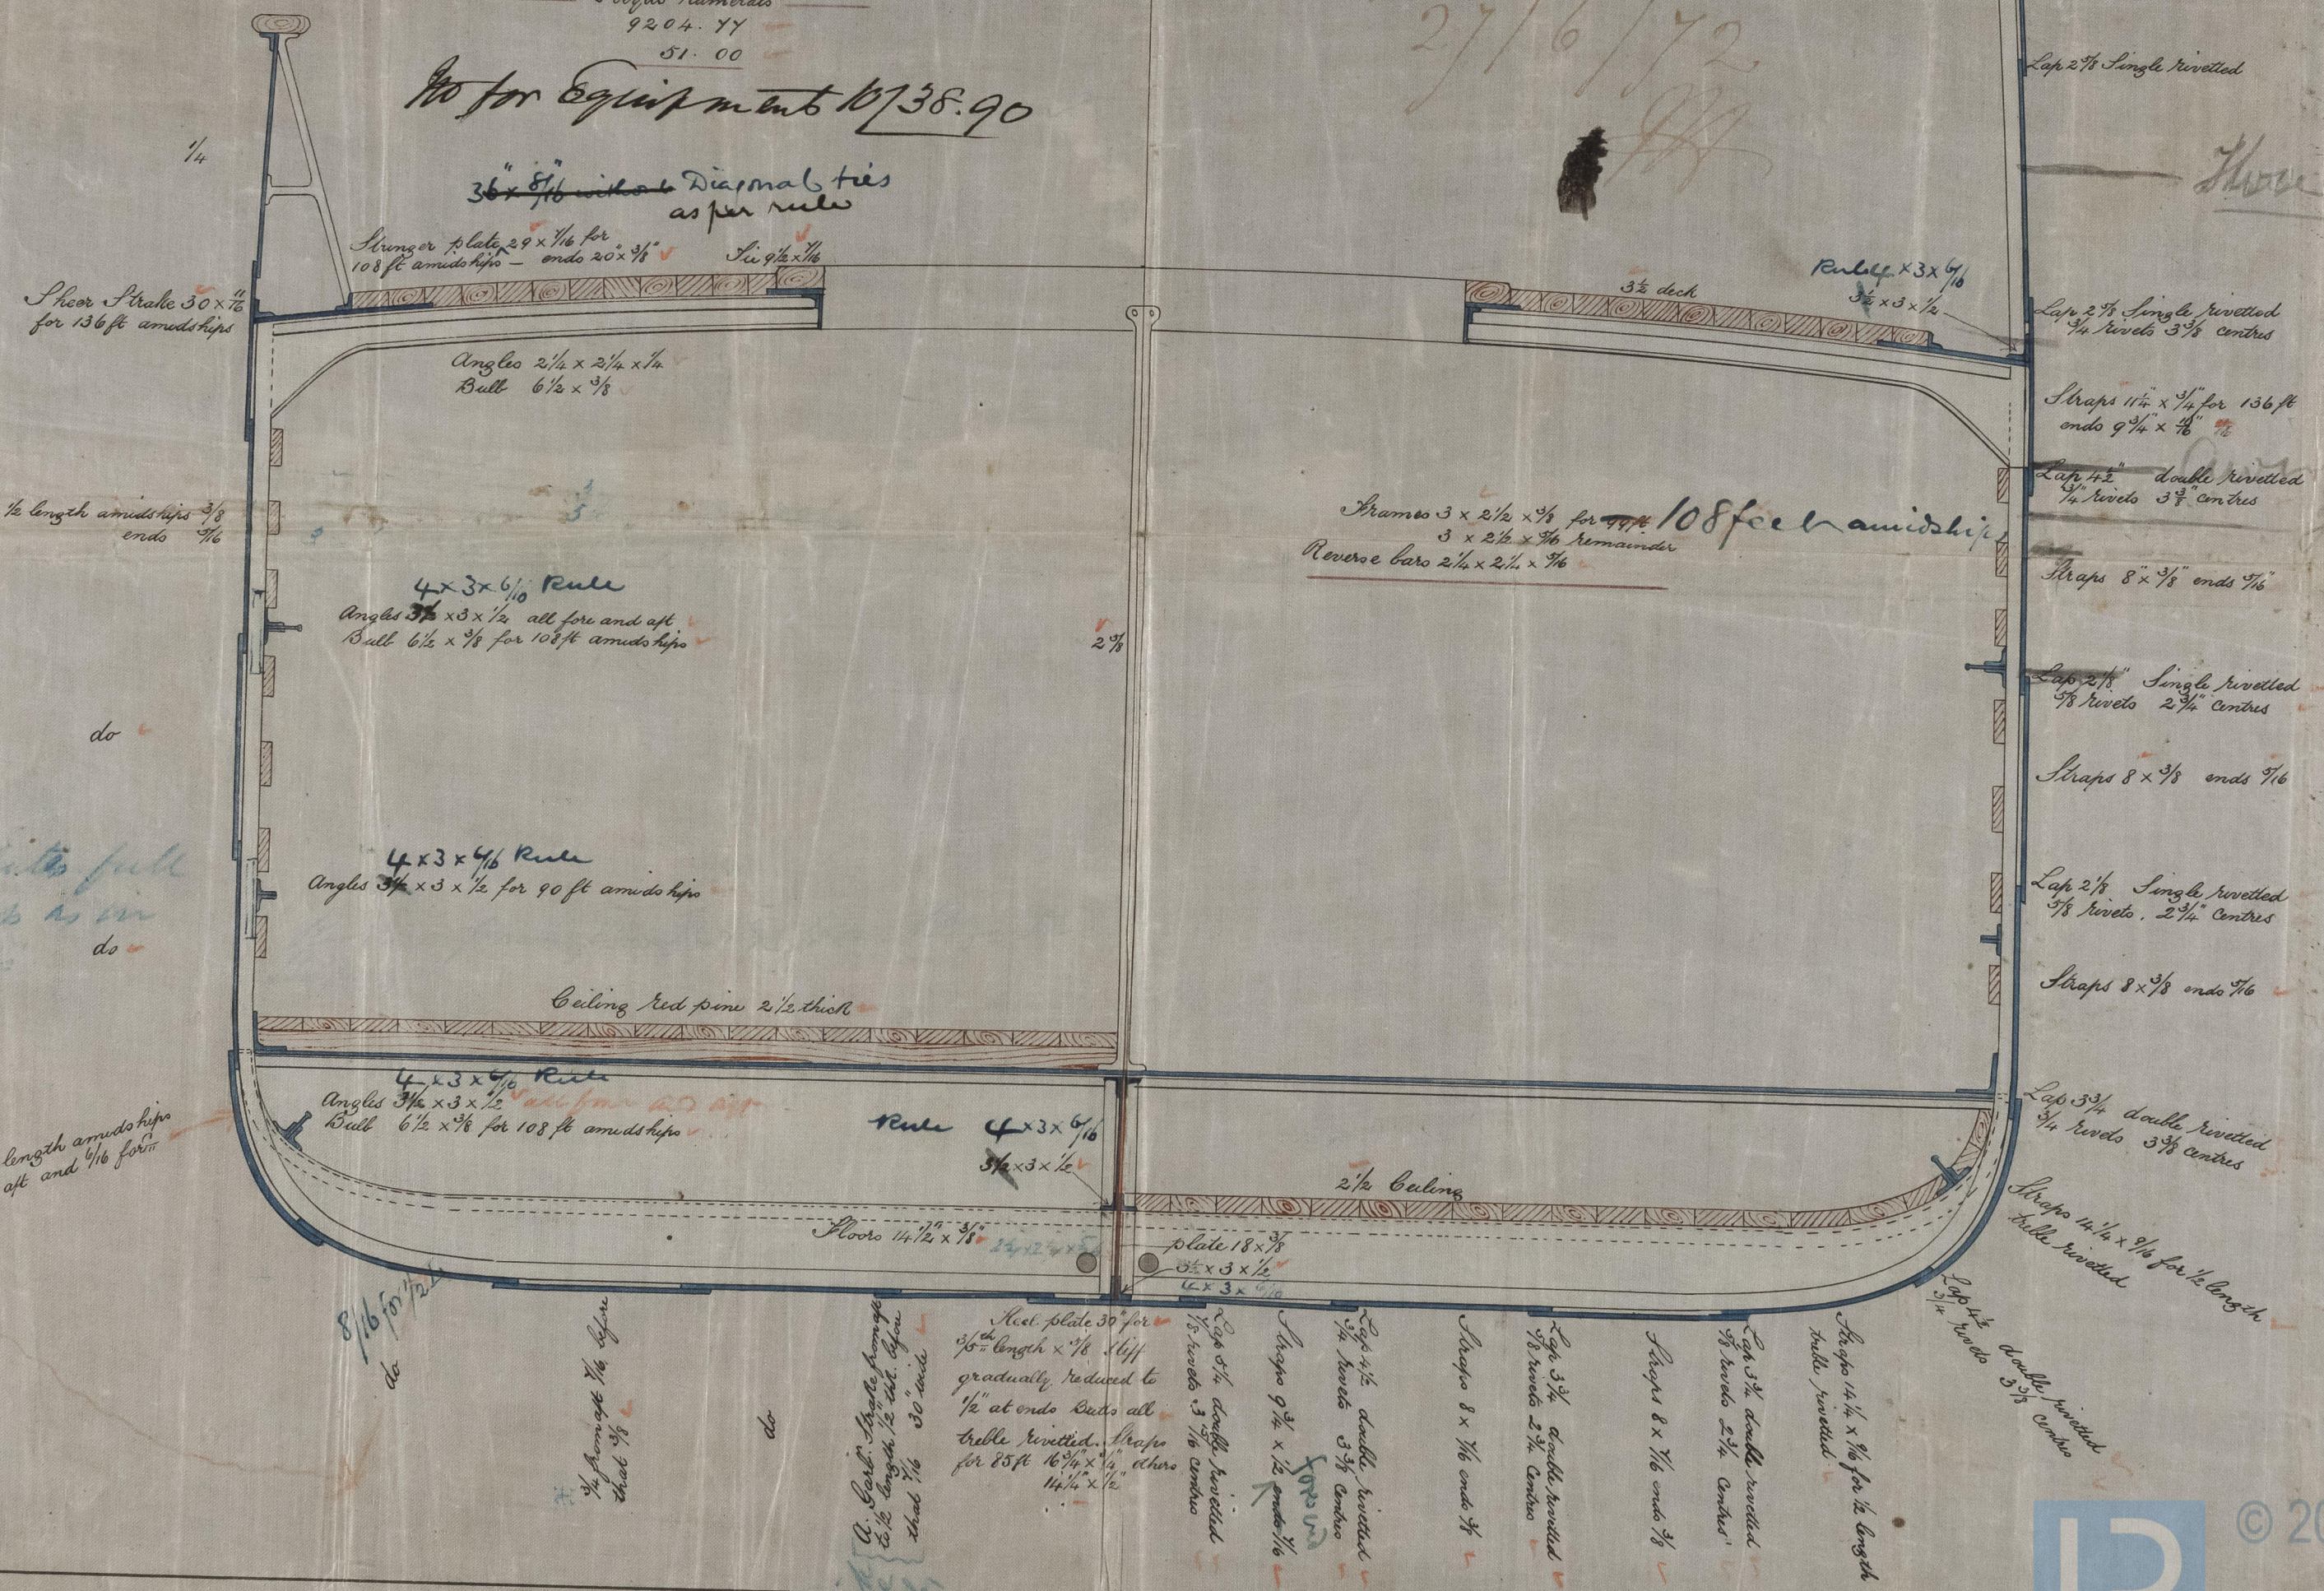

Lap 2 1/2" Single rivetted
 Lap 2 1/2" Single rivetted
 3/4" rivets 3 3/4" centres
 Straps 11 1/4 x 1/4 for 136 ft
 ends 9 1/4 x 1/4
 Lap 4 1/2" double rivetted
 3/4" rivets 3 3/4" centres
 Straps 8 x 3/8 ends 7/16
 Lap 2 1/2" Single rivetted
 3/4" rivets 2 3/4" centres
 Straps 8 x 3/8 ends 7/16
 Lap 2 1/2" Single rivetted
 3/4" rivets 2 3/4" centres
 Straps 8 x 3/8 ends 7/16
 Lap 3 3/4" double rivetted
 3/4" rivets 3 3/4" centres
 Straps 11 1/4 x 1/4 for 136 ft
 ends 9 1/4 x 1/4
 Lap 4 1/2" double rivetted
 3/4" rivets 3 3/4" centres
 Straps 8 x 3/8 ends 7/16

11178 Jan

IRONS06-0215



© 2021

Lloyd's Register Foundation