

Mudship Section for No 32 S.S. Messrs Turnbull & Son

S. L. Douglass
Report No. 3171


Scale $\frac{1}{2}$ in. = 1 foot.

05611


Over 12 depths α of breadths

Rev 24/6/72

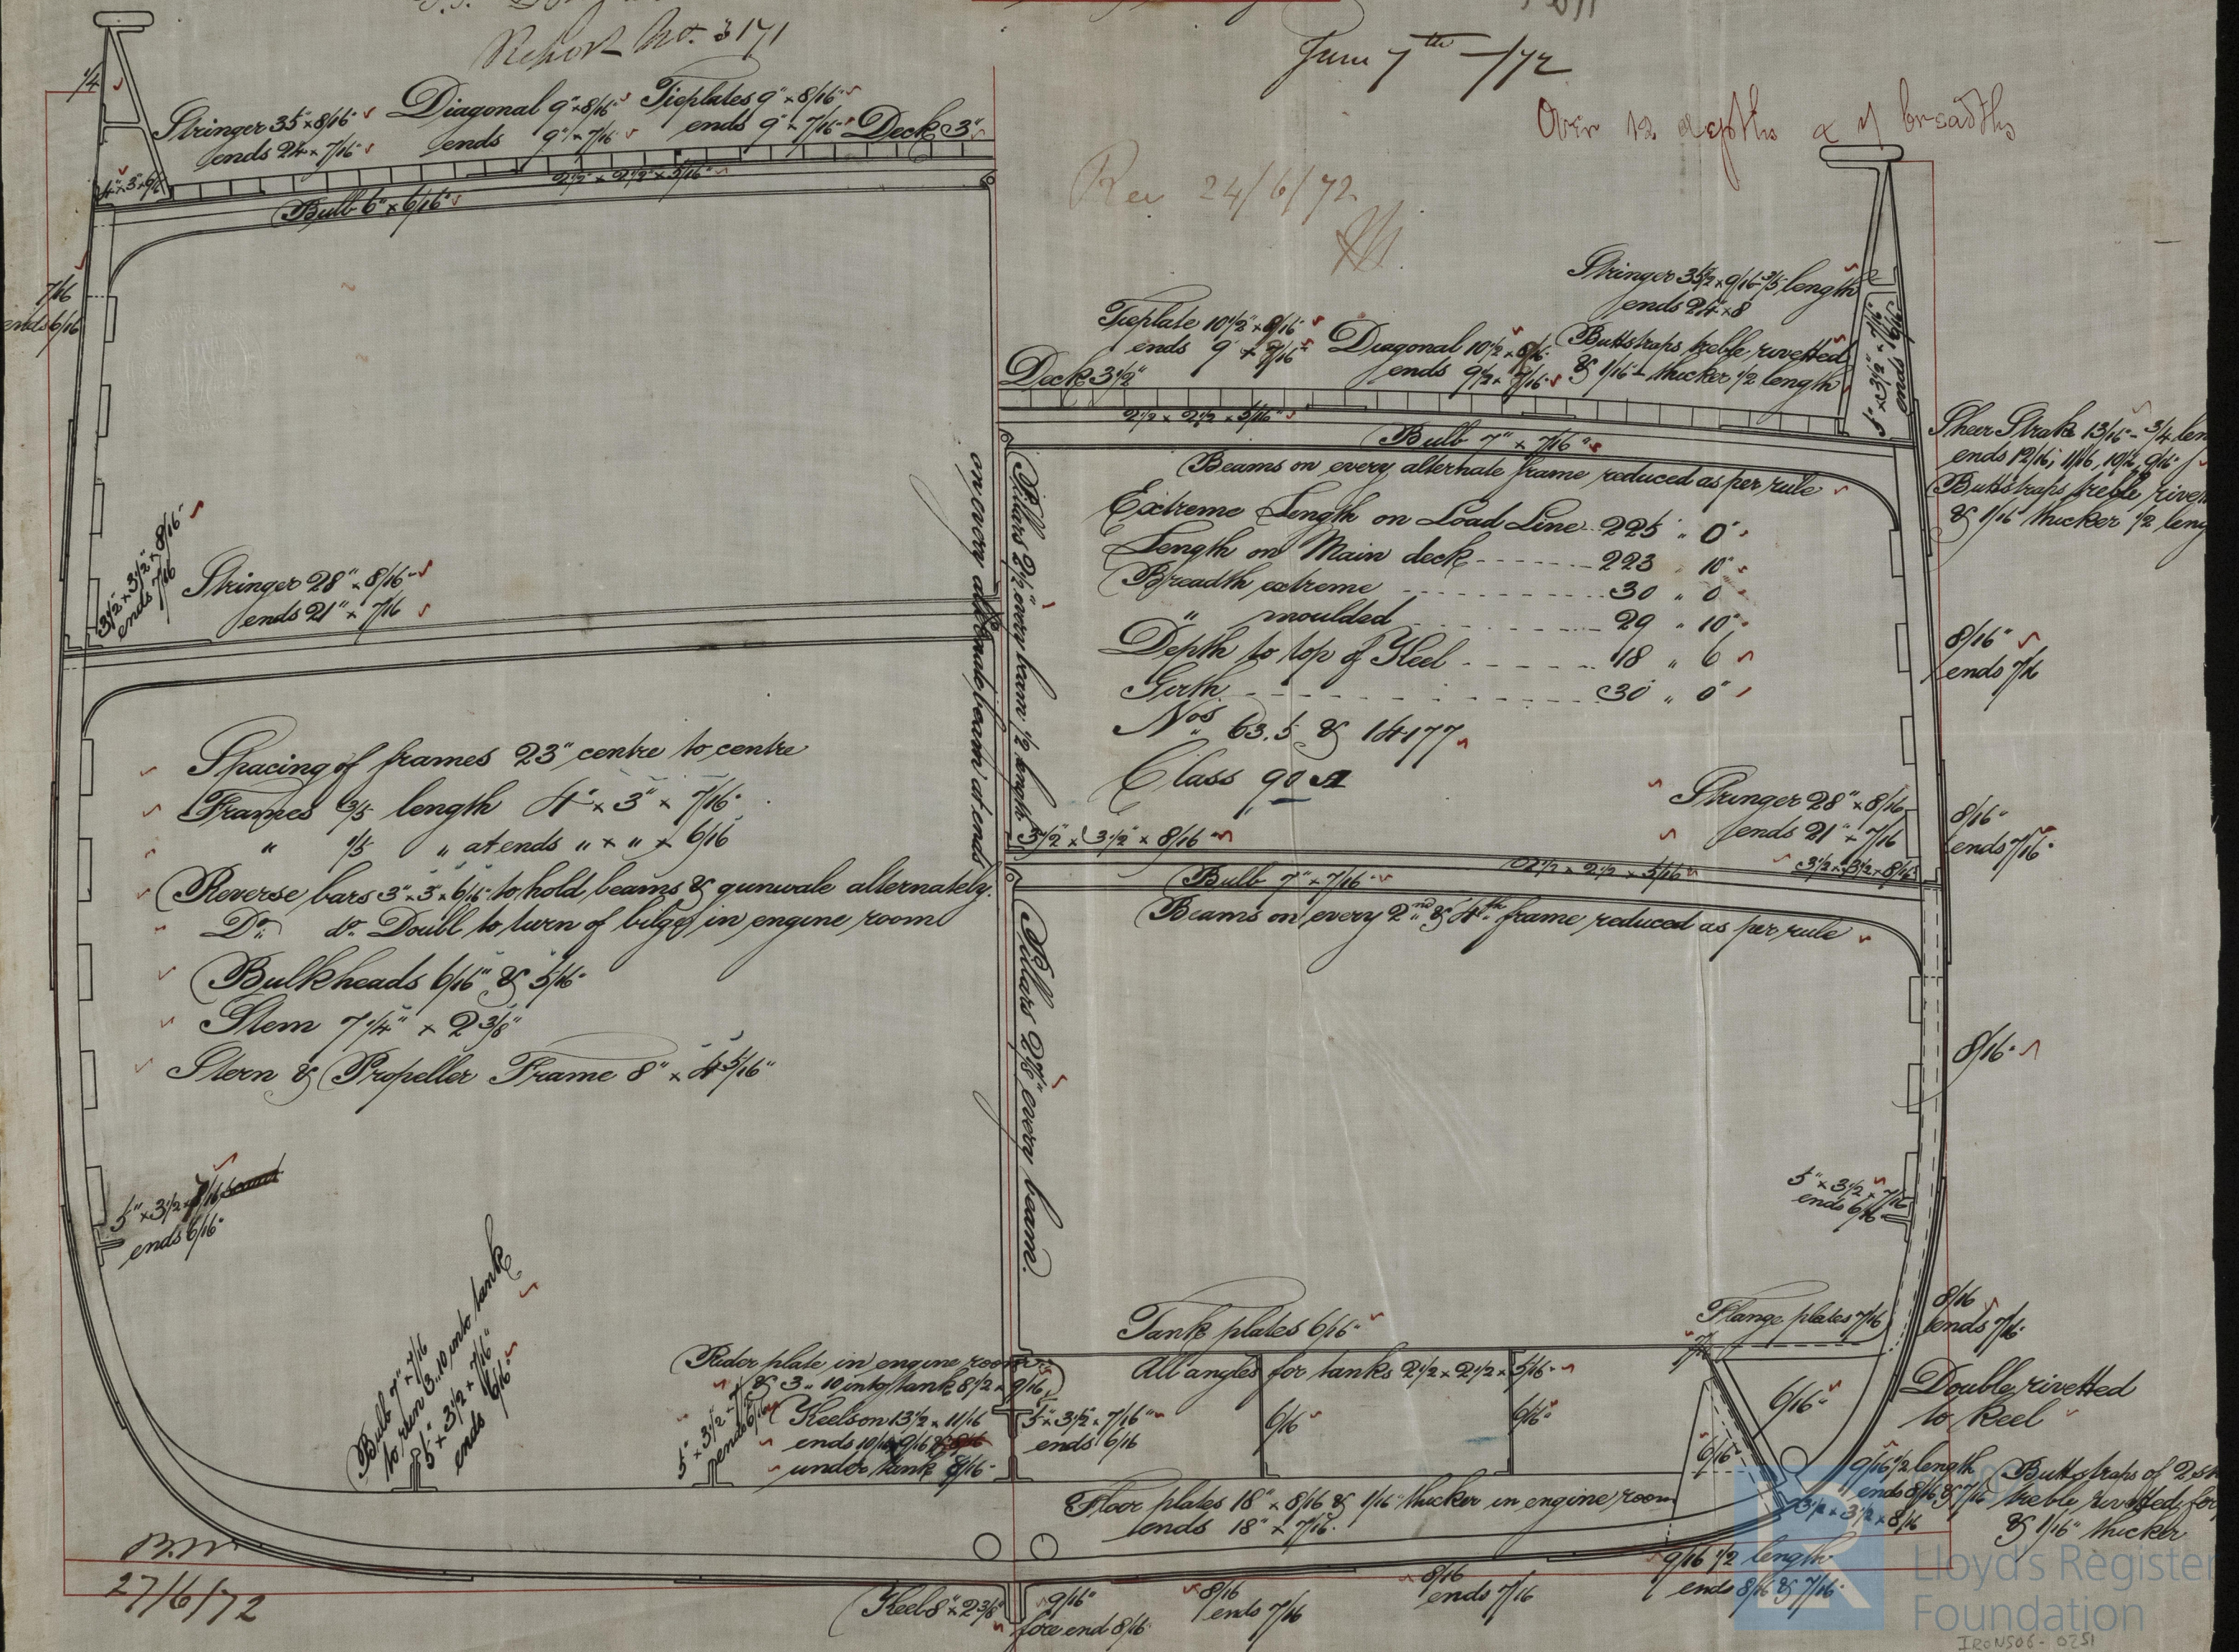


Lloyd's Register
Foundation

IRONS06-0251

11270 Iron

IRON 506-0251

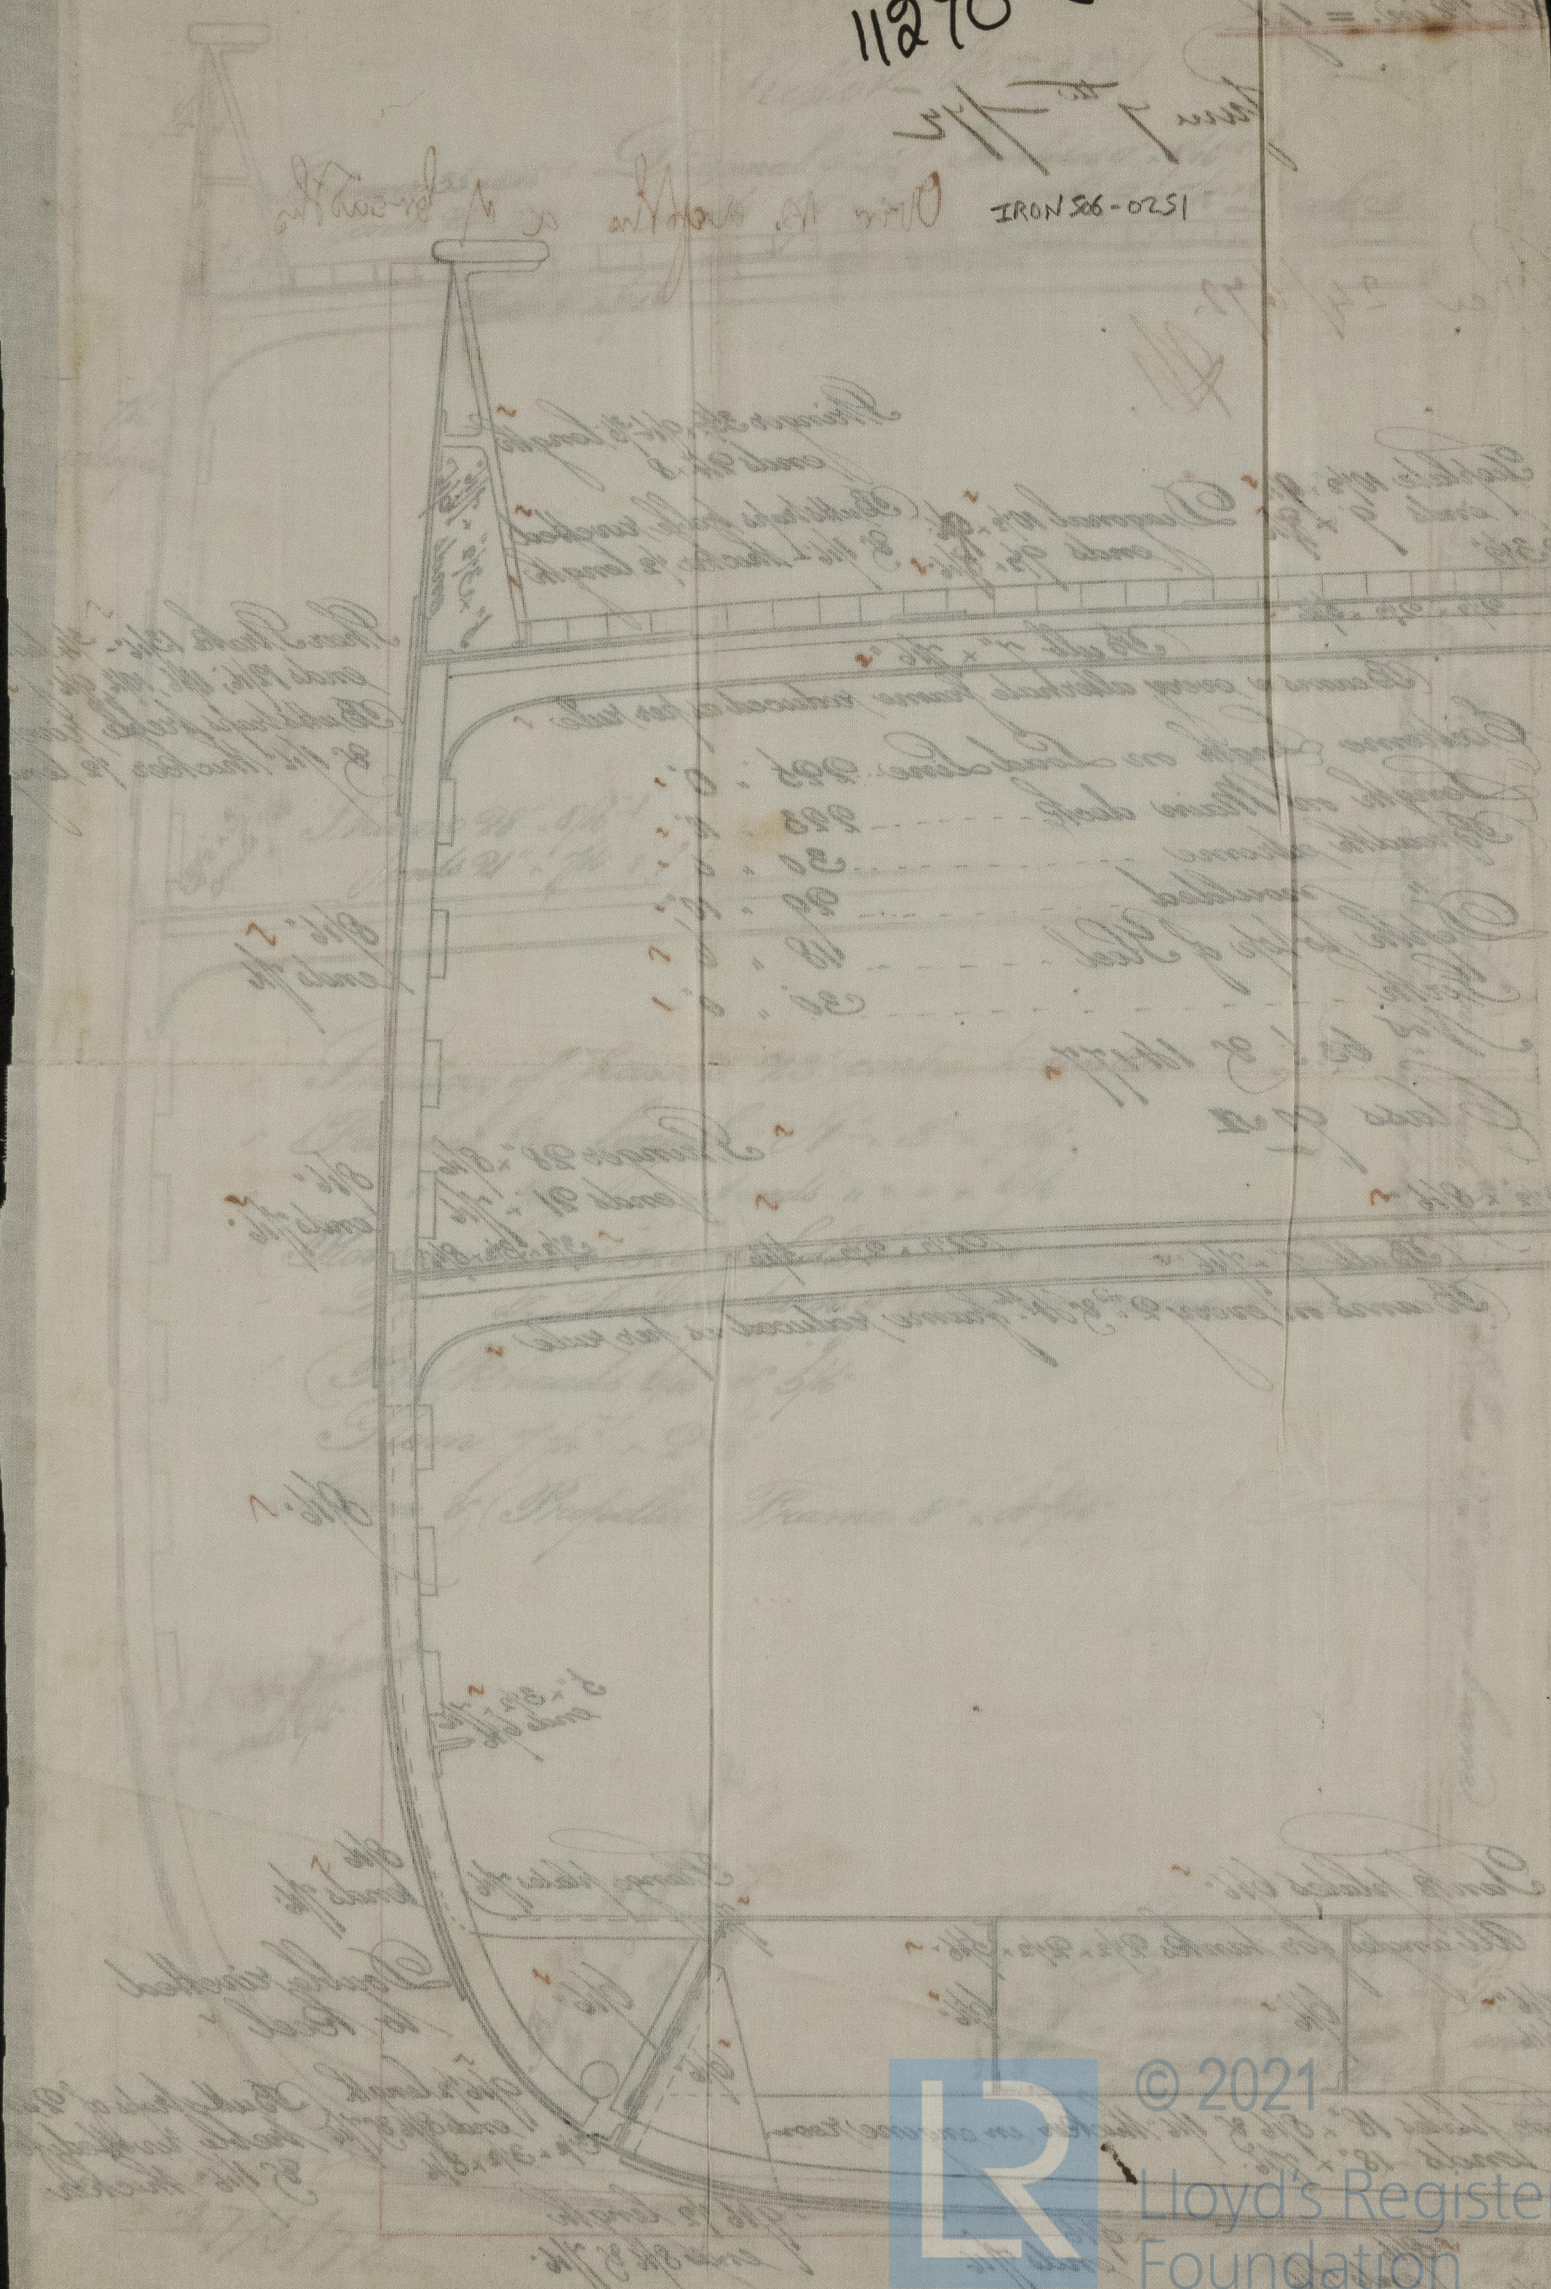

© 2021

Lloyd's Register
Foundation