


S.S. "PETER GRAHAM" Recd. London 11/14/72

Midship Section № 293.

Scale  $\frac{1}{2}$  inch = one foot

Depths to length 10.49  
Breadths to  $d^2$  7.11

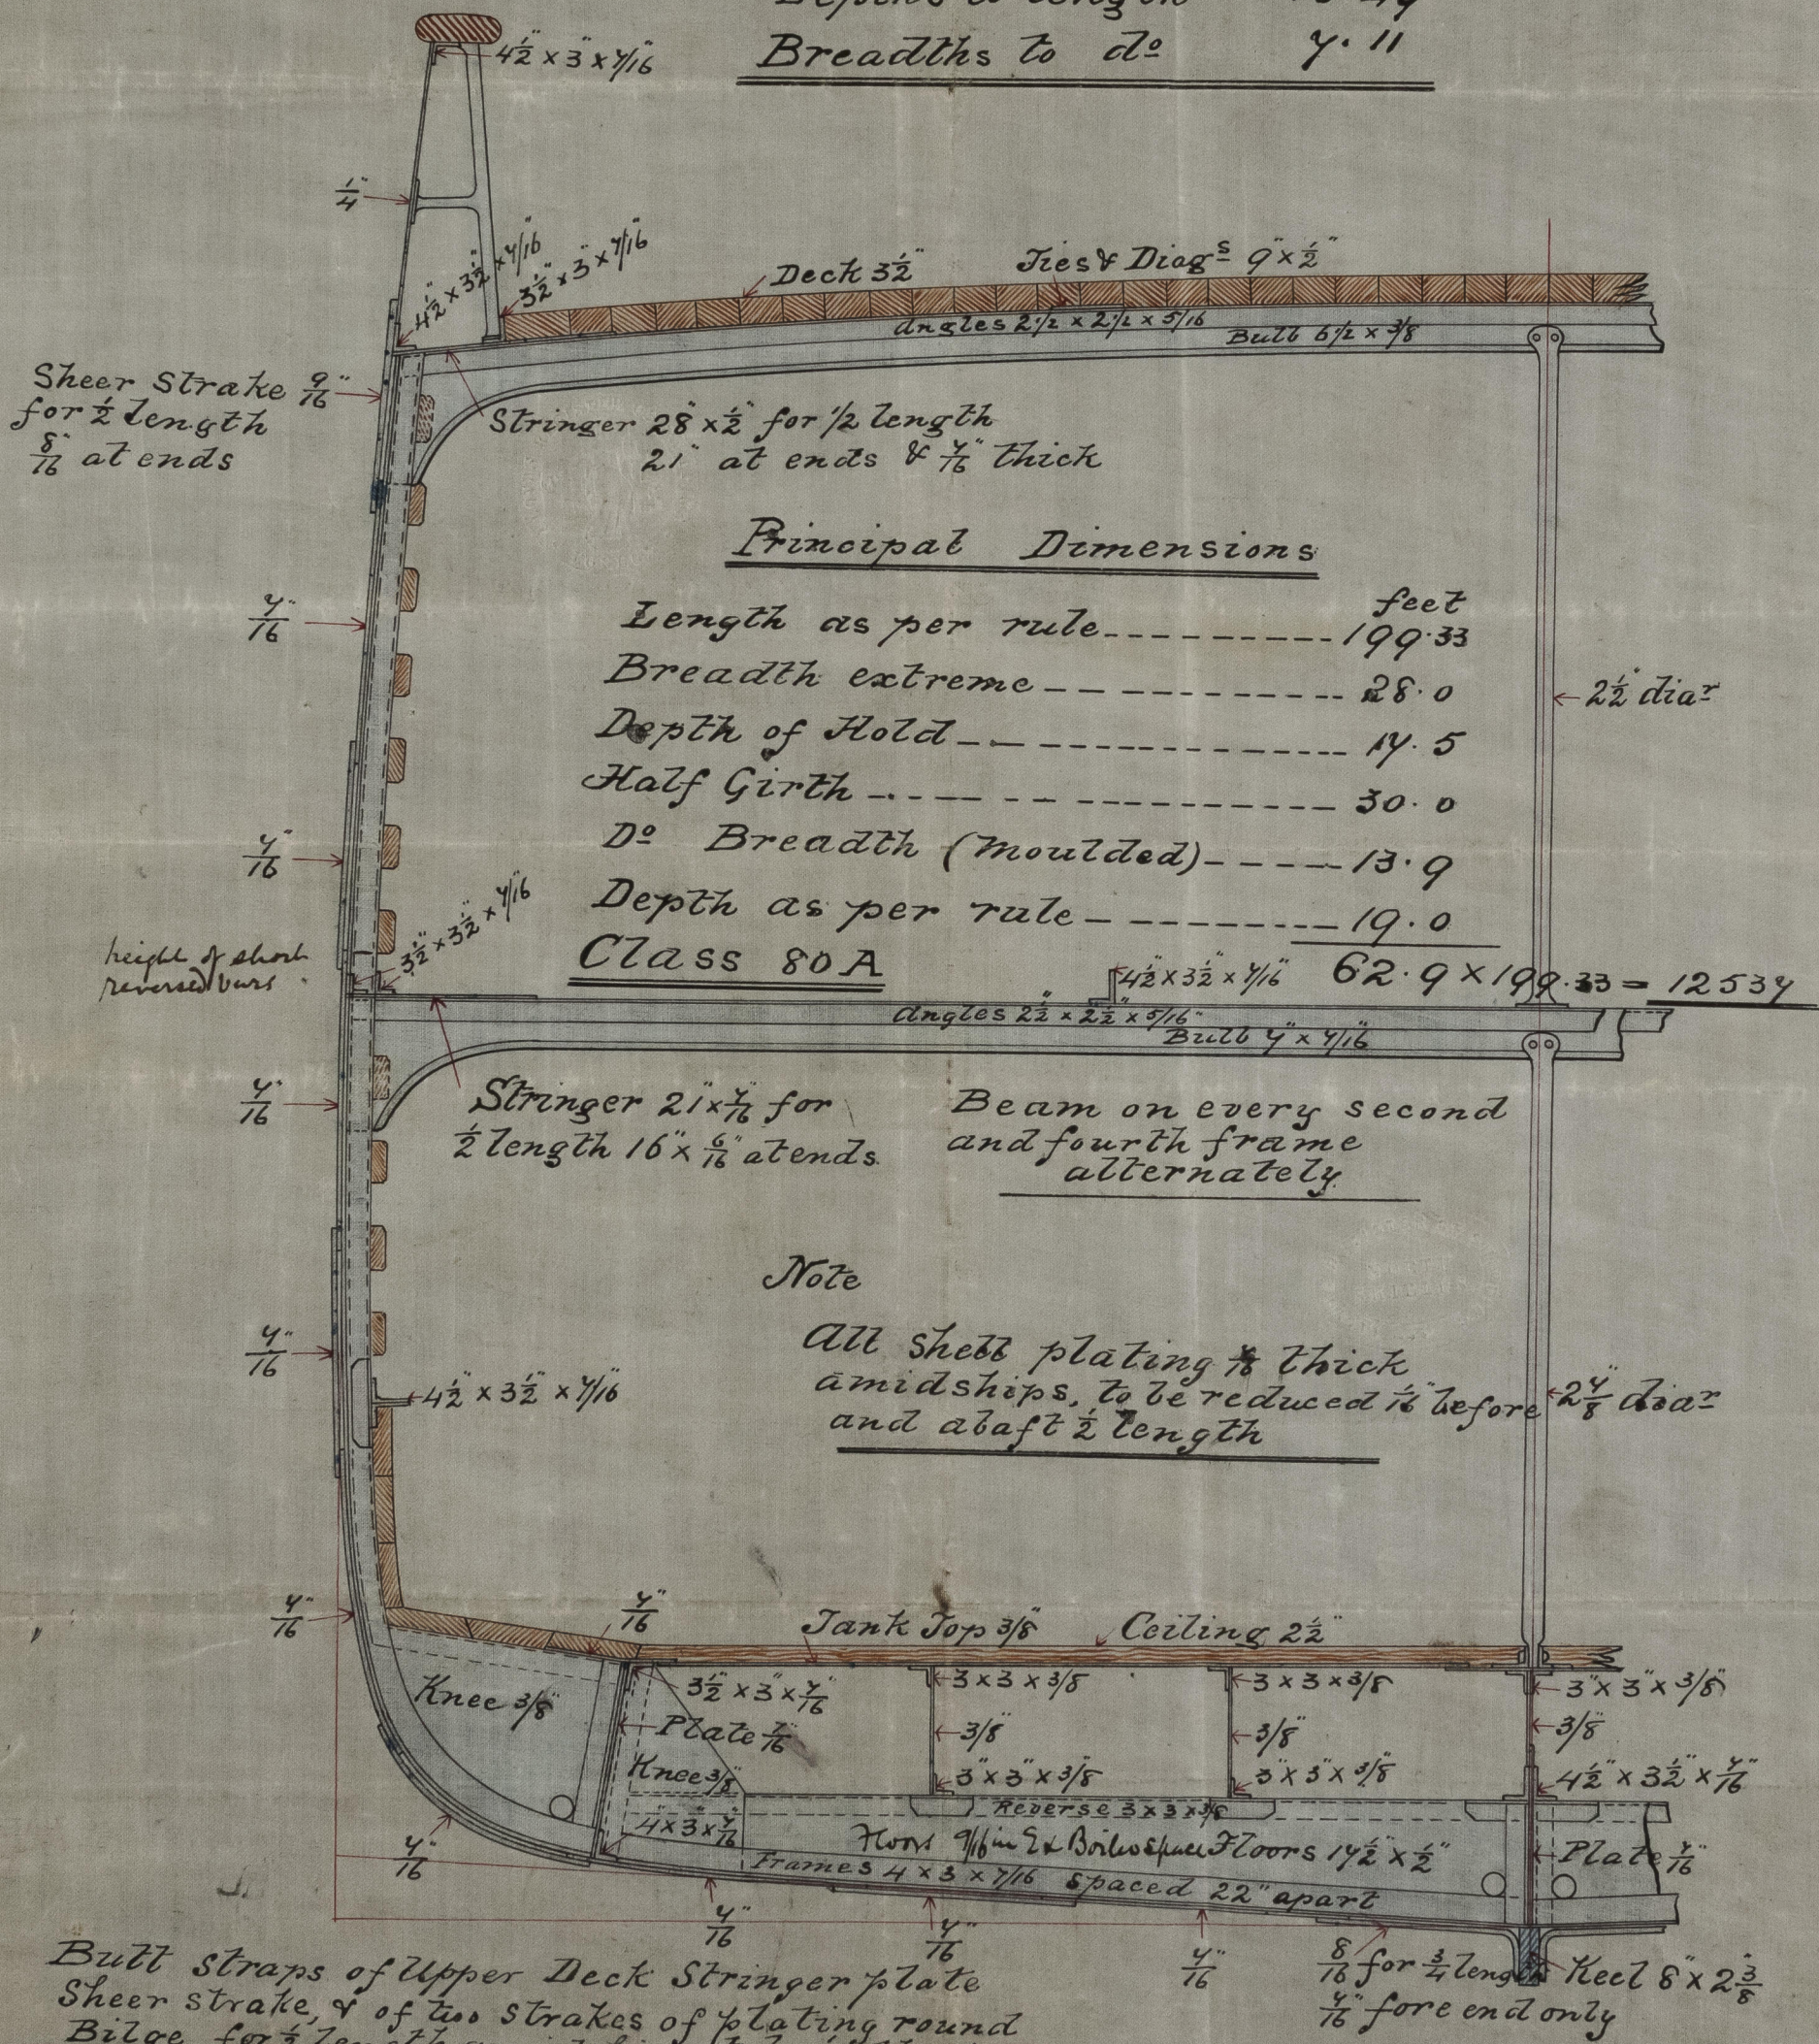

Bull Straps of Upper Deck Stringer plate  
Sheer strake, & of two strakes of plating round  
Bilge, for  $\frac{1}{2}$  length amidships to be  $\frac{1}{8}$  thicker  
than the plates they connect & treble rivetted

11/4/32



11373 Lion

Palm

Shipbuilding & Iron Co. Ltd.

Midship Section

Scale 1 inch = 50 ft

Depth of hold

Breadth of hold

Sheer Strake  
for  $\frac{1}{2}$  length  
 $\frac{8}{16}$  at ends

160507-0010

$\frac{4}{16}$

$\frac{4}{16}$

height of short  
reversed bars

$\frac{4}{16}$

$\frac{4}{16}$

$\frac{4}{16}$

Butt straps  
Sheer strake,  
Bilge, for  $\frac{1}{2}$  length  
than the plate

J.P.  
11/4/72



© 2021

Lloyd's Register  
Foundation