

3393

15/6

MIDSHIP SECTION
OF AN
IRON SCREW STEAMER


1/2 Girth 26-25
1/2 Breadth 13-57
Depth 16-50
Length 56, 12 Number
10580 Number
+ 1/10 1058
10646 Number

DIMENSIONS
Length OA 198-0
D^o BP 190-0
Breadth 26-9
Depth in Hold 15-5
D^o moulded 16-3
to class 90 A

Rec 21/1/93
H

1 Washboard Bulkheads
Bulkhead Plates 5/16
D^o Bars 1/2 x 3/16
D^o D^o 1/6 apart
Foucastle Stringers 1/6
D^o Sills 6 inches
Bulder at Head 4 3/4
D^o at Keel 2 1/4
Stem 11 x 2 1/4
Iron Frame 9 x 3 1/4
Length of Rigging Room 35-0
D^o Quarter Deck 60-0
D^o Fore Ballast Tank 7/16
D^o After D^o D^o 49-5
ANCHORS & CHAINS
2 Bows 15 1/2 Cwt each including 1/2 of
1 D^o 11 1/2
1 Steam 3 1/2
140 Sills 1/4 Chain Cable
90 No Steam Chain
90 1/2 inch Hemp Rope
90 1/4

Under 12 depths in length
8 Breadth

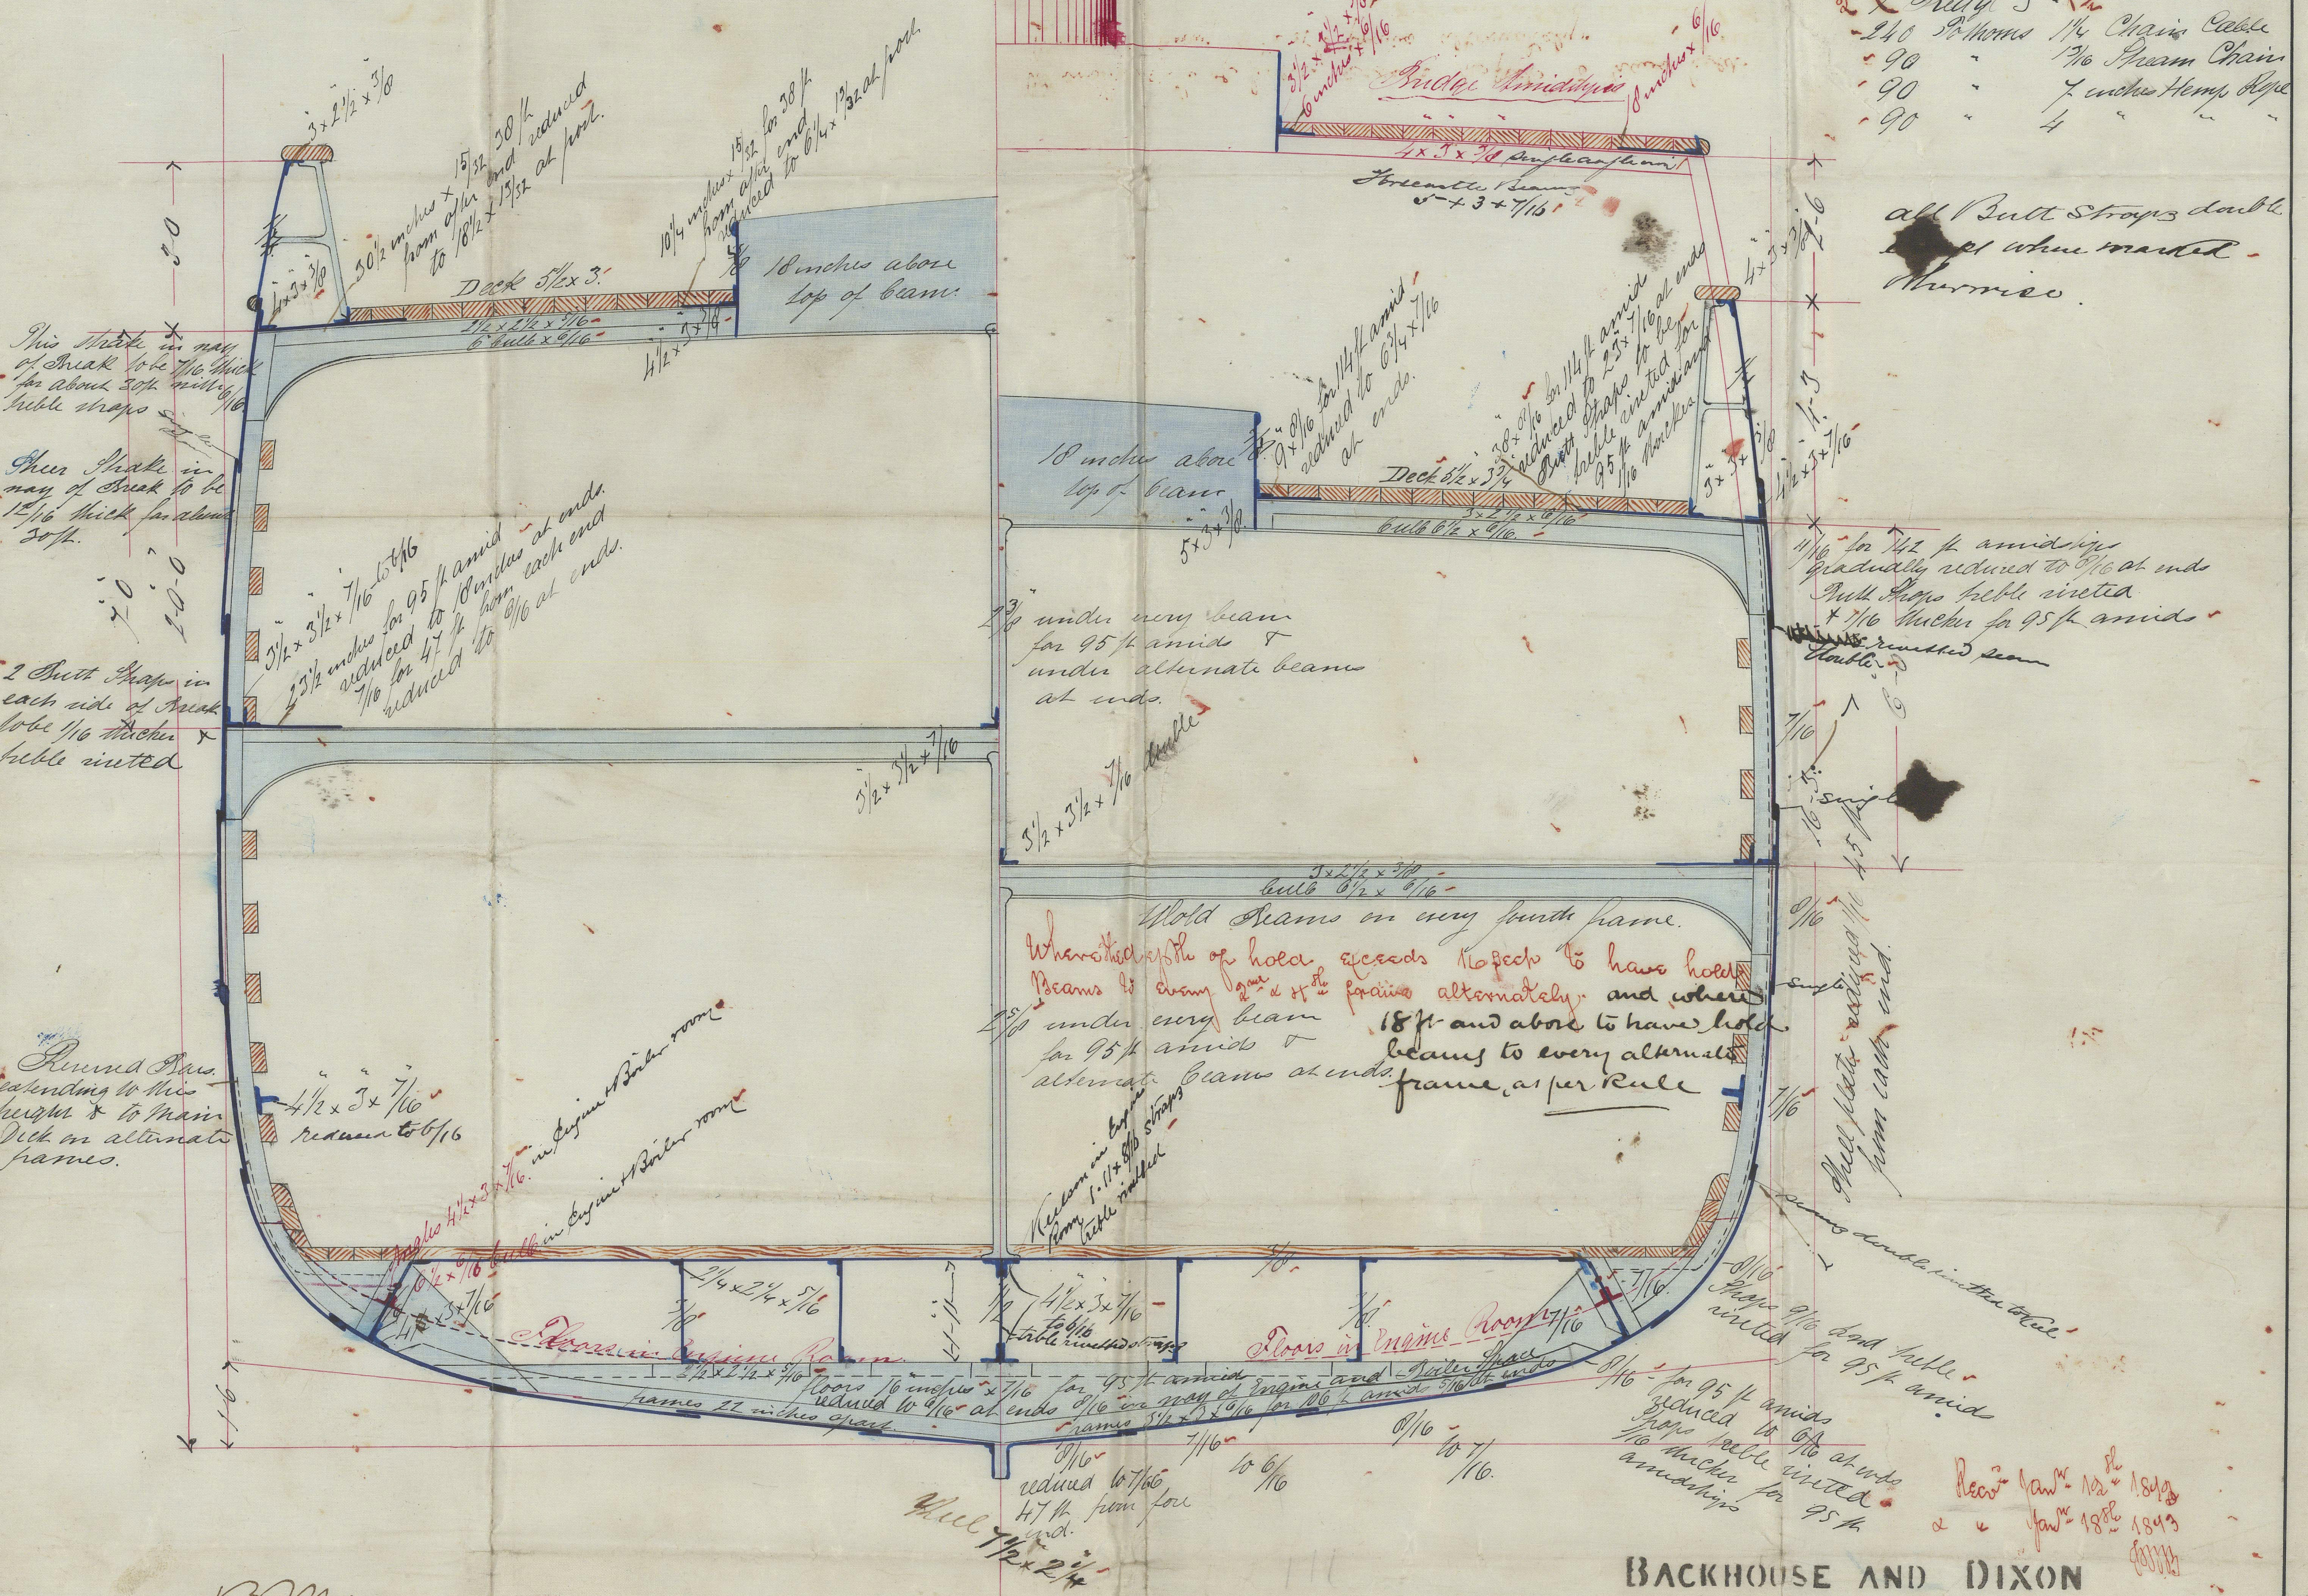

Bm
23/1/93

SCALE 1/2 AN INCH = 1 FOOT

BACKHOUSE AND DIXON

IRON SHIP BUILDERS

MIDDLESBROUGH-ON-TEES

January 1903

As to Surveyors Master of the ship
23/1/93