


8^{ins} Side Light
(Vessel fitted with fins)
full size

Sketch showing side-light
as fitted below Main Deck
in S.S. "State of Virginia"

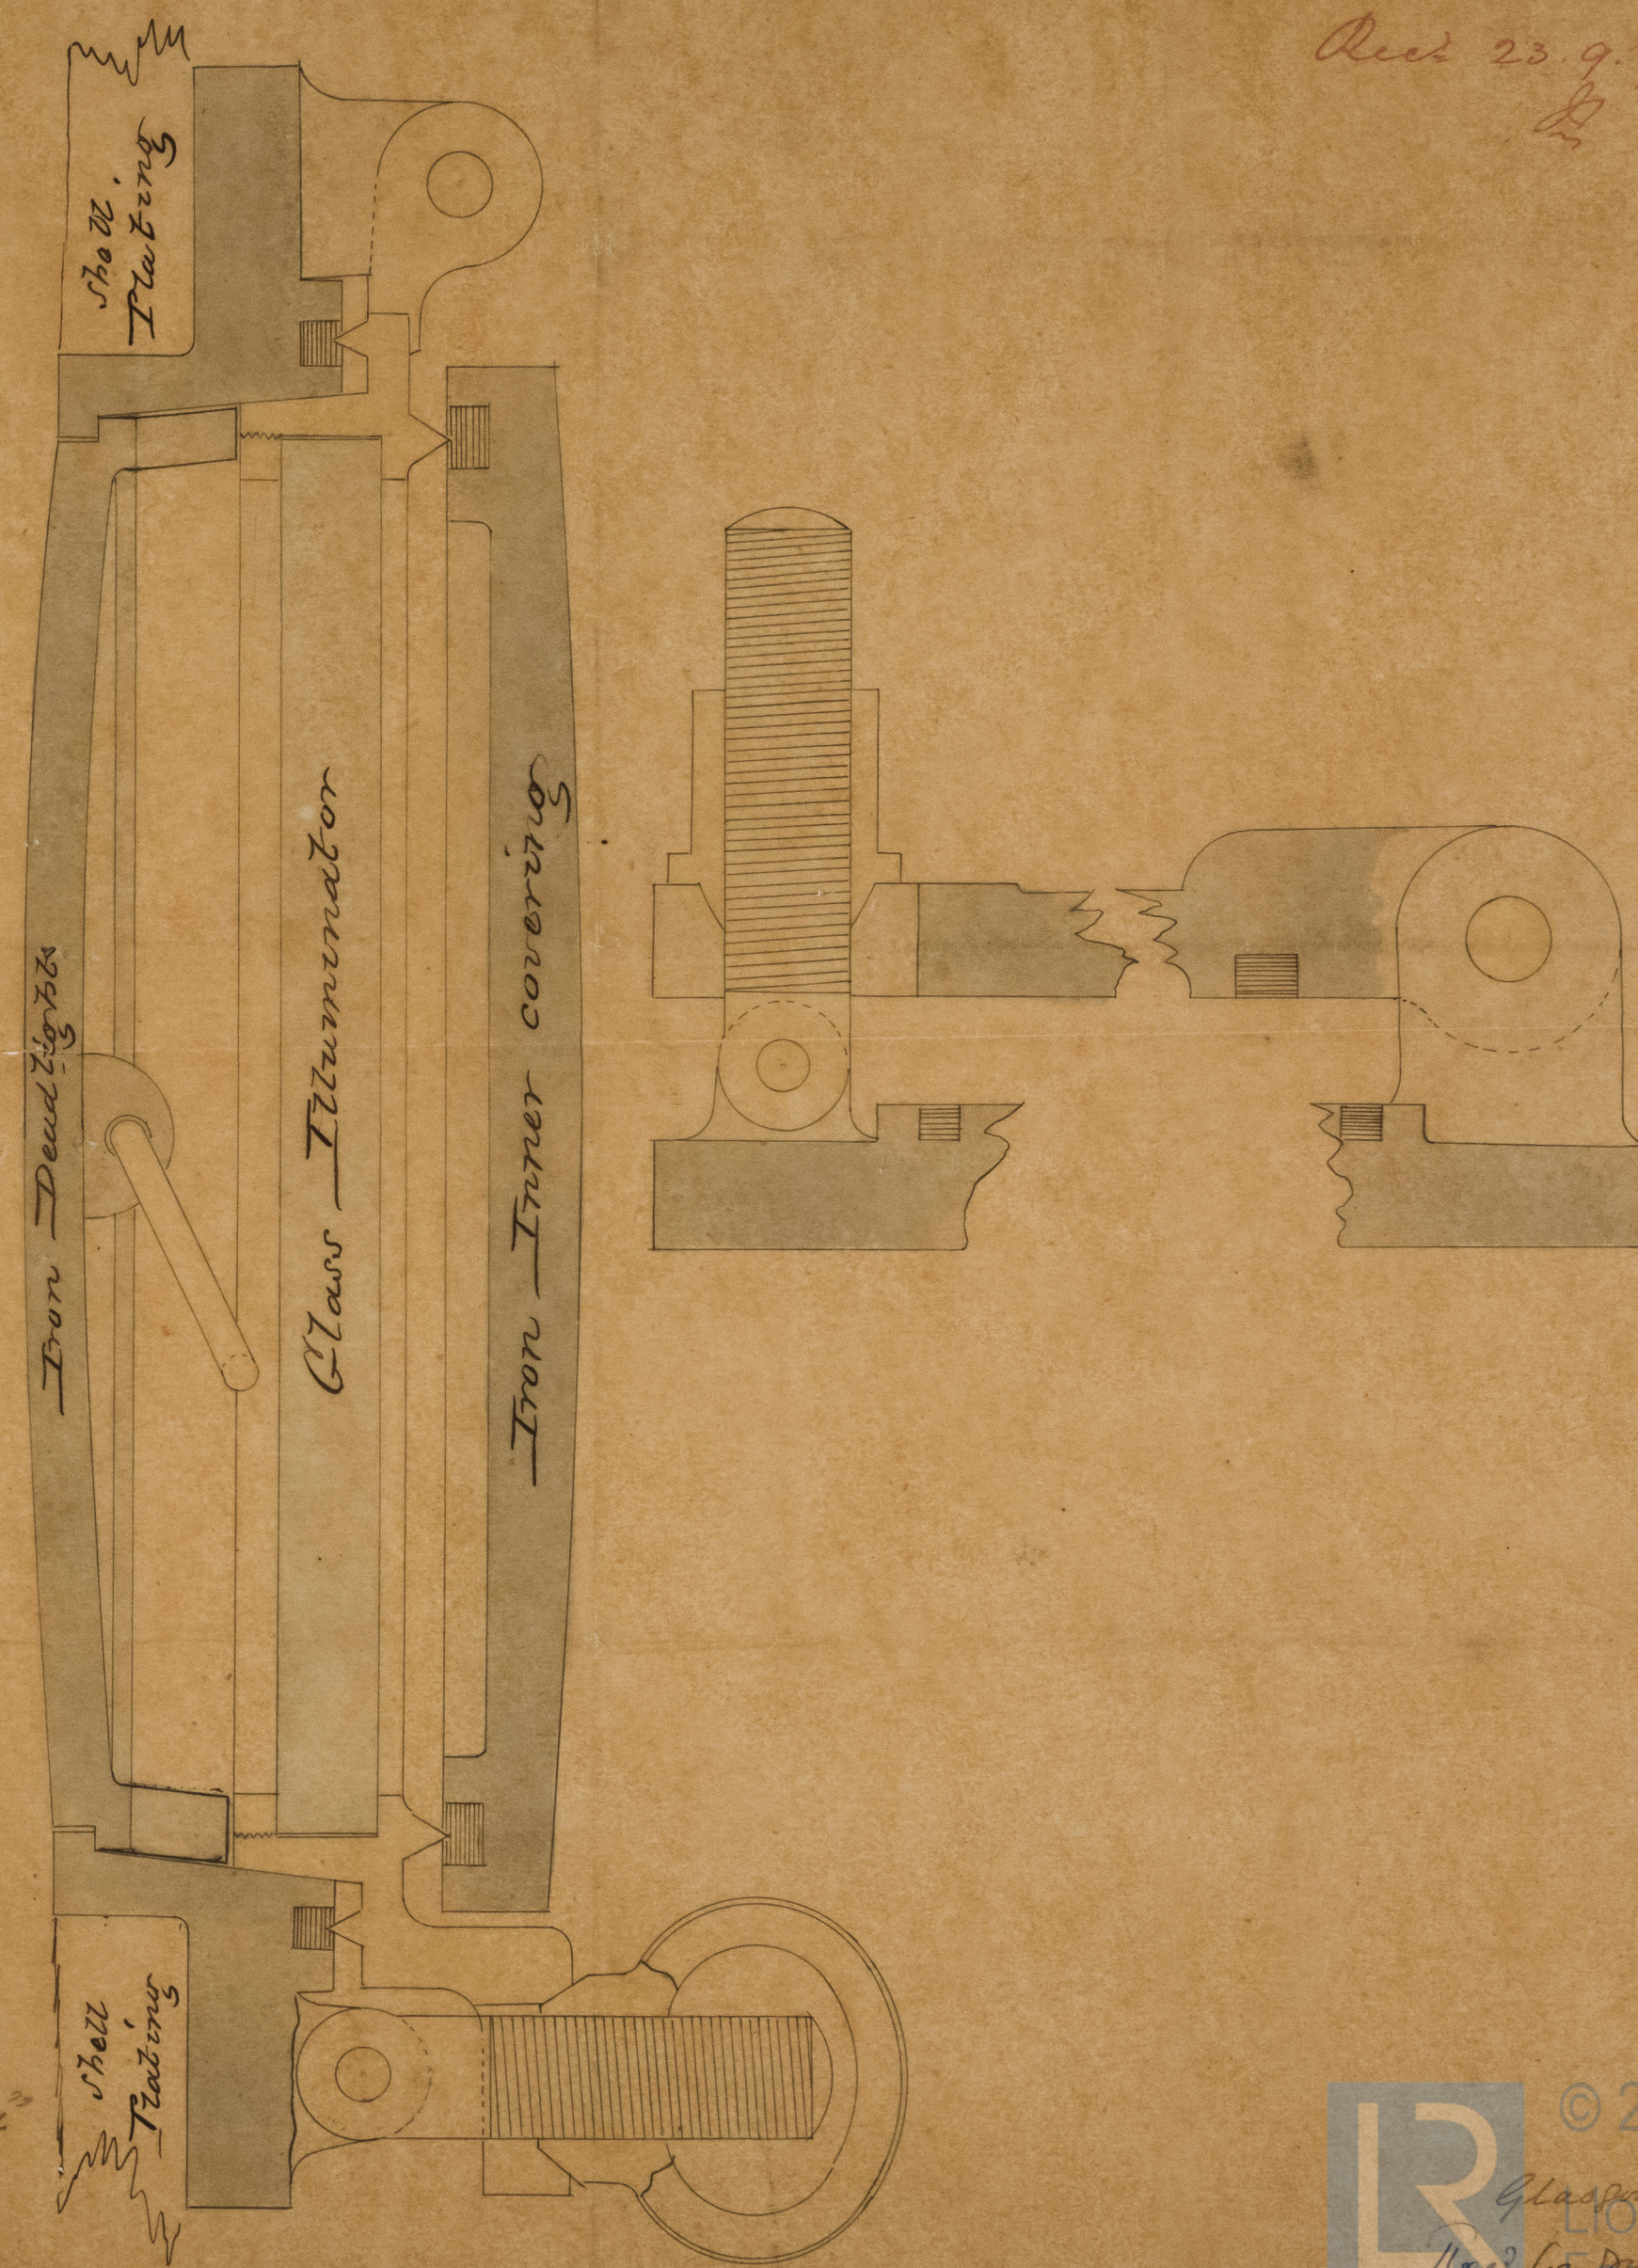

Recd 23.9.73
JH