


Dimensions for lengthening (in new part)
and extended doubling.

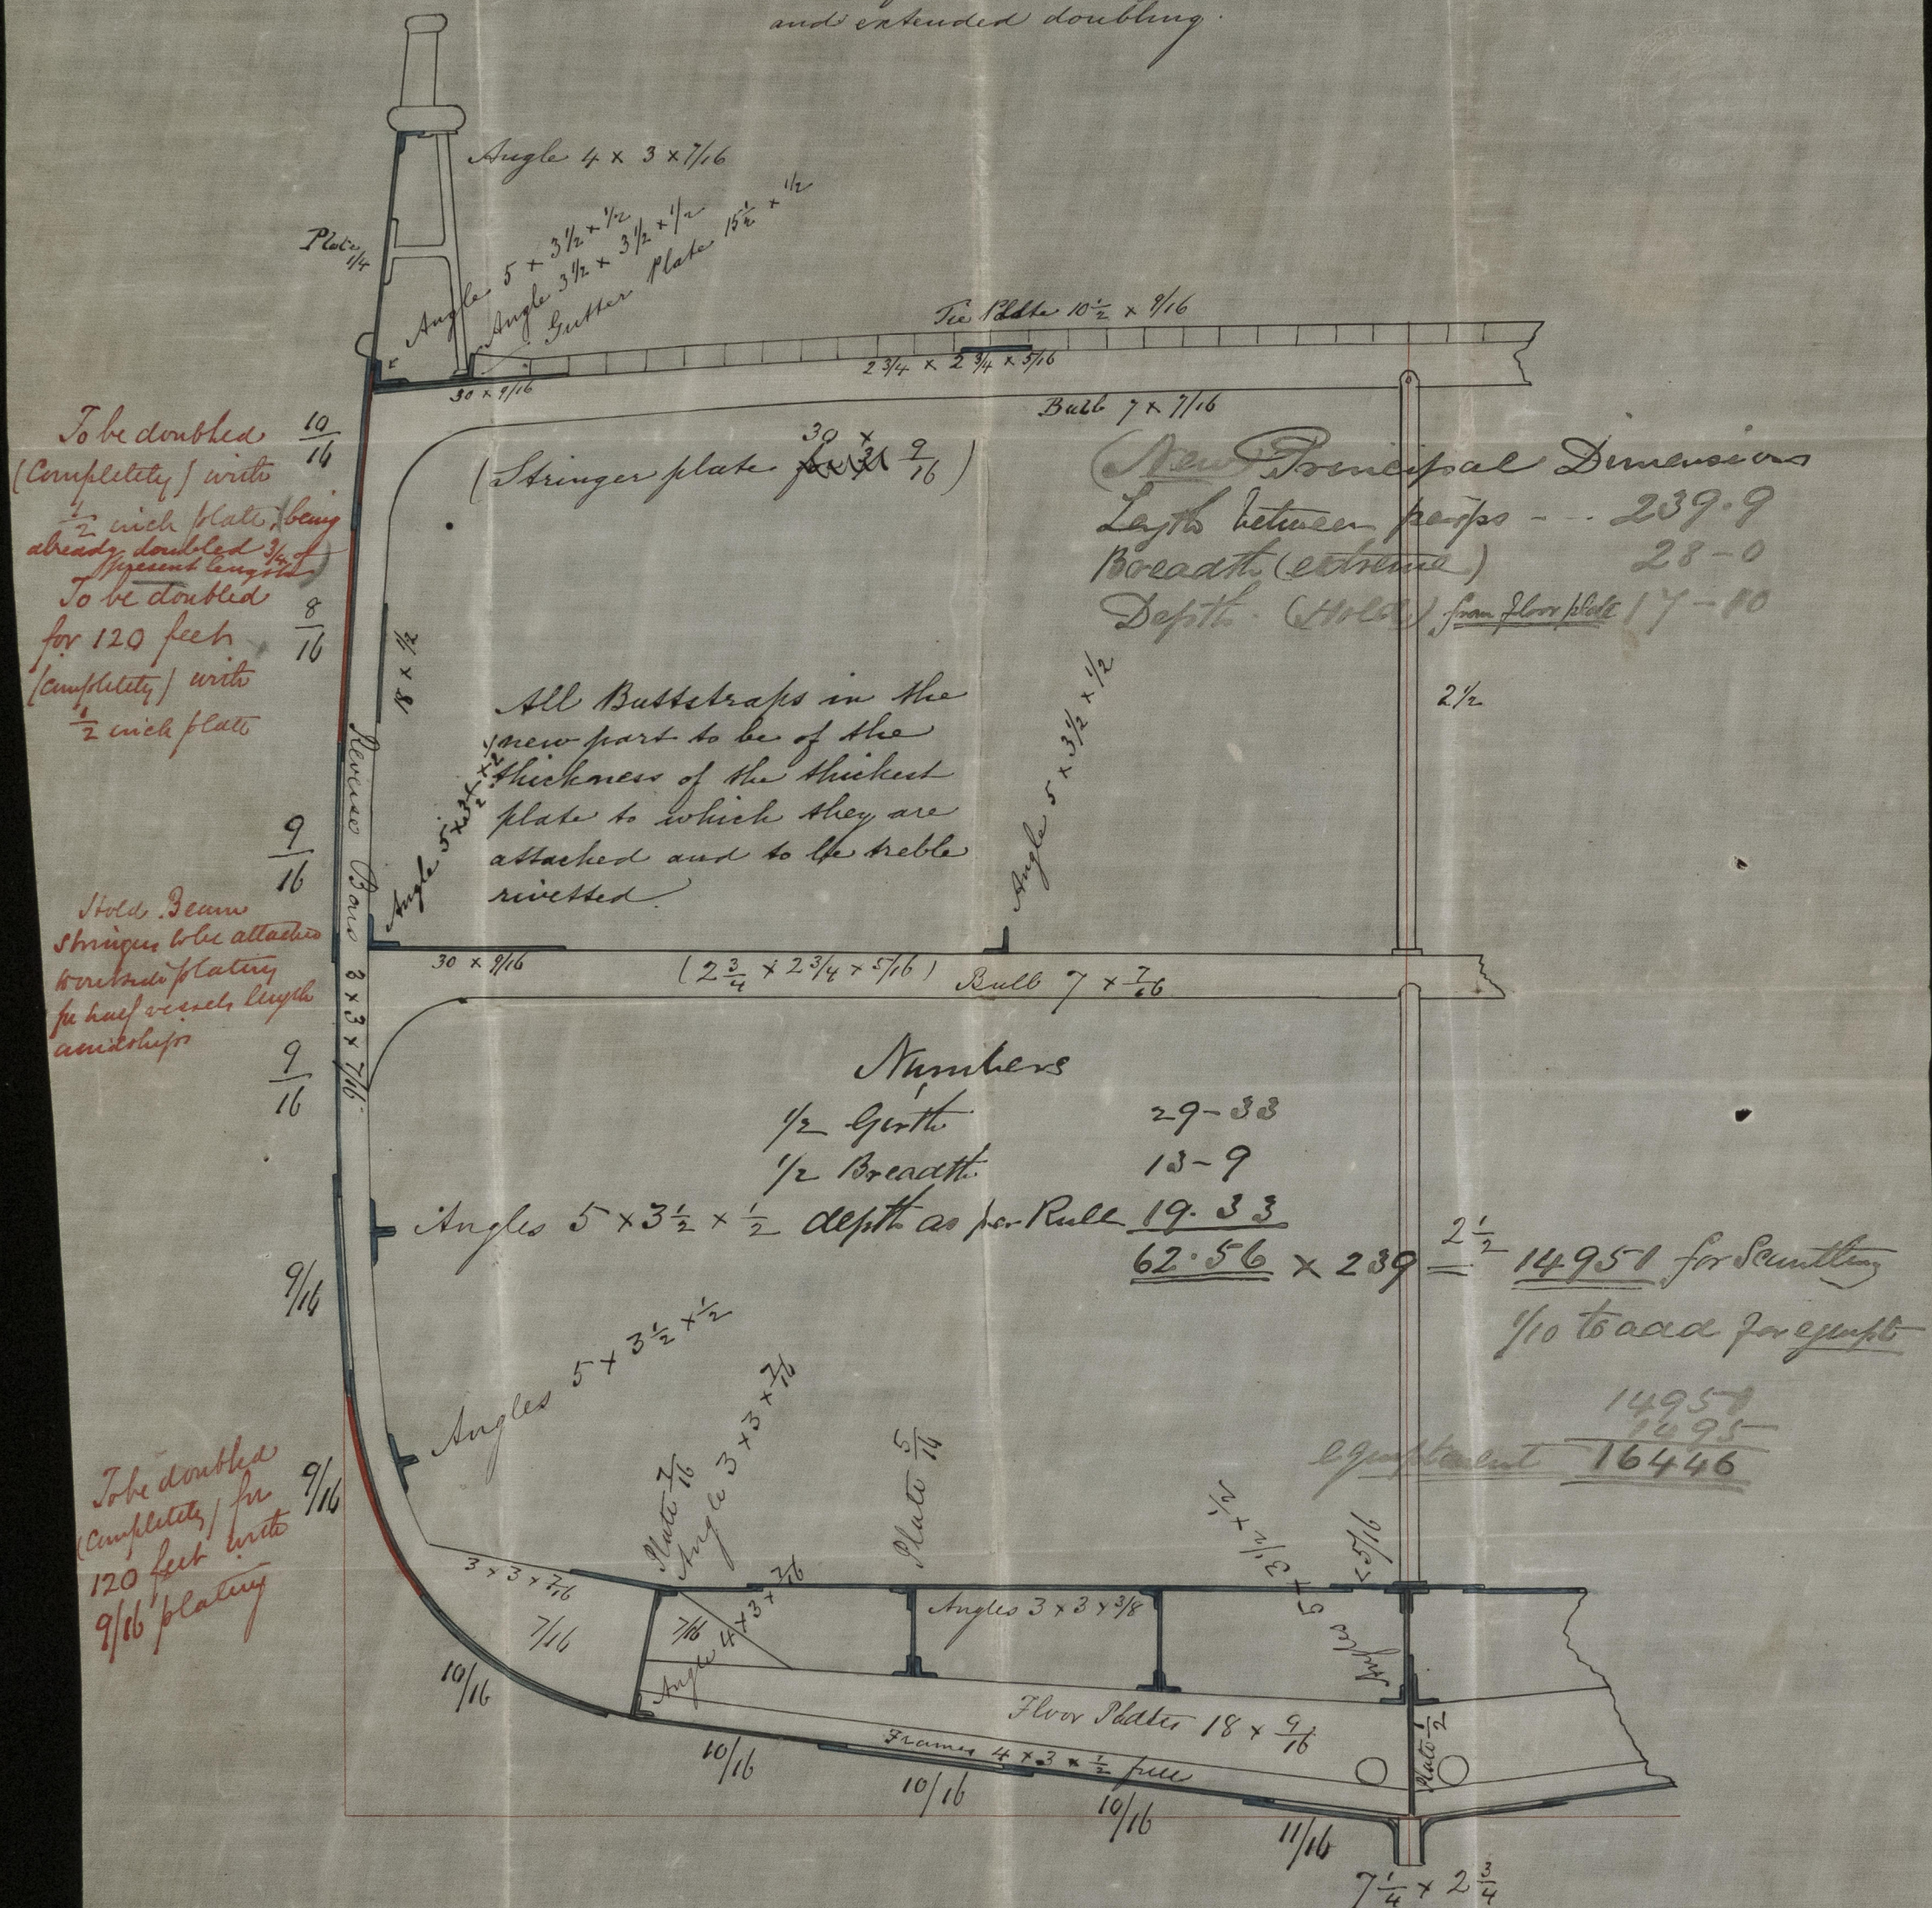

7/2/73