



S. J. Davis
Report No. 3200

Midship Section of No. 33 S.V.

Messrs. Turnbull & Son, Whitby, Dec. 14th 1872

Scale 1/2 in. = 1 ft

Recd 18/12/72

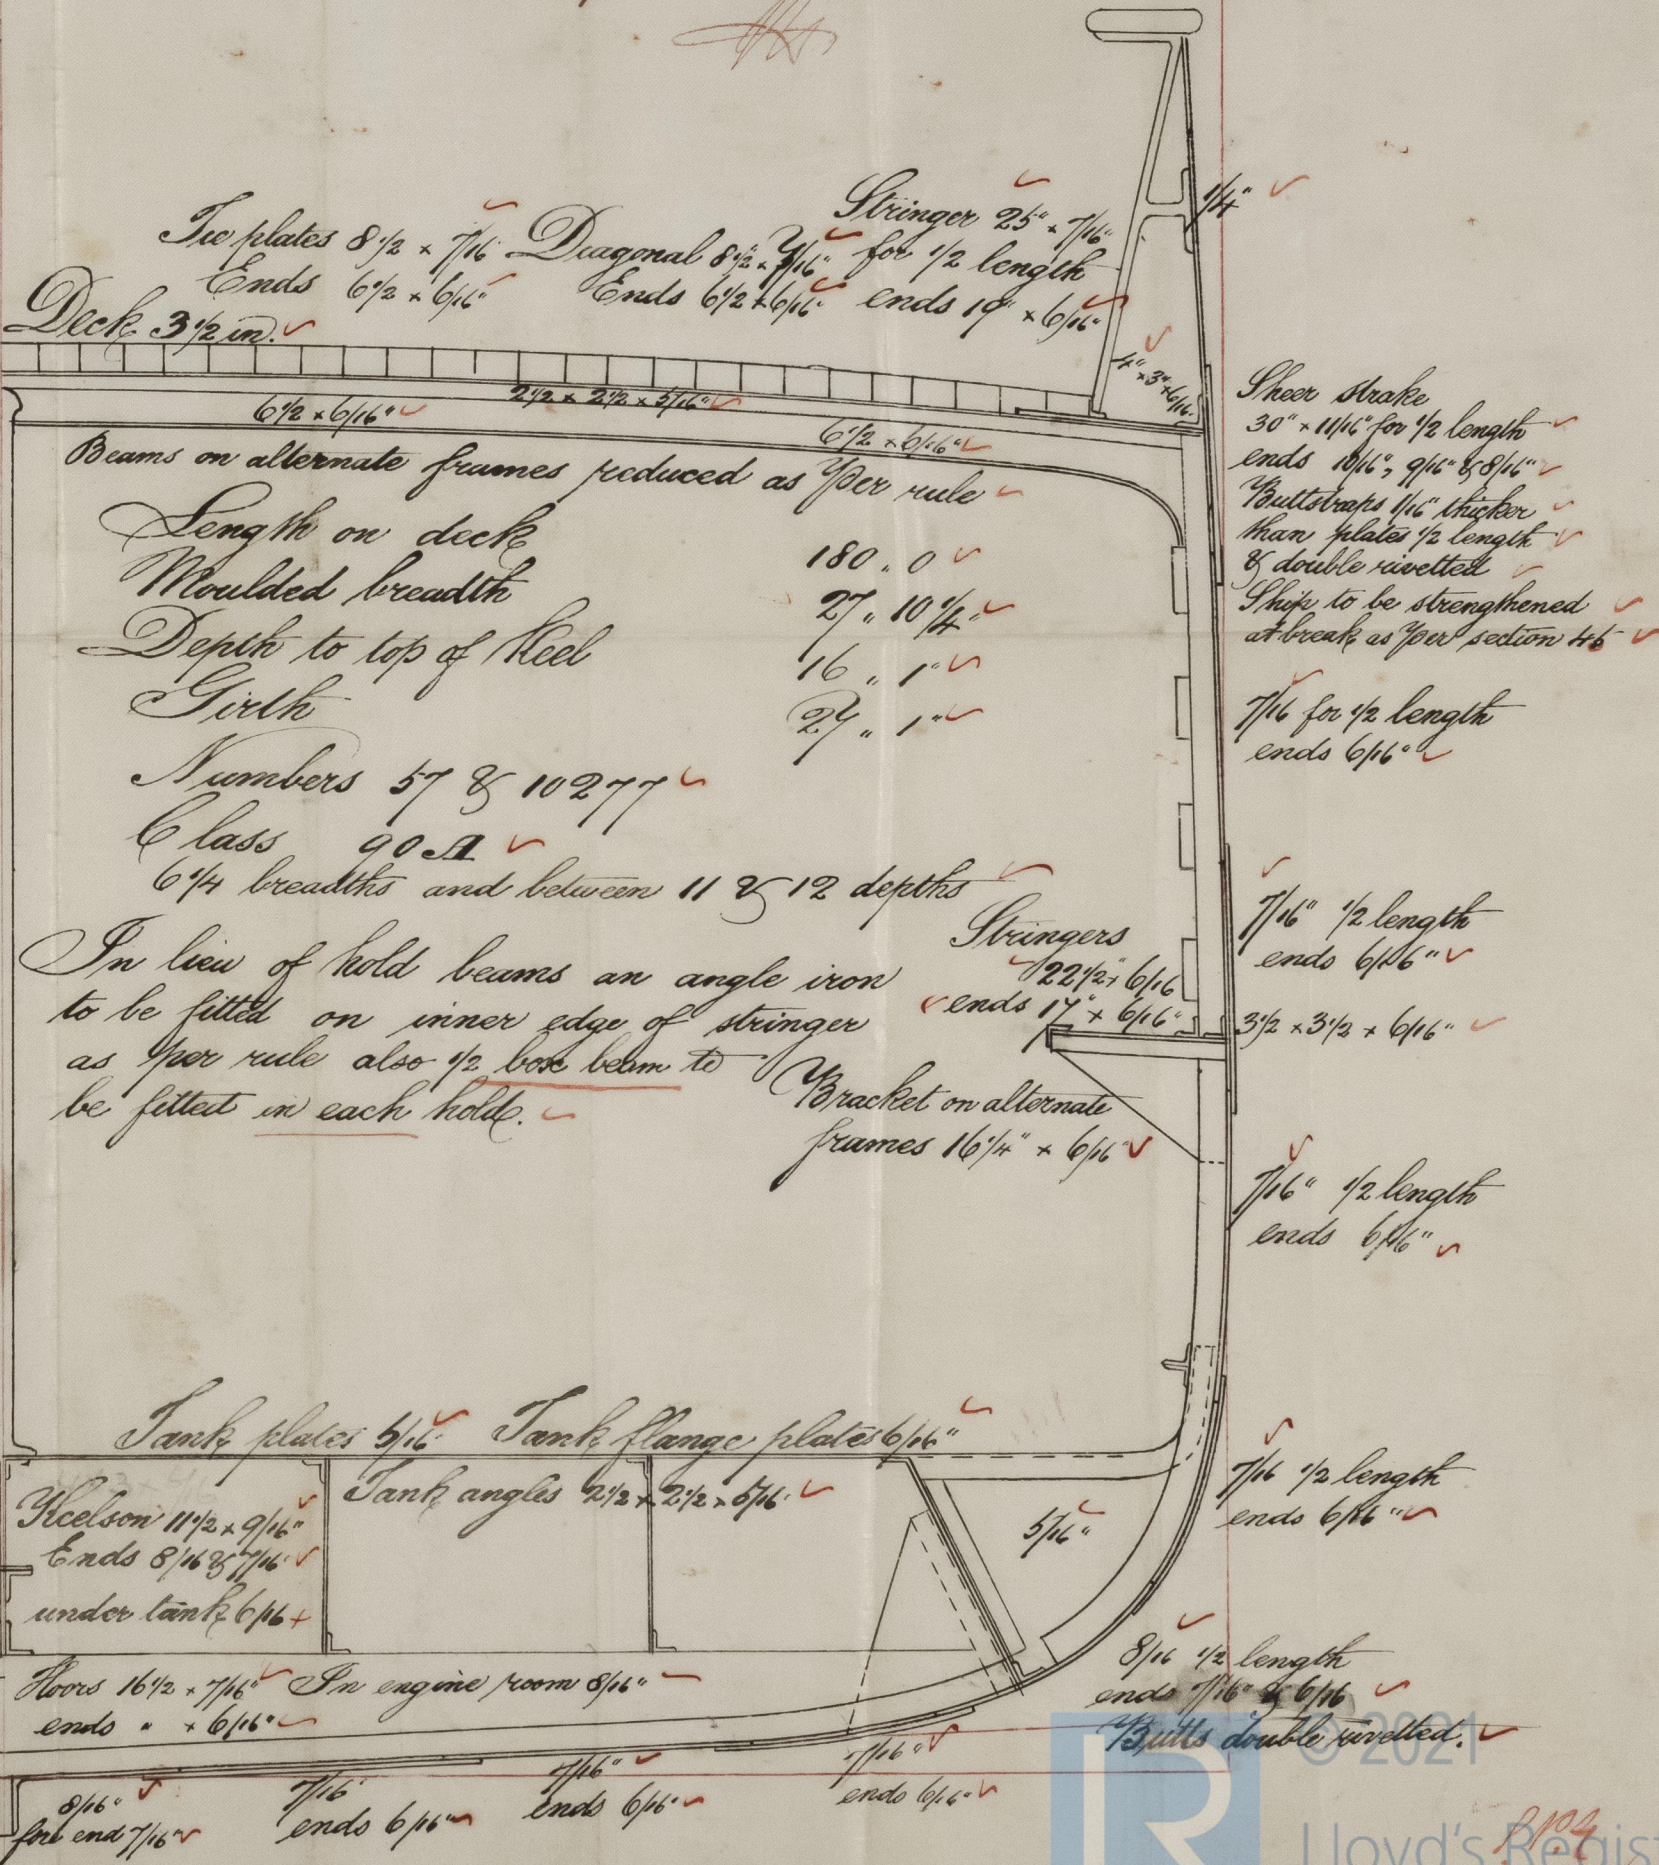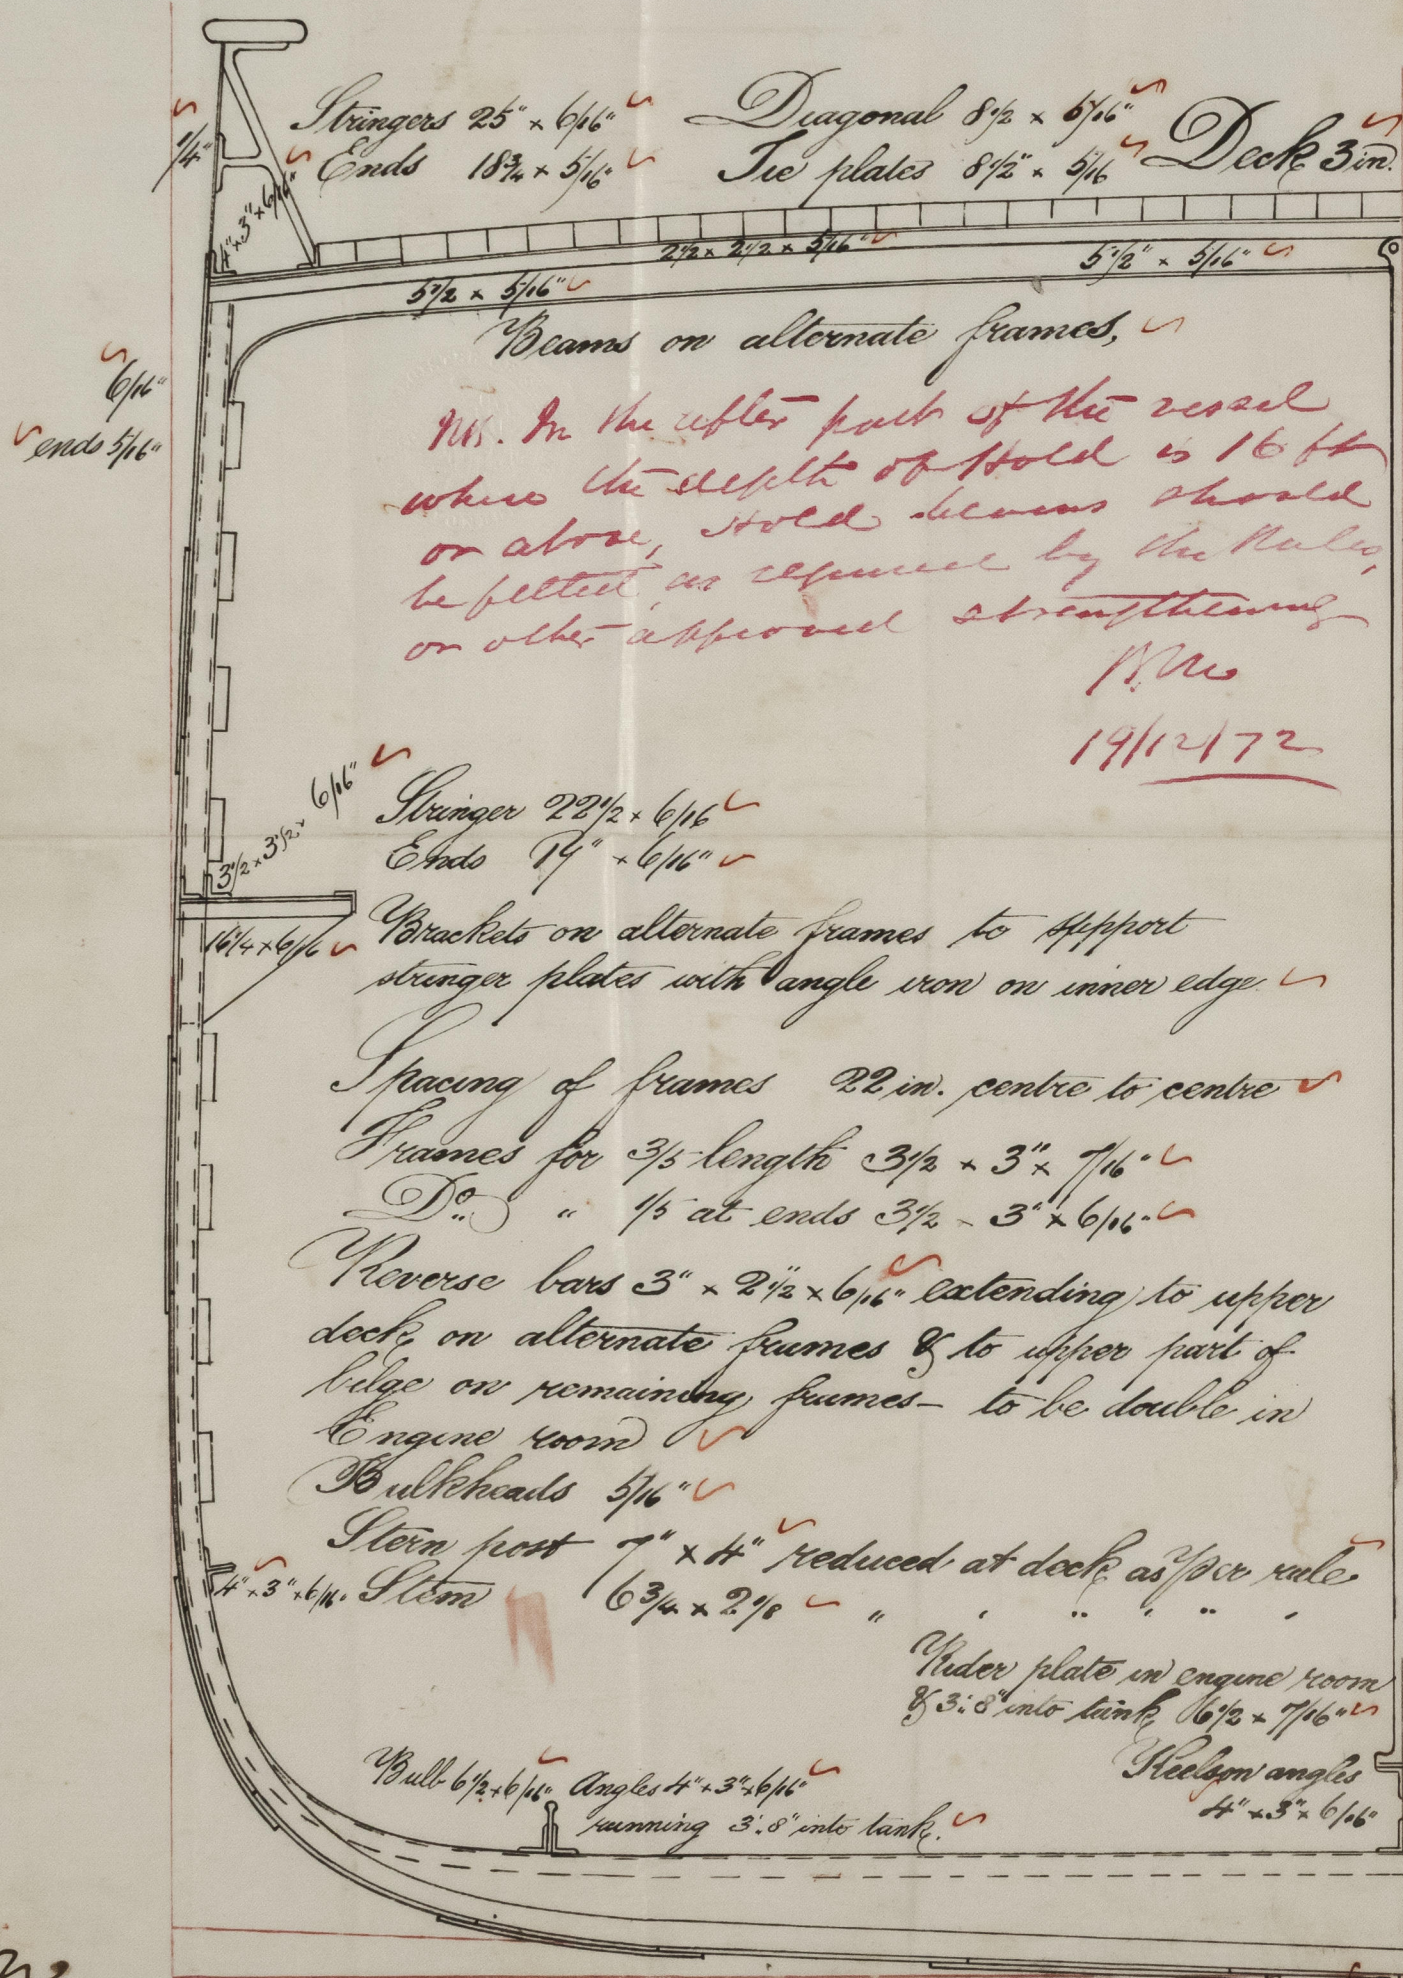

19/12/72
19/12/72