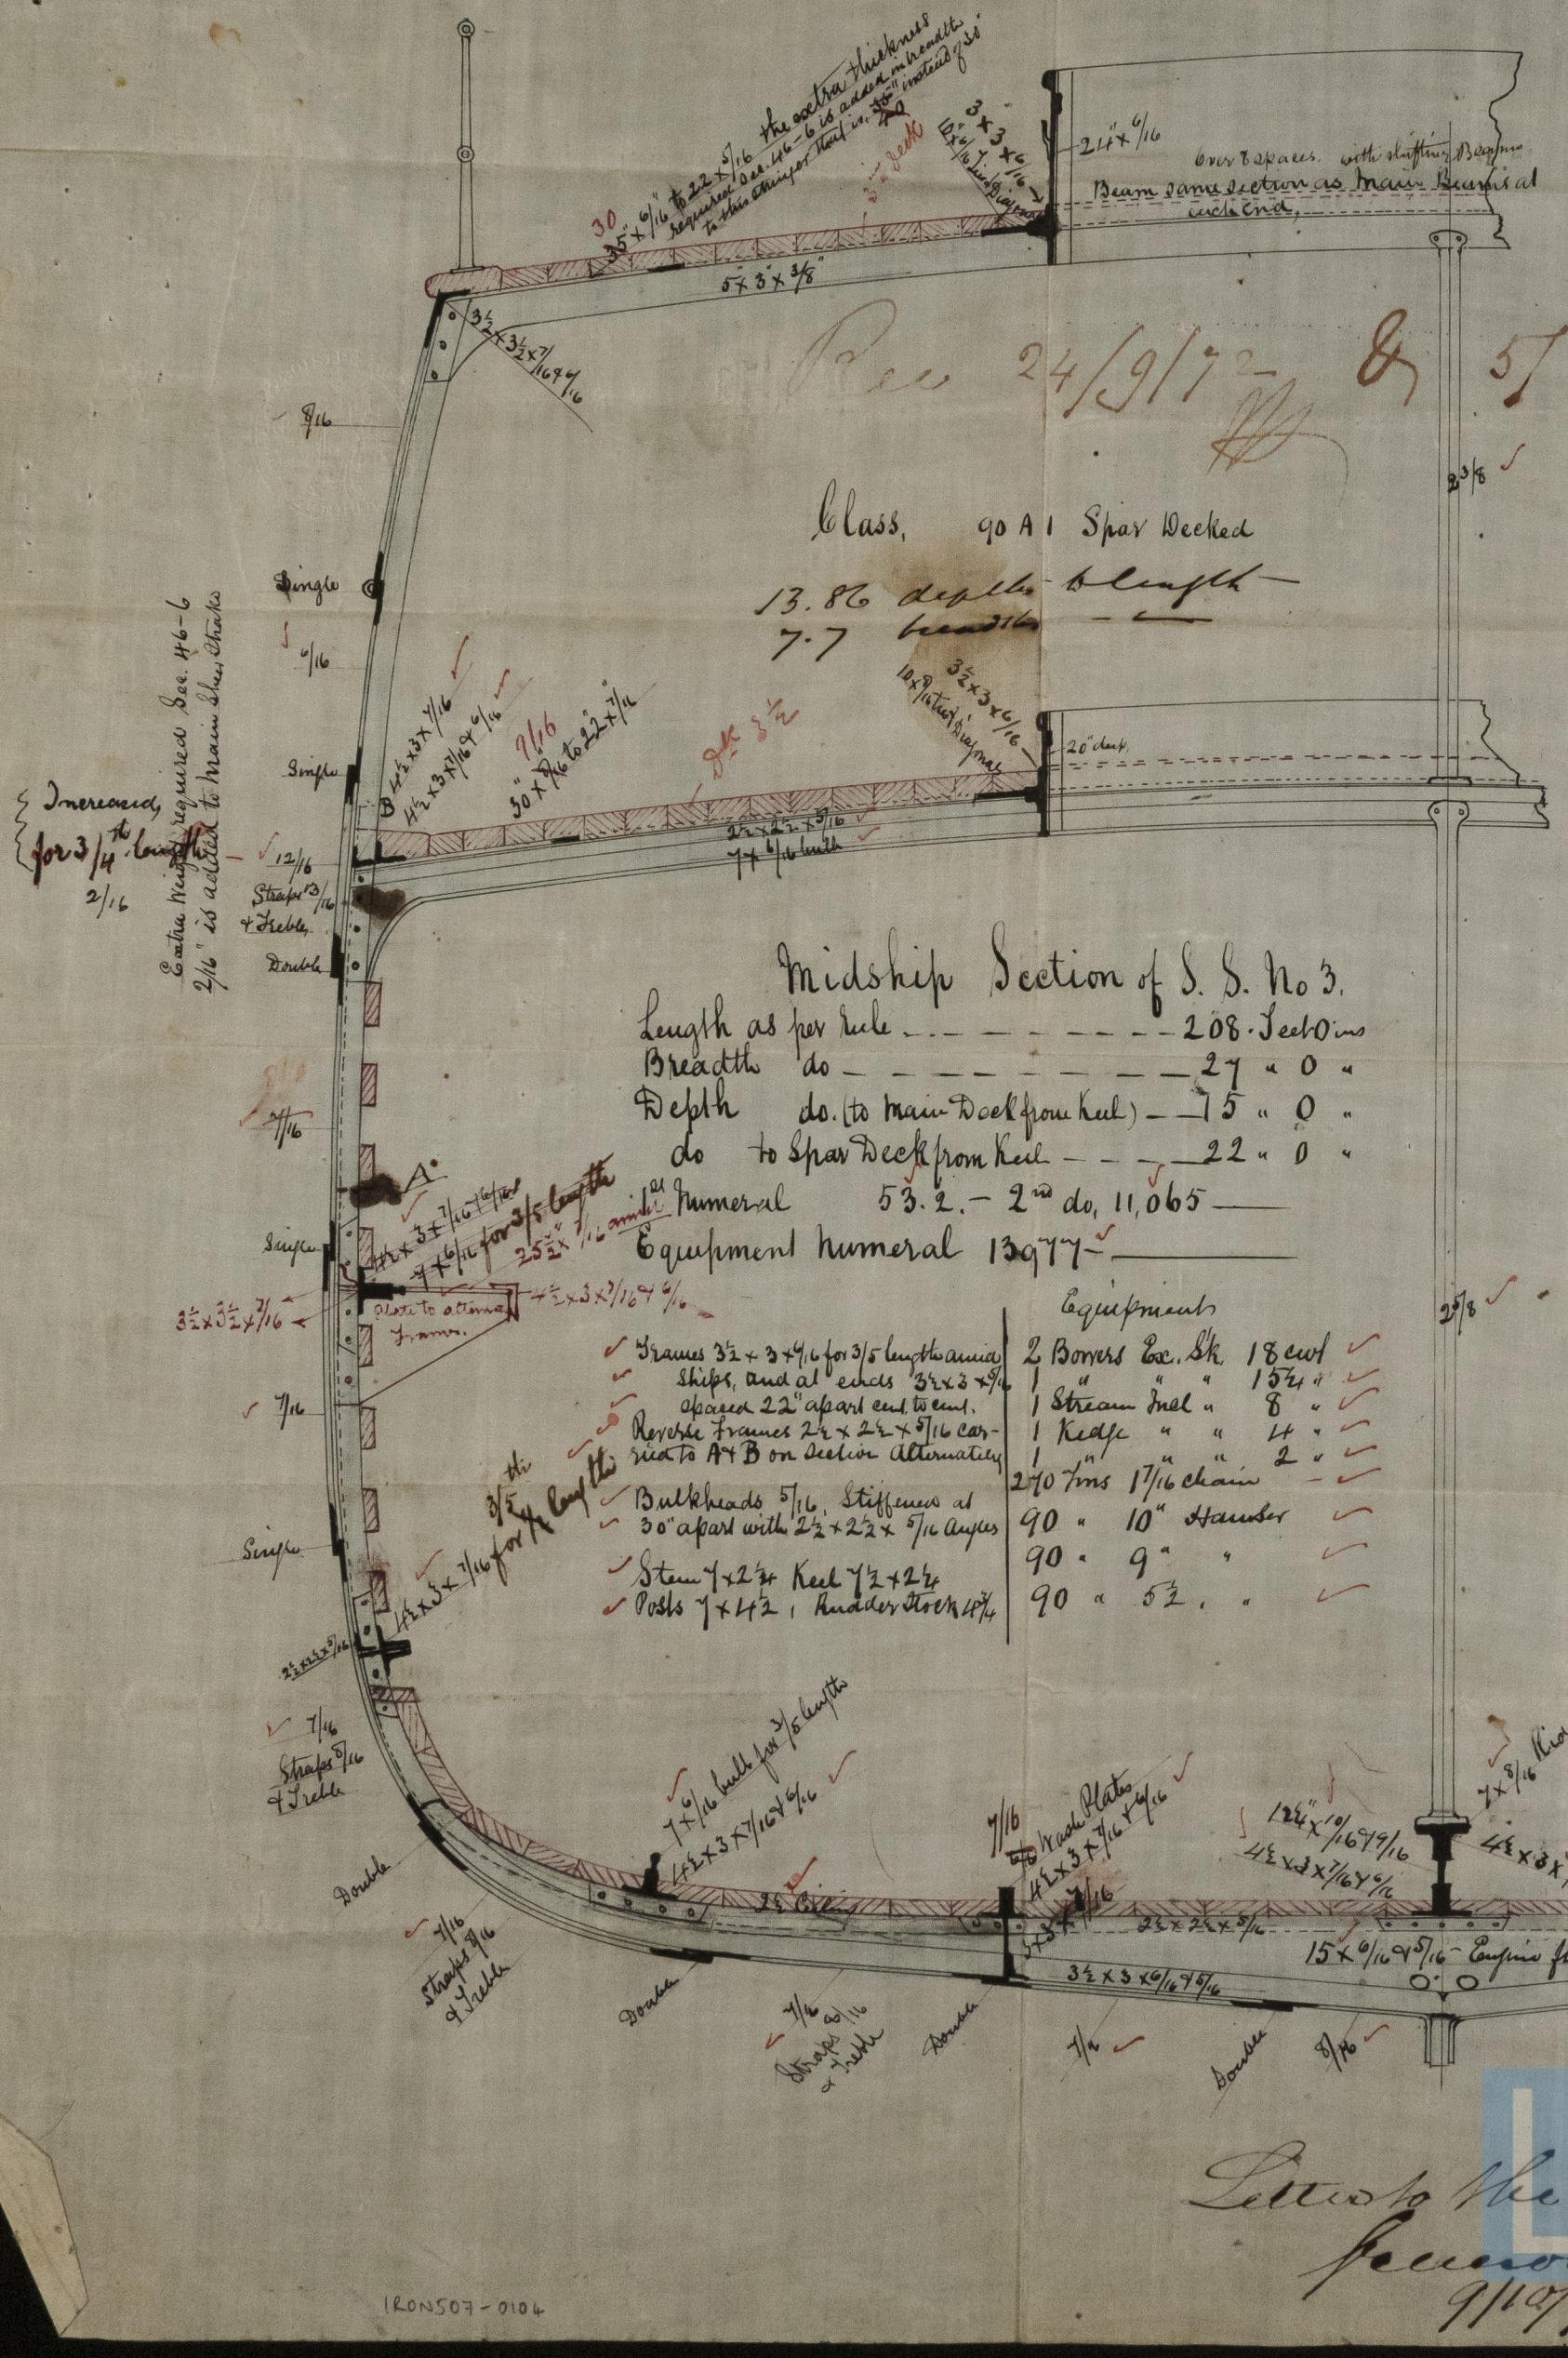

Rec 24/9/72 & 5/10/72

Class, 90 A 1 Spar Decked

13.86 depth — length —
7.7 beam —

Midship Section of S. S. No 3.

Length as per Rule ---------- 208. Feet 0 ins
Breadth do ---------- 27 " 0 "
Depth do. (to main Deck from Keel) -- 15 " 0 "
do to Spar Deck from Keel ---- 22 " 0 "
1st Numeral 53.2. — 2nd do, 11,065 ____
Equipment Numeral 1397 ____

Frames 3½ x 3 x 9/16 for 3/5 length amid Ships, and at ends 3½ x 3 x 9/16 spaced 22" apart centre to centre.
Reverse Frames 2½ x 2½ x 5/16 carried to A & B on Section alternately
Bulkheads 5/16, Stiffeners at 30" apart with 2½ x 2½ x 5/16 Angles
Stem 7 x 2¾ Keel 7½ x 2¼
Posts 7 x 4½, Rudder Stock 4¾

Equipment		
2	Bowers Exc. Sk.	18 cwt
1	" " "	15¼ "
1	Stream Anel "	8 "
1	Kedge " "	4 "
1	" " "	2 "
270	Fms 1 7/16 chain	—
90	" 10" Hawser	
90	" 9" "	
90	" 5½ "	

Draft approved Portsmouth 17/9/72

Letter to the Surveyors
Received
9/10/72

© 2021 Lloyd's Register Foundation

IRON507-0104