

• Iron 11729


# MIDSHIP SECTION

S SN: 114

S.S. "Vindomora"

Report No. 10650

SCALE  $\frac{1}{2}$  = ONE FOOT

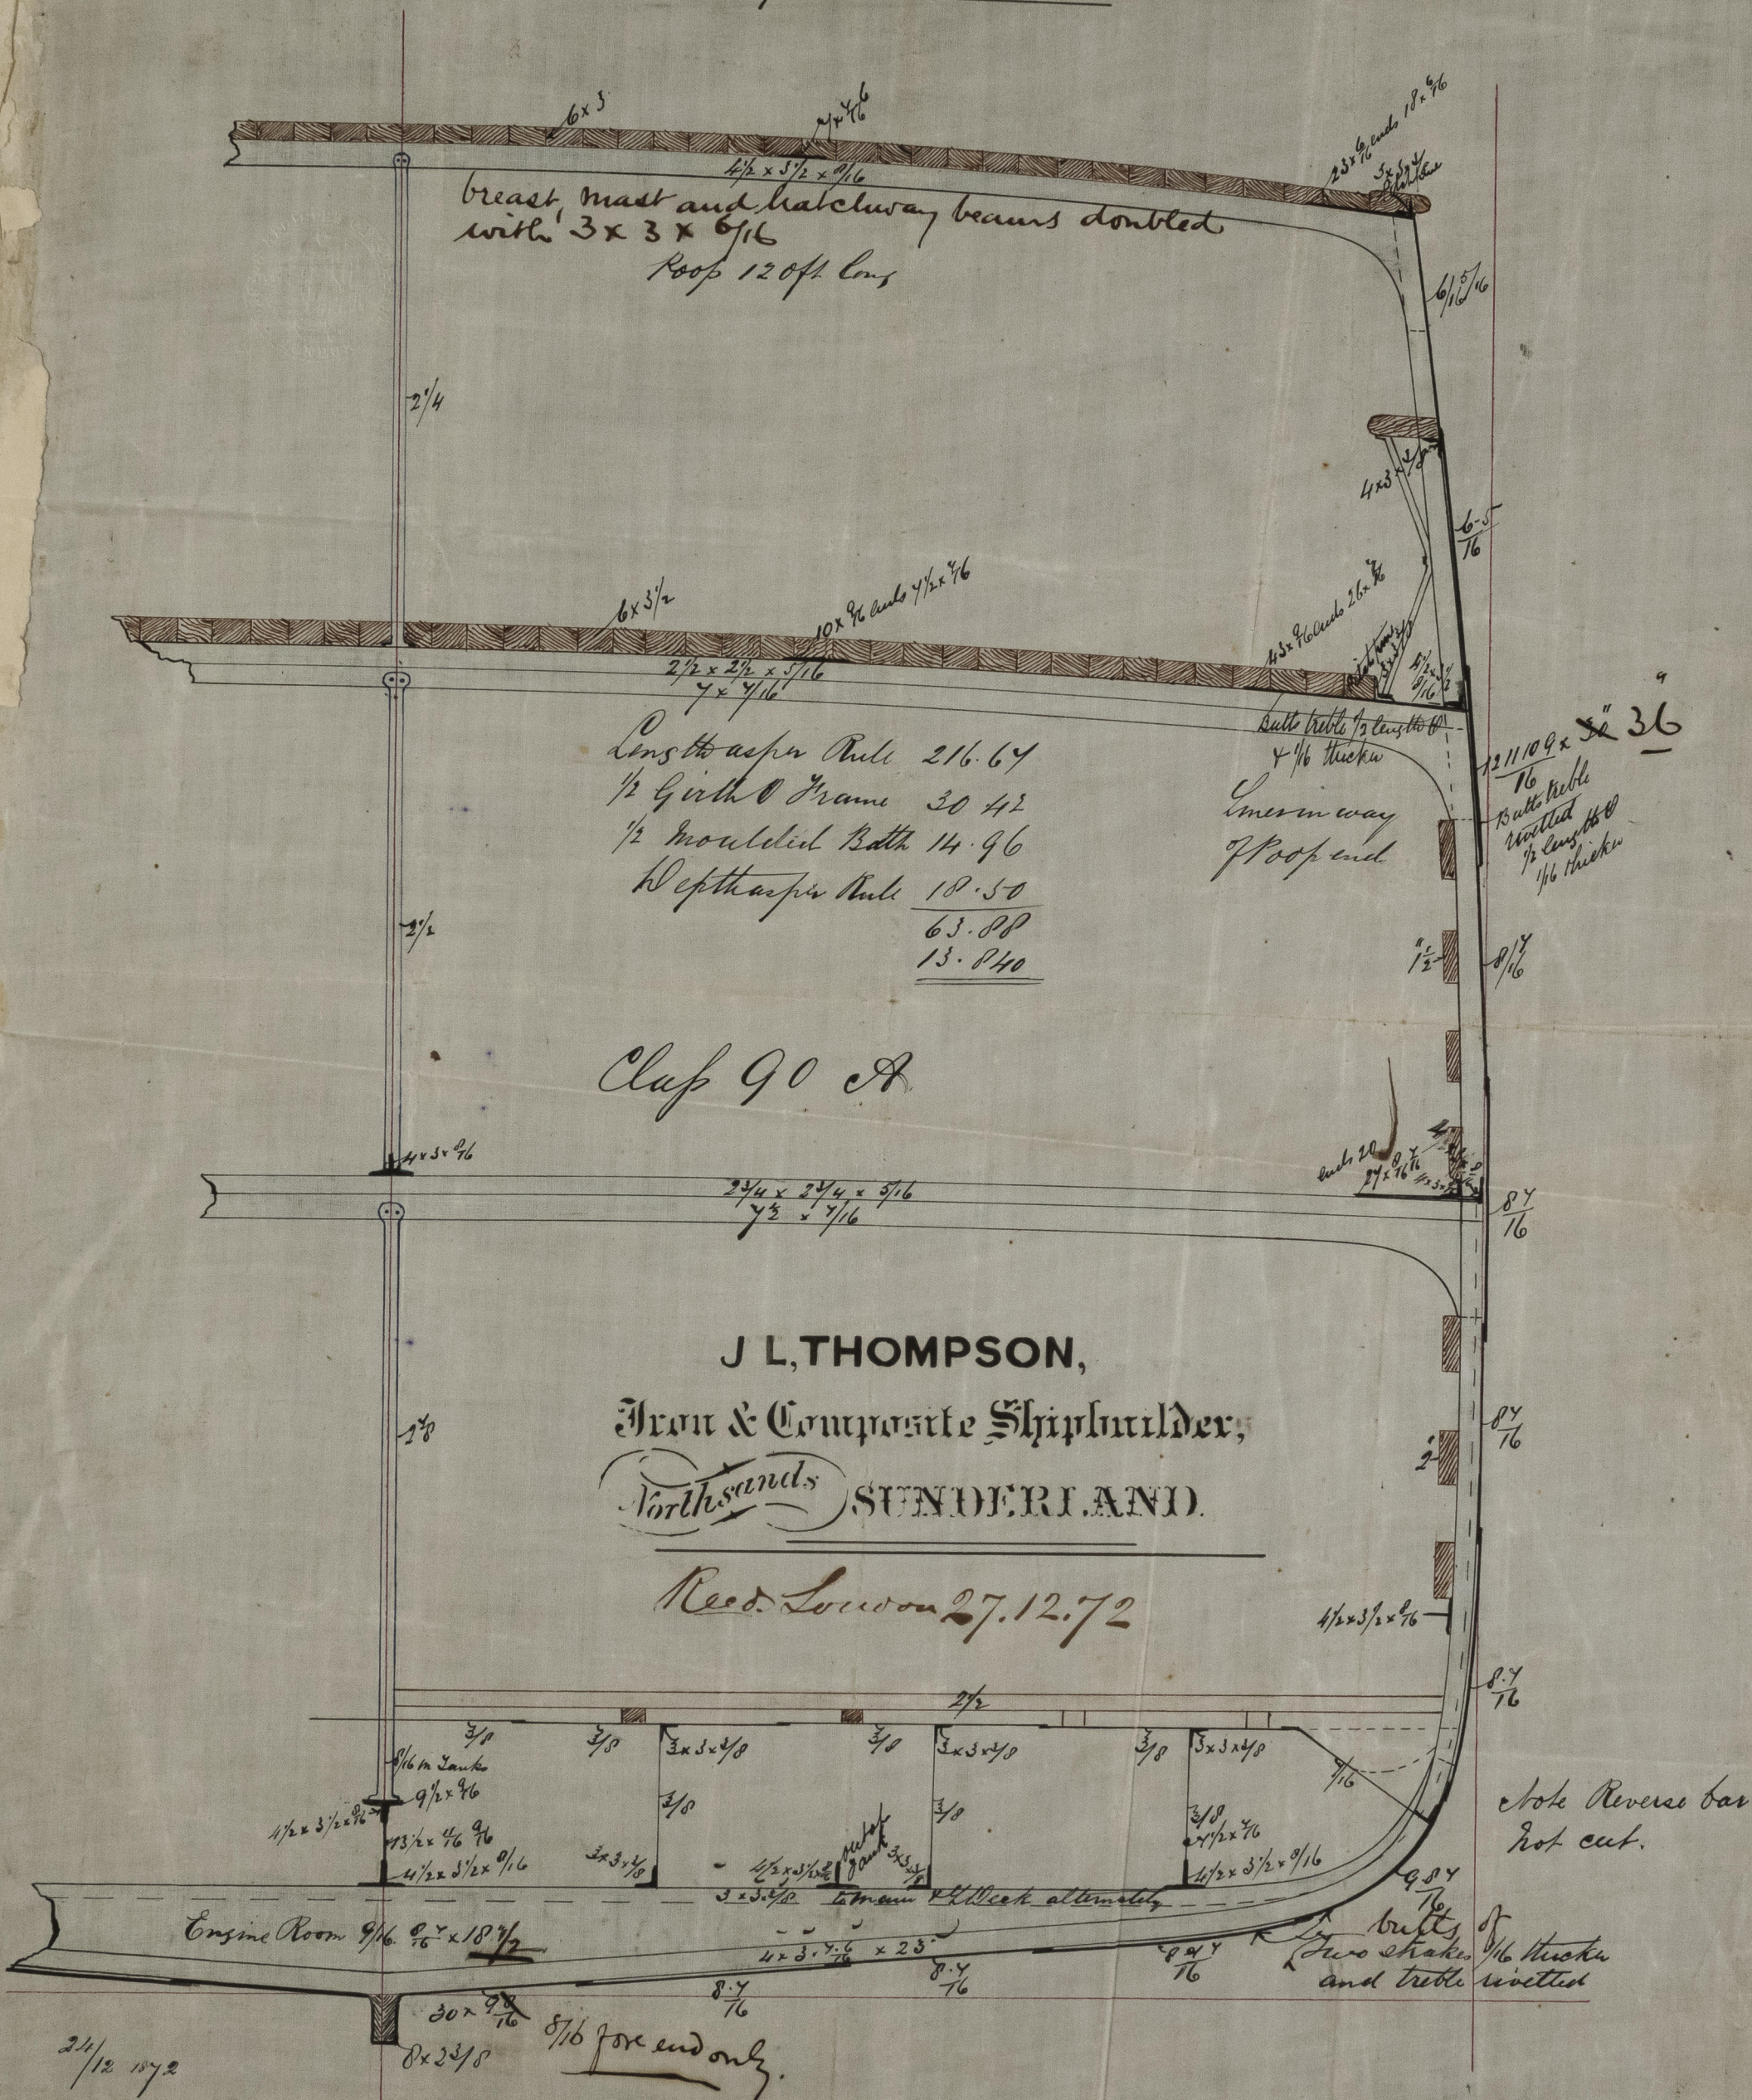

24/12 1872  
B.M.  
30/2/72

Propeller Post 8x11  
Rudder 8x33/4  
" HEAD 5 1/4  
" HEEL 3  
" PONTLES 23/4



© 2021  
Rules 1872  
Lloyd's Register  
Foundation

180507-0147