



Rev 2/5/73
H

THOS. HINGATE & CO.
ENGINEERS, FOUNDERS
& IRON SHIPBUILDERS
GLASGOW 16/4/73

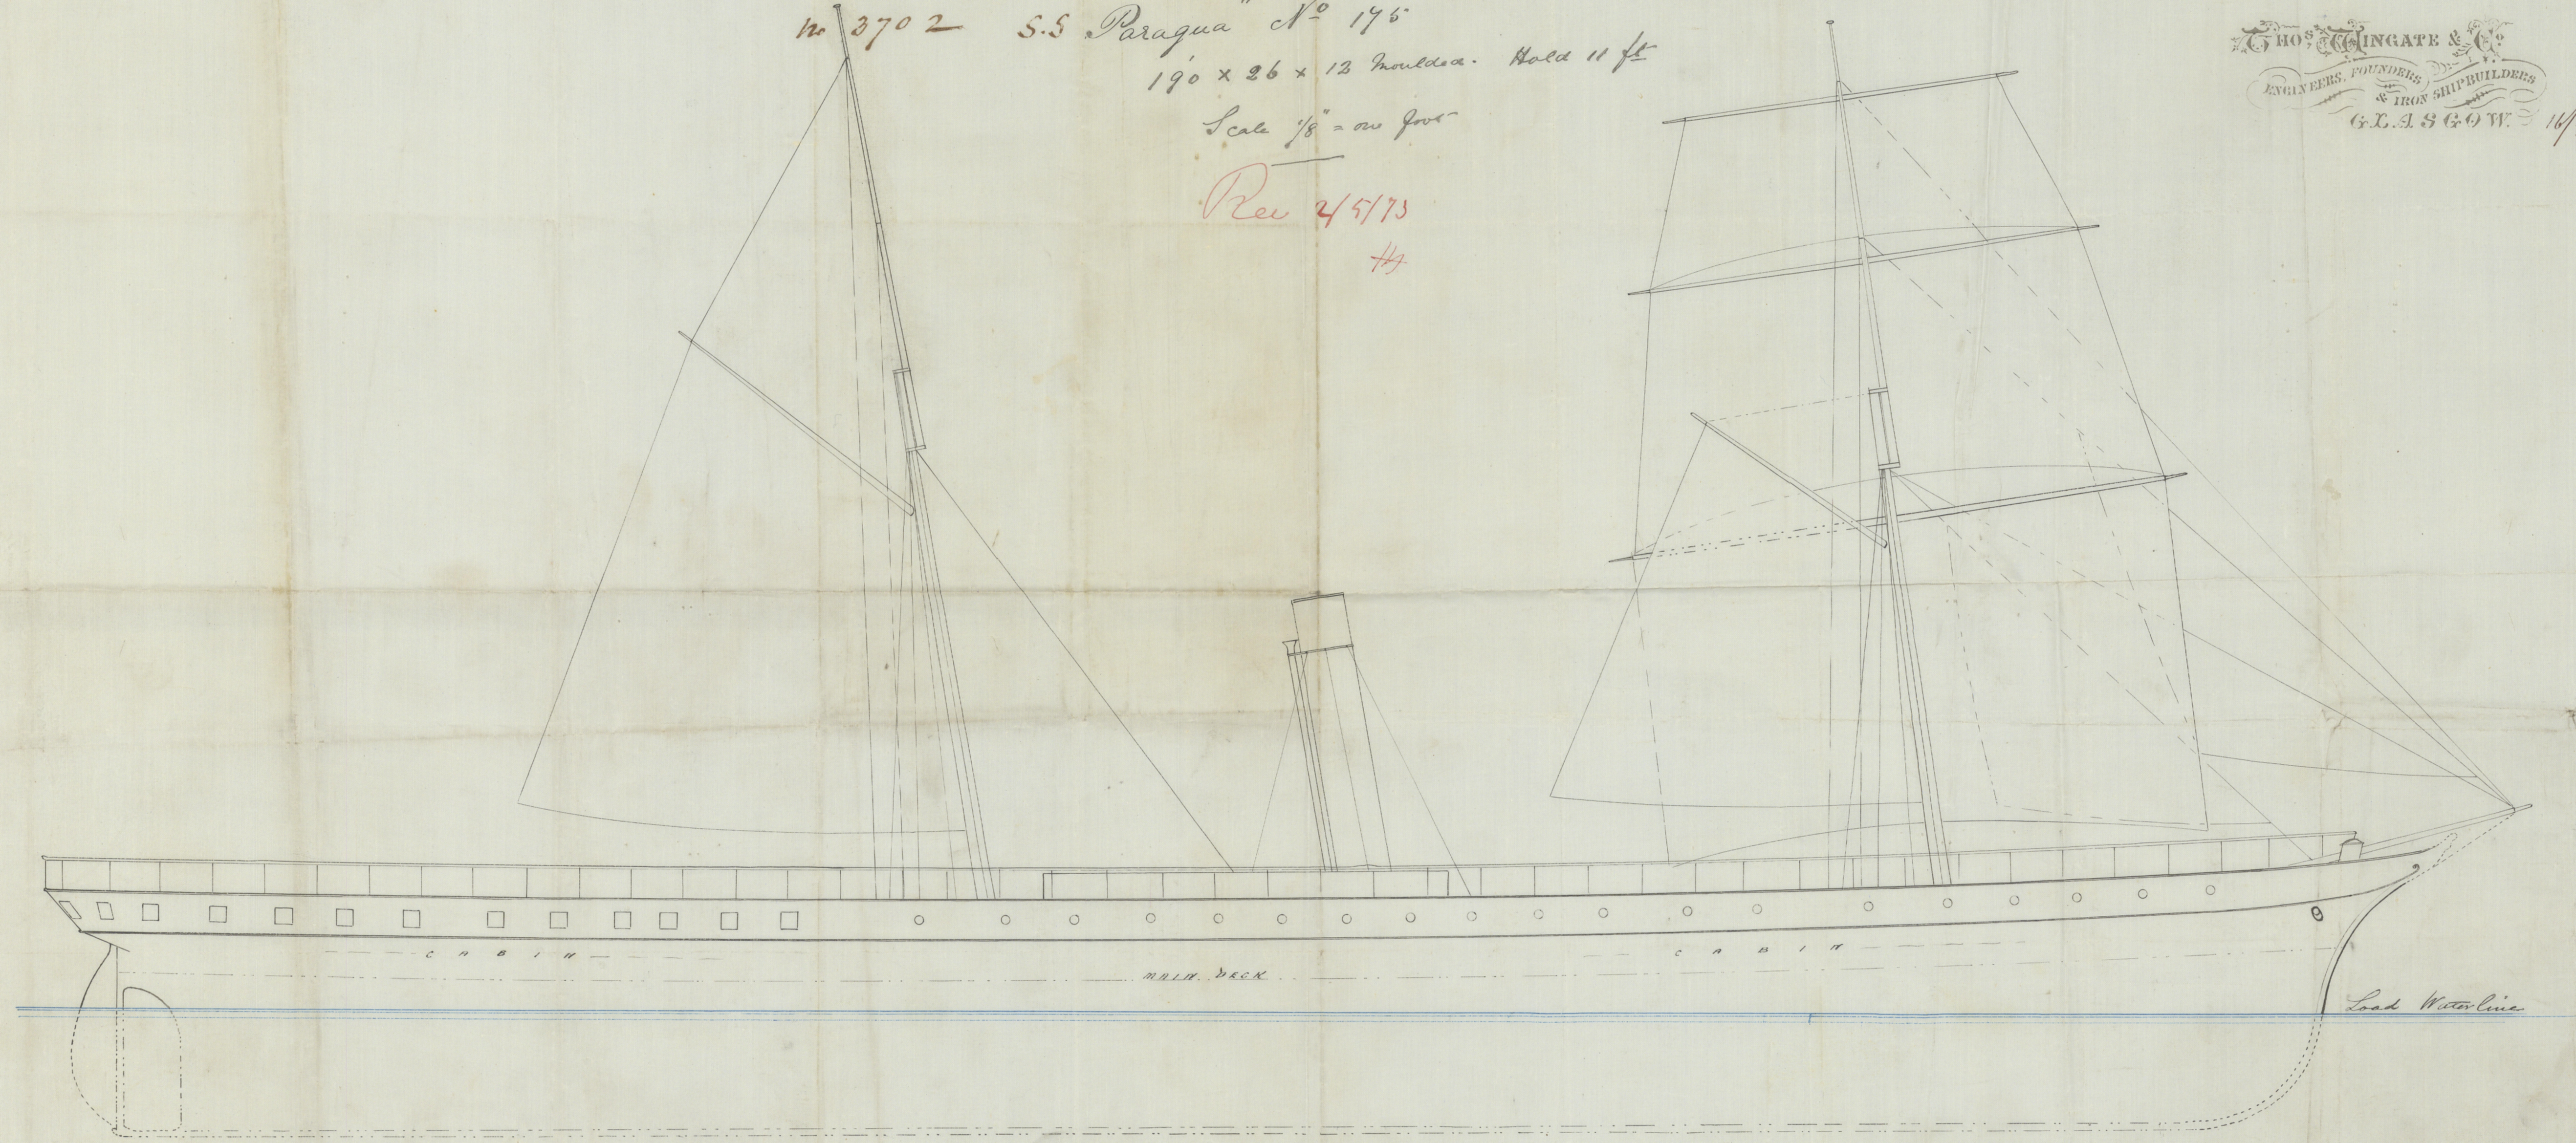

Bm
3/5/73