

July 15<sup>th</sup> 1873


Original Copy  
of Lloyd's Section

Mr & Mrs Section

S. S. "Ullerwater" - Report No. 12248.  
Scale  $\frac{1}{2}$  Inch

Scale  $\frac{1}{2}$  Inch

Vessel to be lengthened 25 feet  
Additional Seantlings shown in Red & viz.  
Stirr Strake to be doubled for  $\frac{1}{2}$  length of vessel  
with  $\frac{7}{16}$  plates  
One Strake at bilge to be doubled for  $\frac{1}{2}$  length  
of vessel with  $\frac{9}{16}$  plates  
Upper Deck Stringer plate to be doubled  
in way of engine space with  $18 \times \frac{7}{16}$  plate

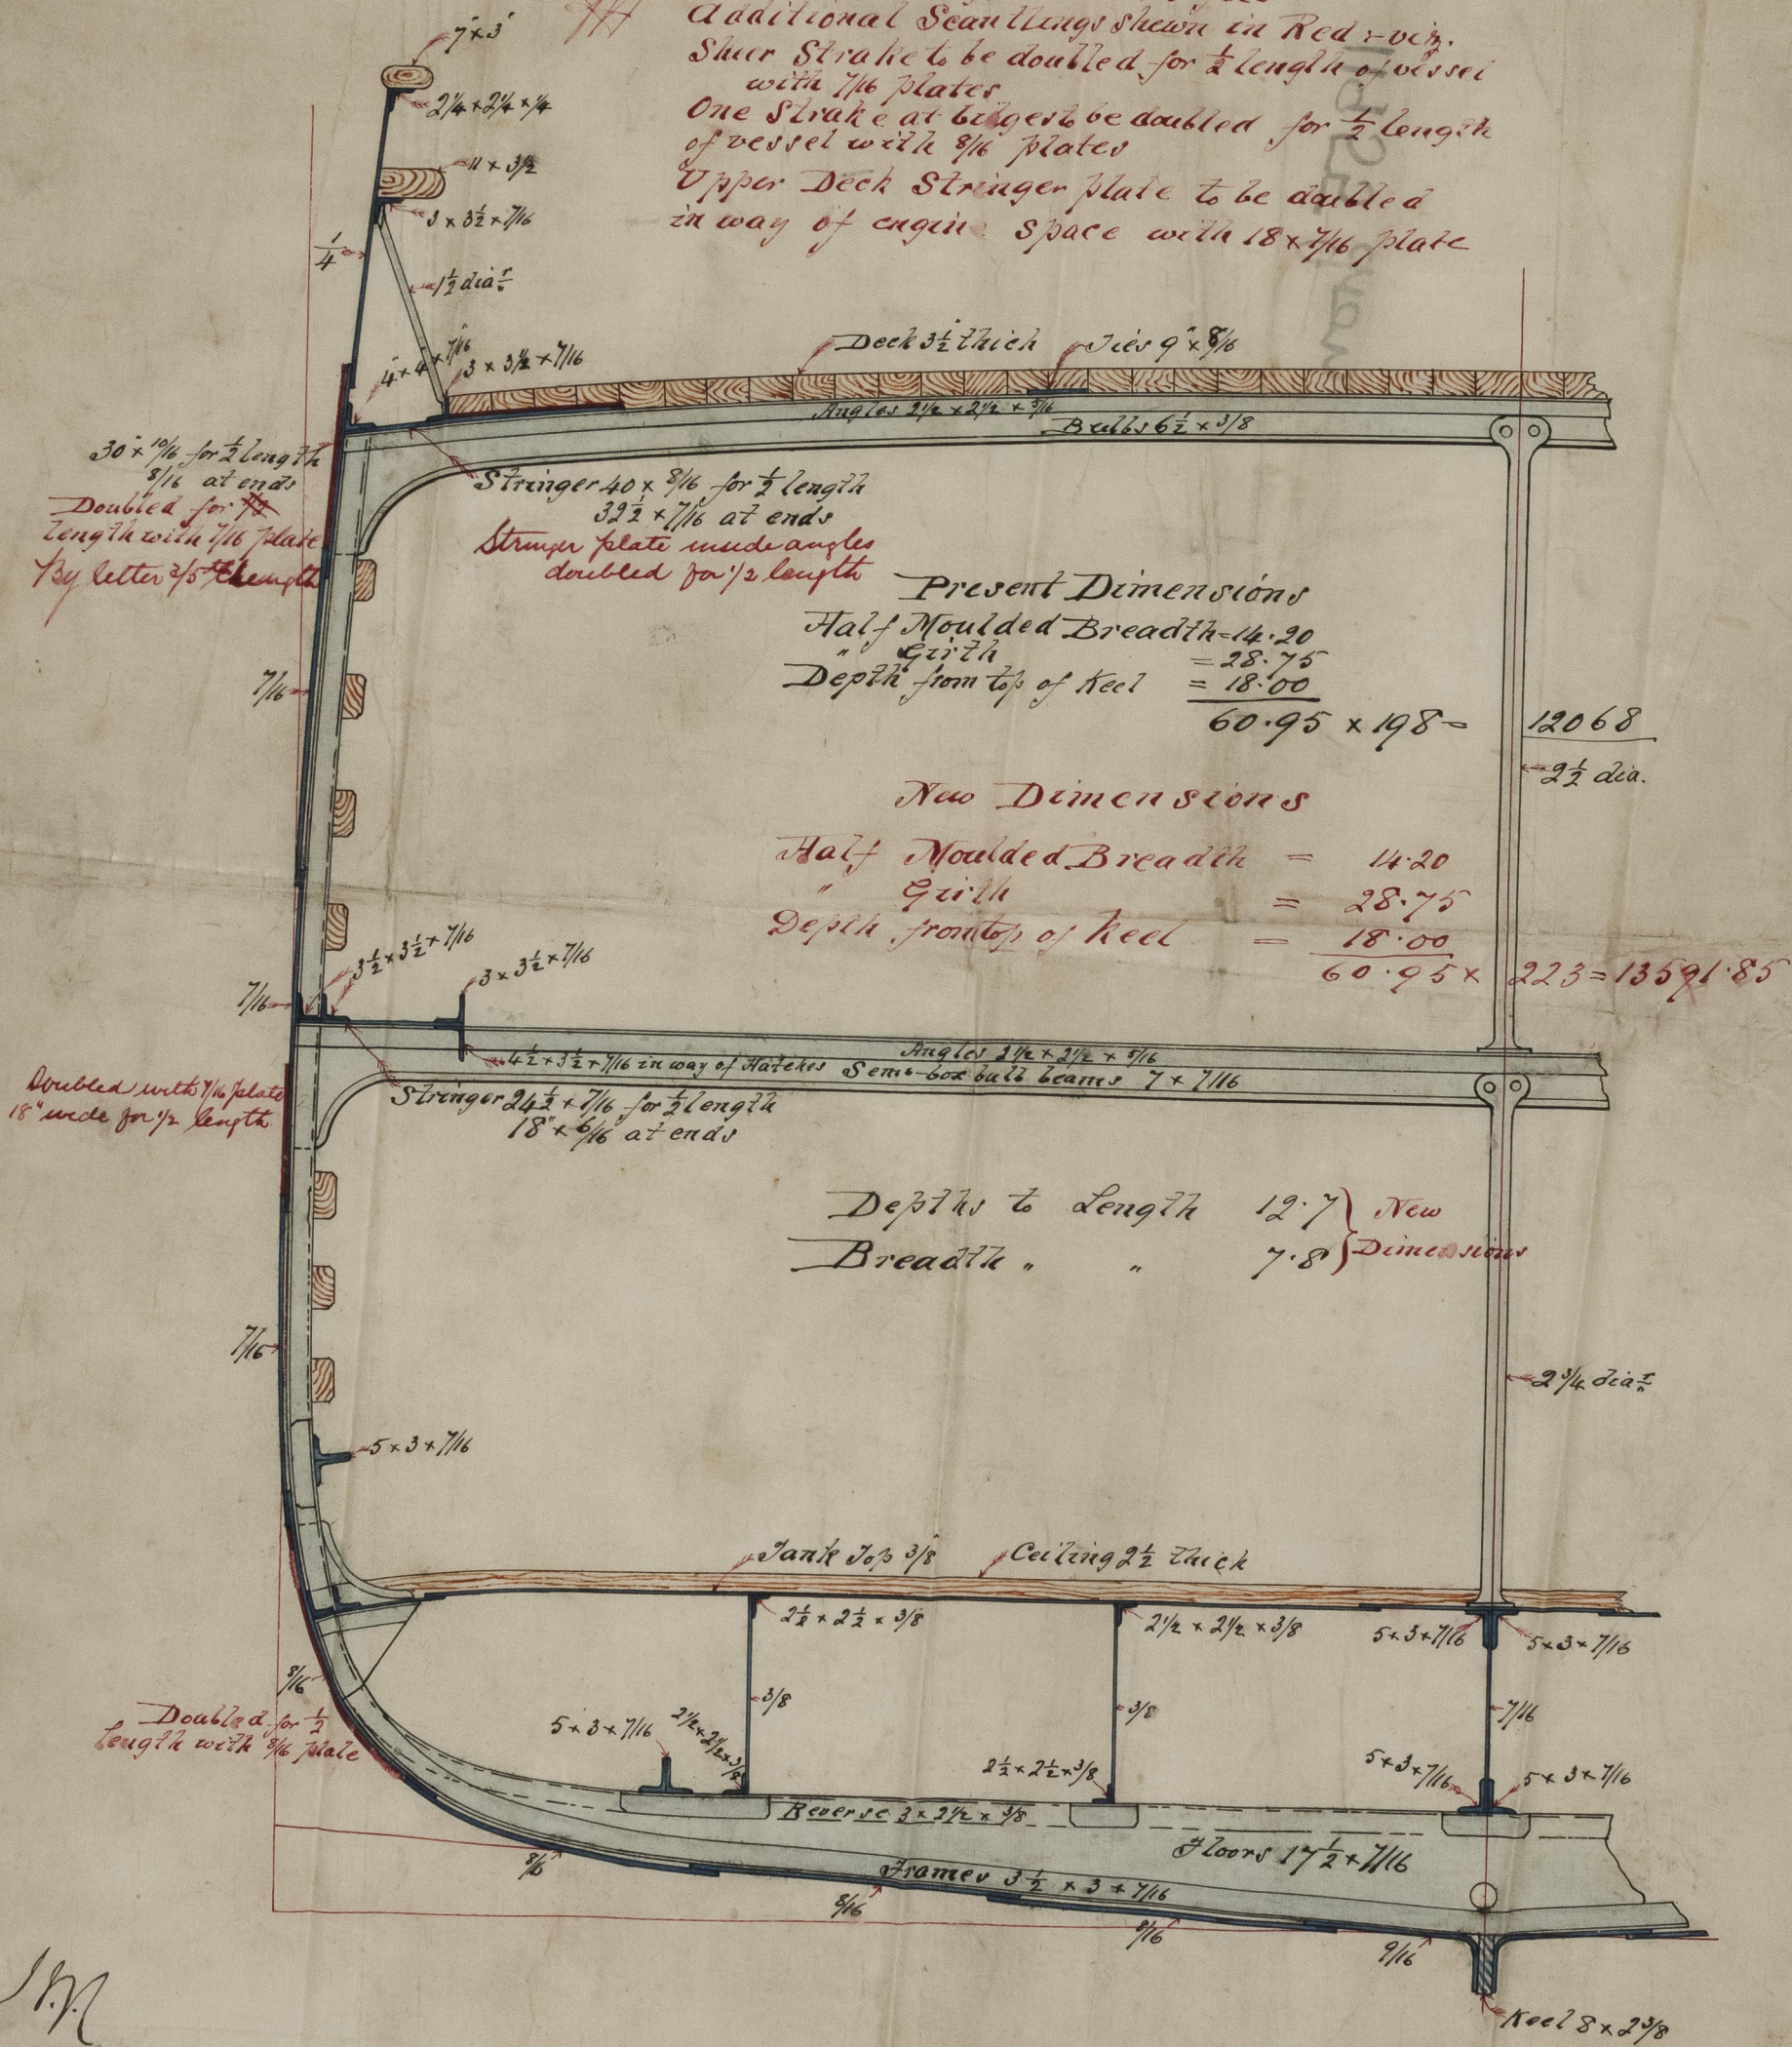

J. N.  
11/7/73



Sld 12248

Iron 11955

Original Copy

of the section

11955-11956

see the







© 2021

Lloyd's Register Foundation

180507-0254