


# Midship Section Report No 10476 "Ballochmyle" No 428

123115m

Scale 1/2 inch = 1 foot

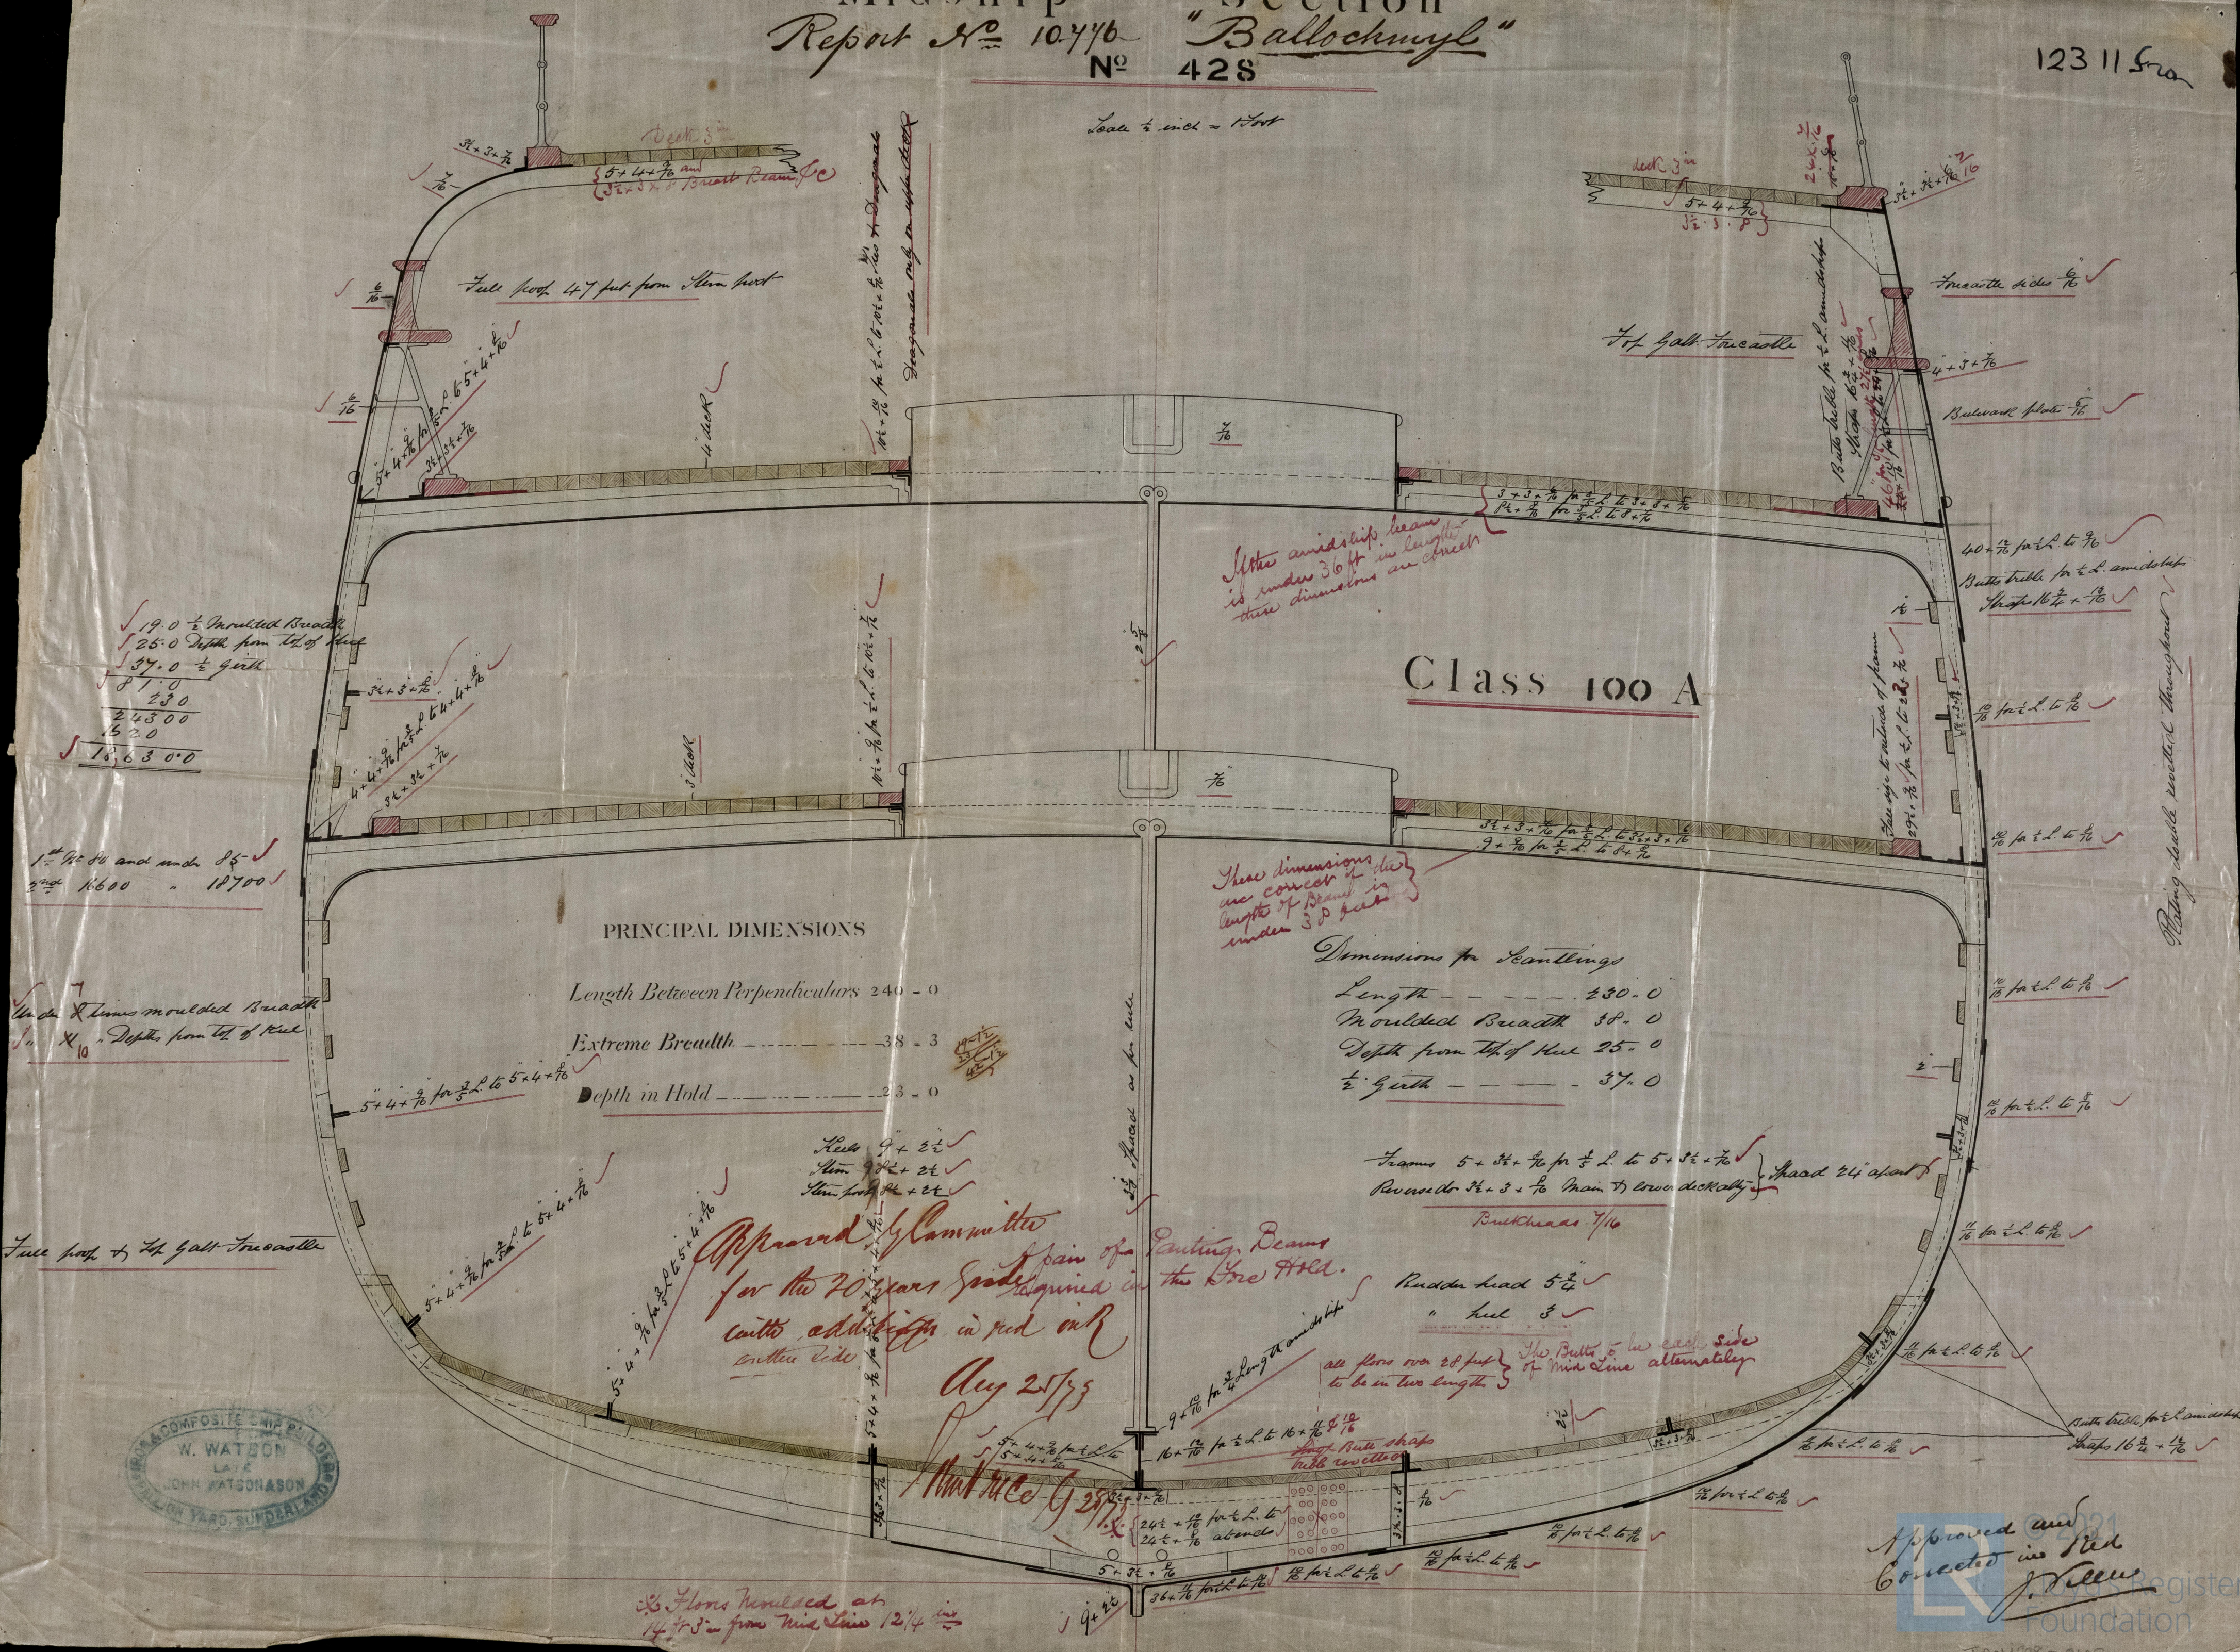

## PRINCIPAL DIMENSIONS

Length Between Perpendiculars 240 - 0  
Extreme Breadth 38 - 3  
Depth in Hold 23 - 0

## Dimensions for Loadings

Length 230 - 0  
Moulded Breadth 38 - 0  
Depth from top of keel 25 - 0  
1/2 Girth 37 - 0

Tramways 5 + 3/4 ft for 1/2 L to 5 + 3/4 ft  
Reverse for 3/4 L to 5 + 3/4 ft

Bulkheads 7/16  
Rudder head 5 1/4  
" keel 3

all floors over 20 feet to be in two lengths  
The Butts to be each side of mid line alternately

Approved by Committee for the 20 years service required in the Line Hold. with additions in red ink Aug 25/75



Approved and  
Corrected in Red  
J. Wilson  
Register  
Foundation