


290
AND
293

Handwritten notes:
March 1841

From
12318

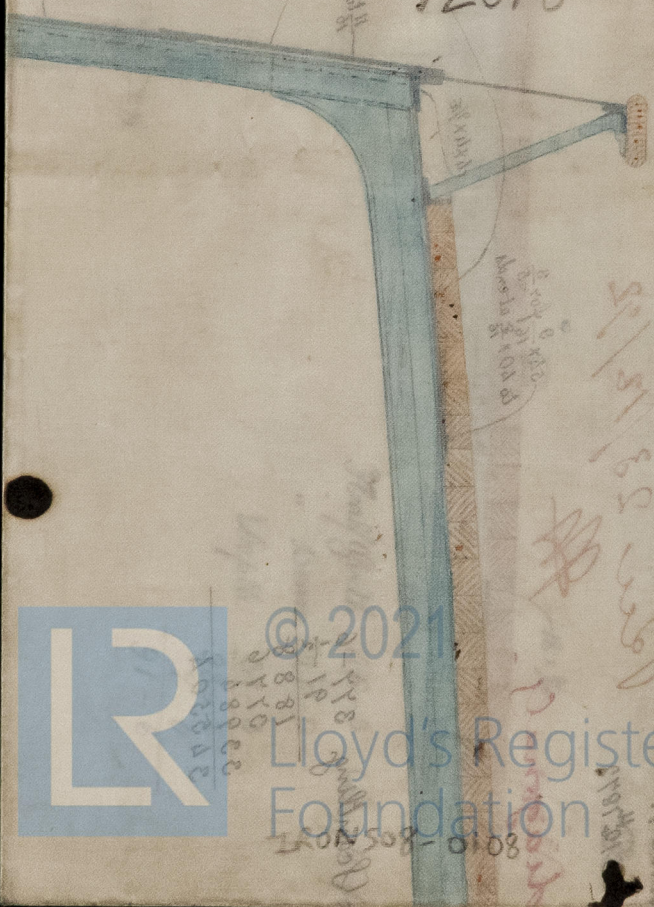

© 2021
Lloyd's Register
Foundation

From 508-0108