

Midship Section.

N<sup>o</sup> 99.

Scale  $\frac{1}{2}'' = \text{one foot.}$


Class 90 a.

$\frac{1}{2}$ moulded Beam	9 - 6.
Depth from Keel to deck	11 - 0
$\frac{1}{2}$ Girth	17 - 10
	$38 - 4 = 38.33 \times 109 = 4,177.$

Breadth to length 5.7 Depth do 9.9.

Dimensions.		ft	ins.
Length between perp <sup>s</sup>	_____	110	0
Breadth moulded	_____	19	0
Depth of Hold	_____	10	0

Twin Screw.

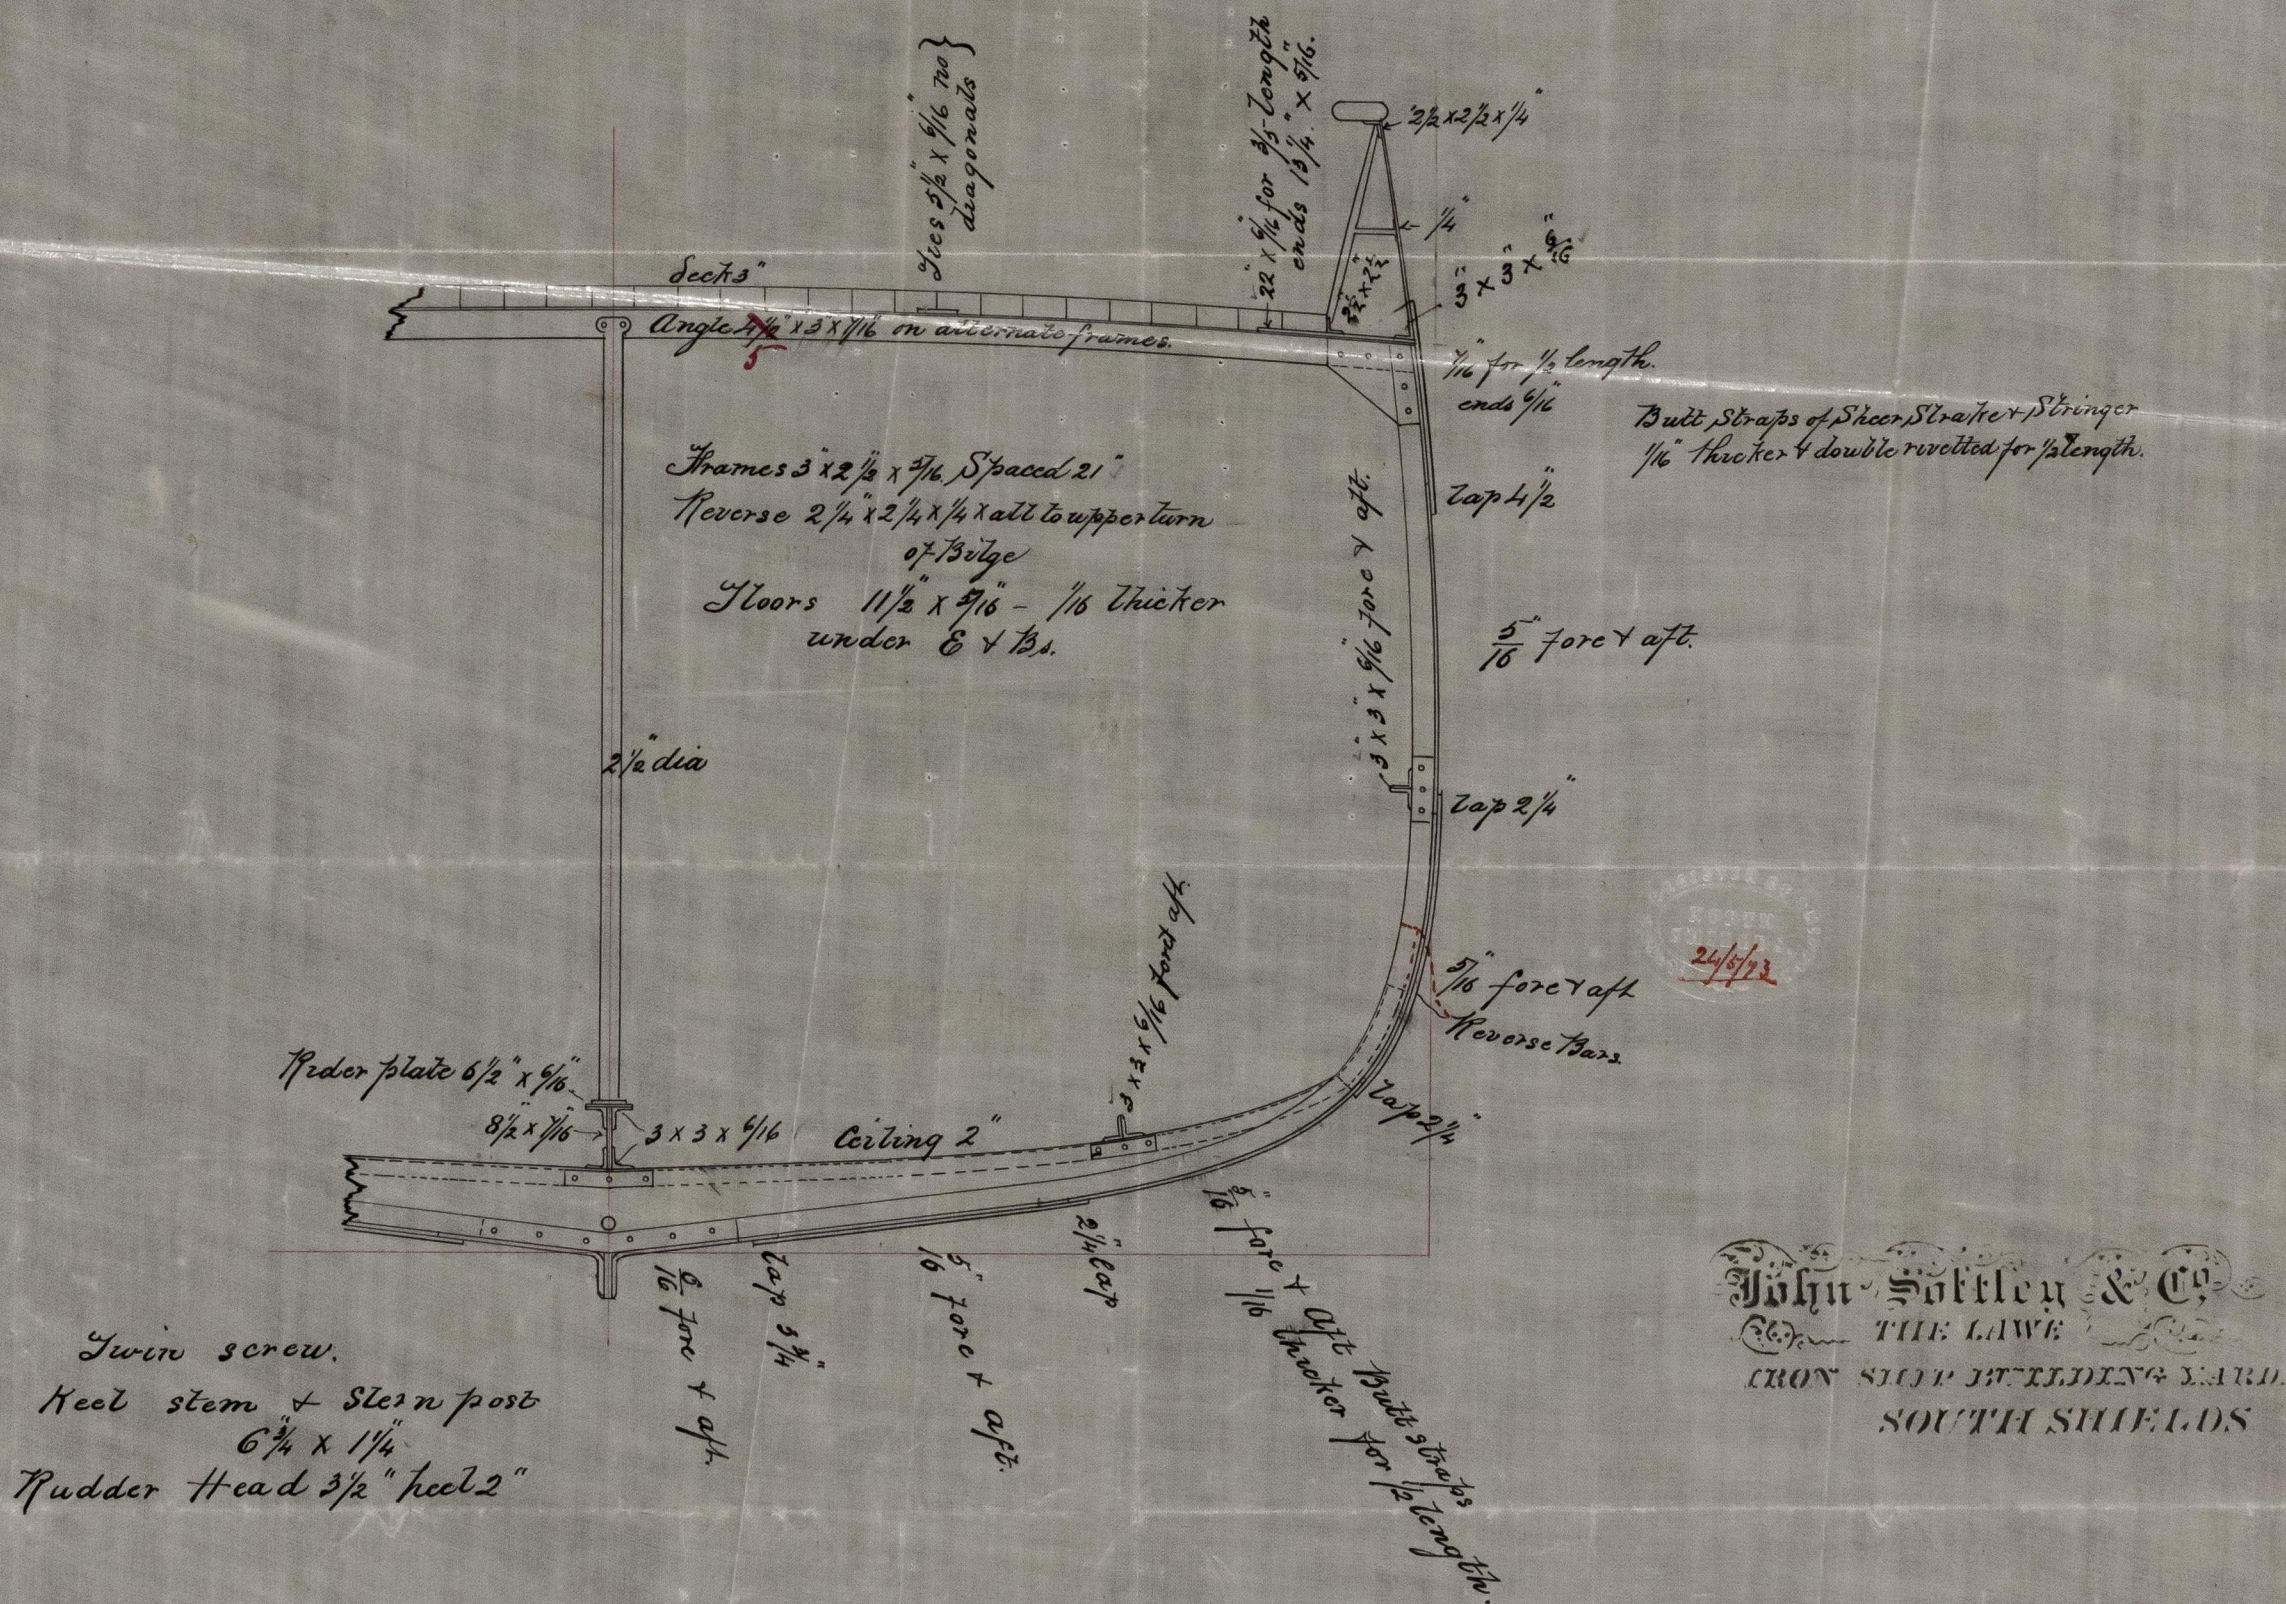

John Suttley & Co  
THE LAW  
IRON SHOP BUILDING YARD  
SOUTH SHIELDS