


W Pile No. 232 Scale 2" = 1 foot.

This shows the position, arrangement of fastening,  
amidships of lower bidge Nelson Plg. Before  
I abate the midship body where the floor rises,  
the <sup>ply</sup> overlaps the frame. Further forward kept still  
it clears the floor altogether becoming to the frame alone

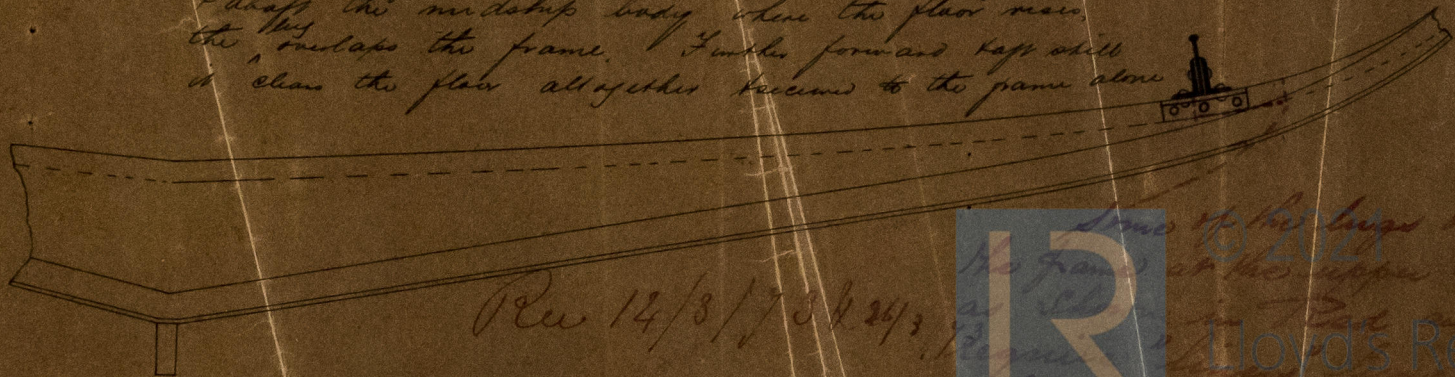

Rec 14/3/73 & 26/3



Some of the bidge overlap  
the frame at the upper corner.

Lloyd's Register  
Foundation

pan surface on which to  
rivet the log.