


(No. 175

Rec 5/5/48

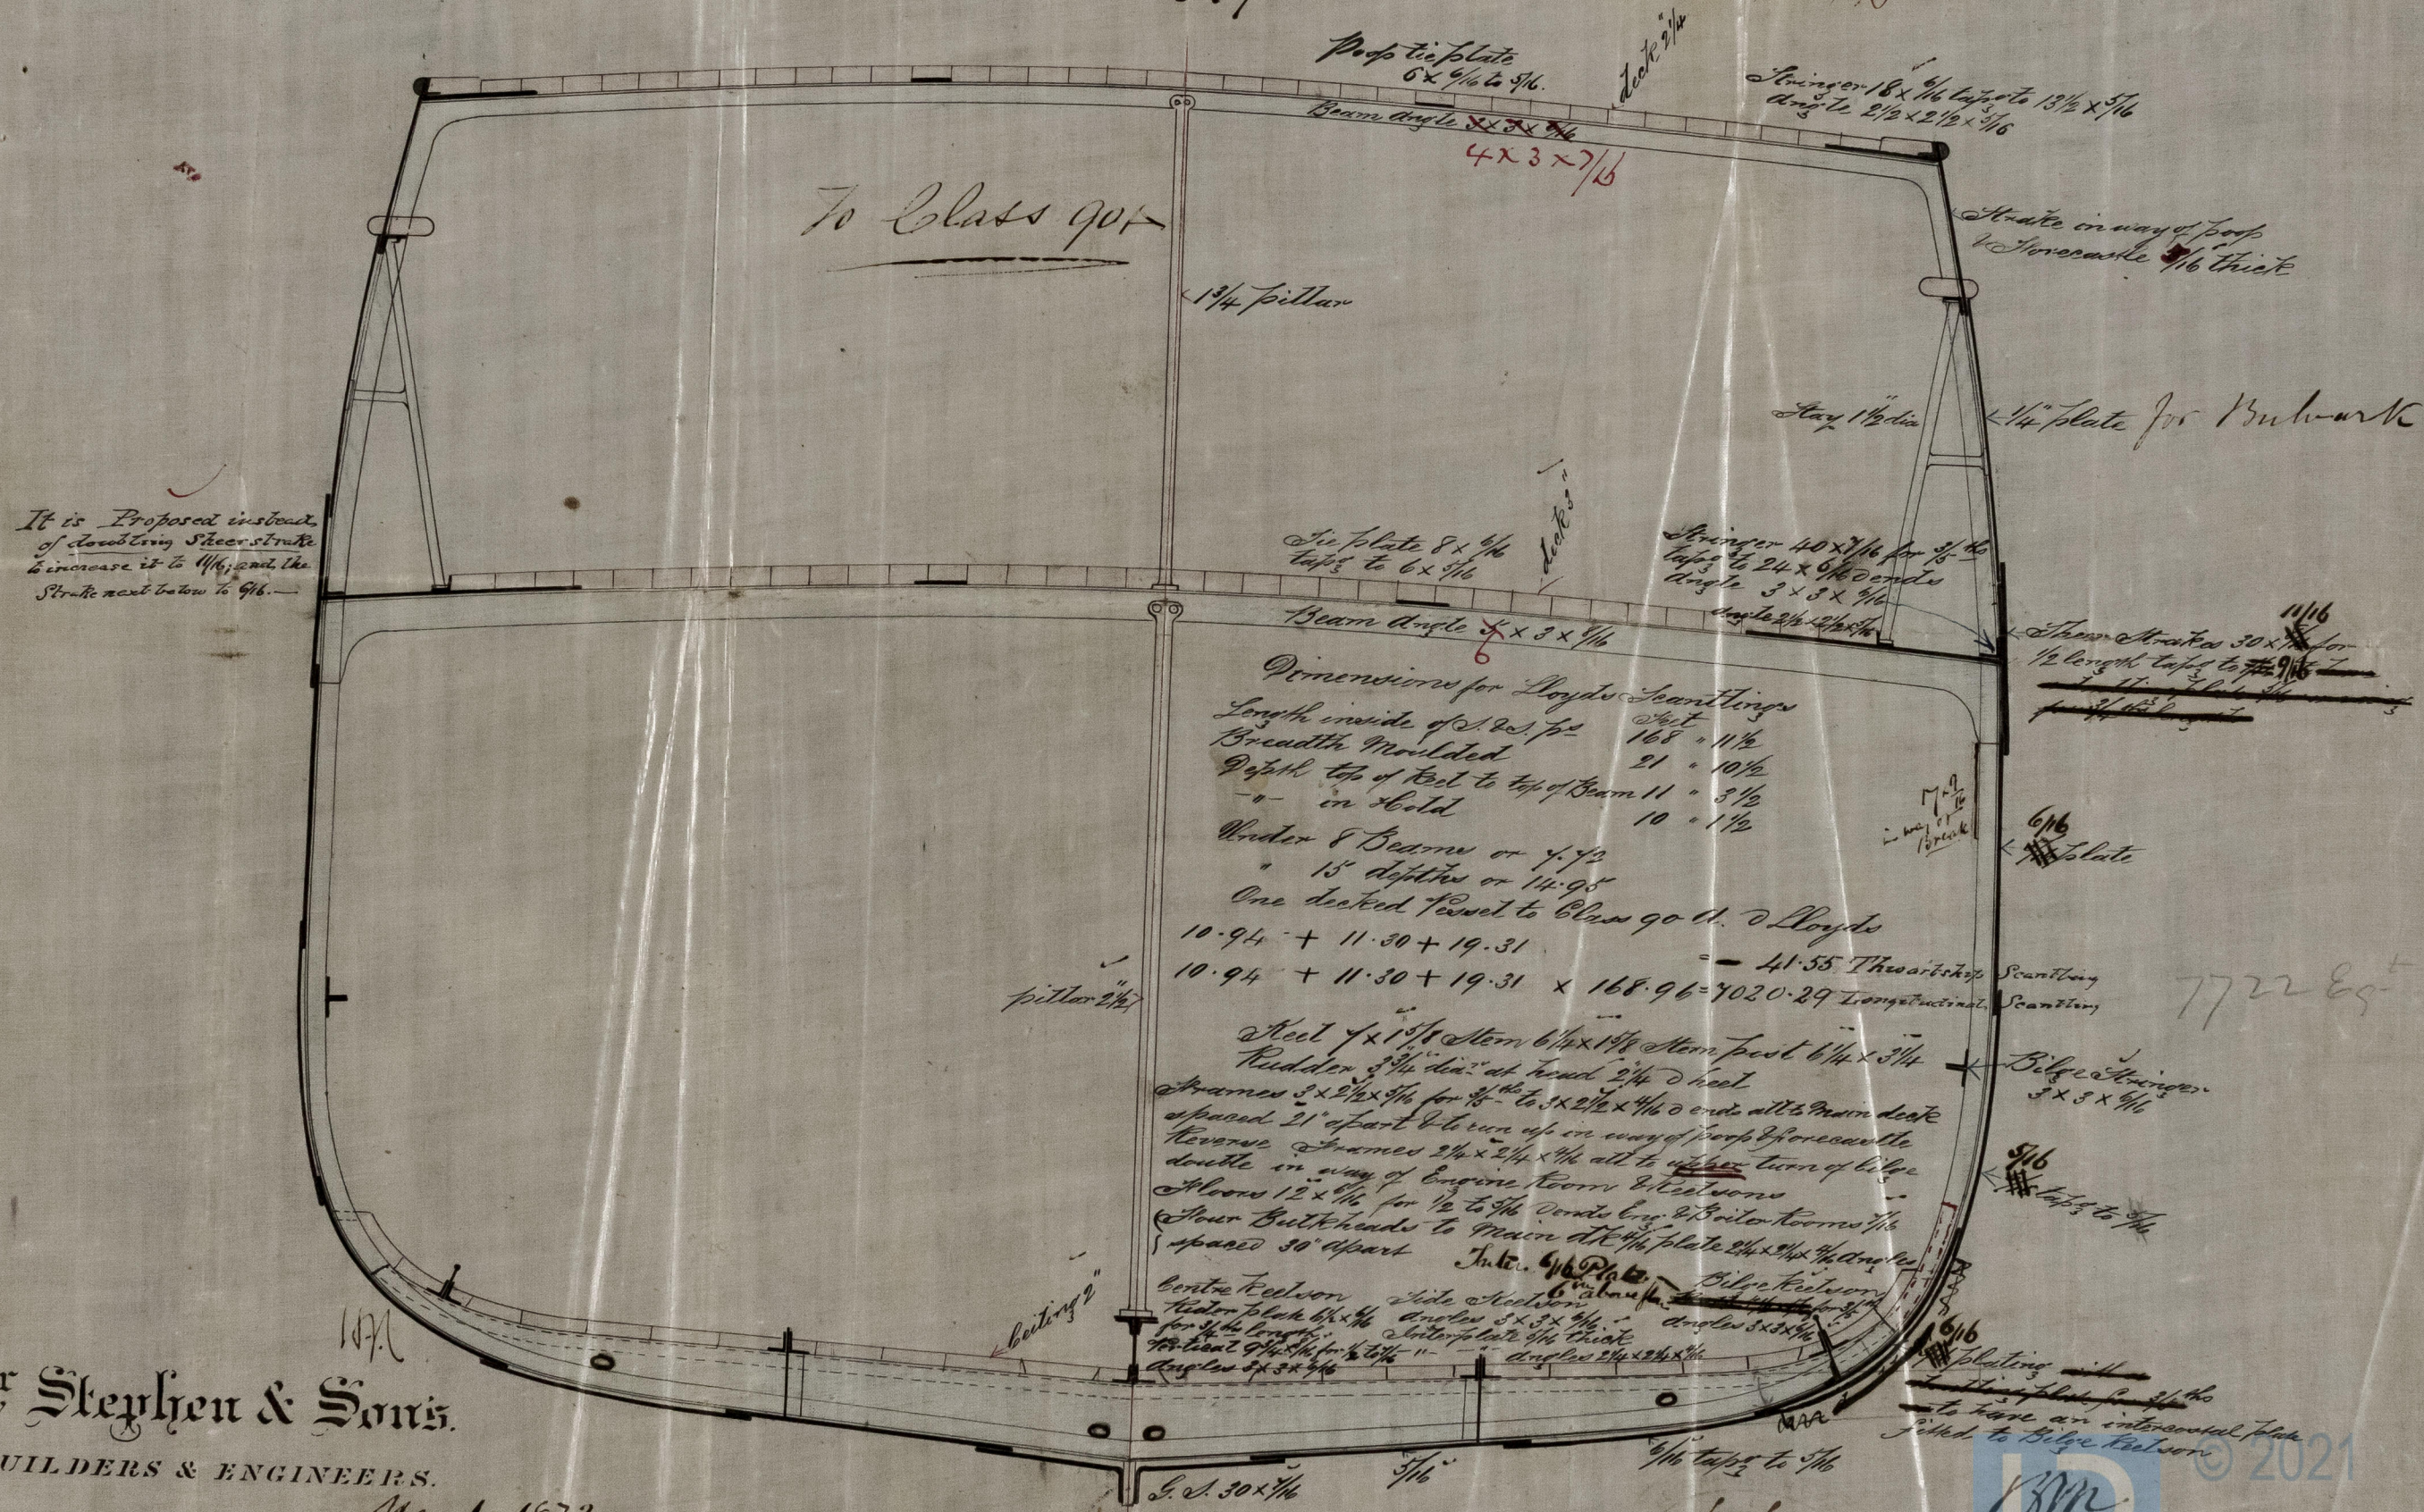

Alex^r Stephen & Sons.

SHIPBUILDERS & ENGINEERS.

GLASGOW

May 1. 1873

FRONS08-0160

12468 *Pen*

WIDSHIP SECTION

SCALE 1/2 INCH TO A FOOT

(20.2 172)



© 2021

Lloyd's Register
Foundation