

5001  
N<sup>o</sup> 329


Stm. "Pharos" Glasgow Report No. 3798

Dec 14/5/73

# MIDSHIP SECTION

SCALE 1/2 INCH TO A FOOT

100A

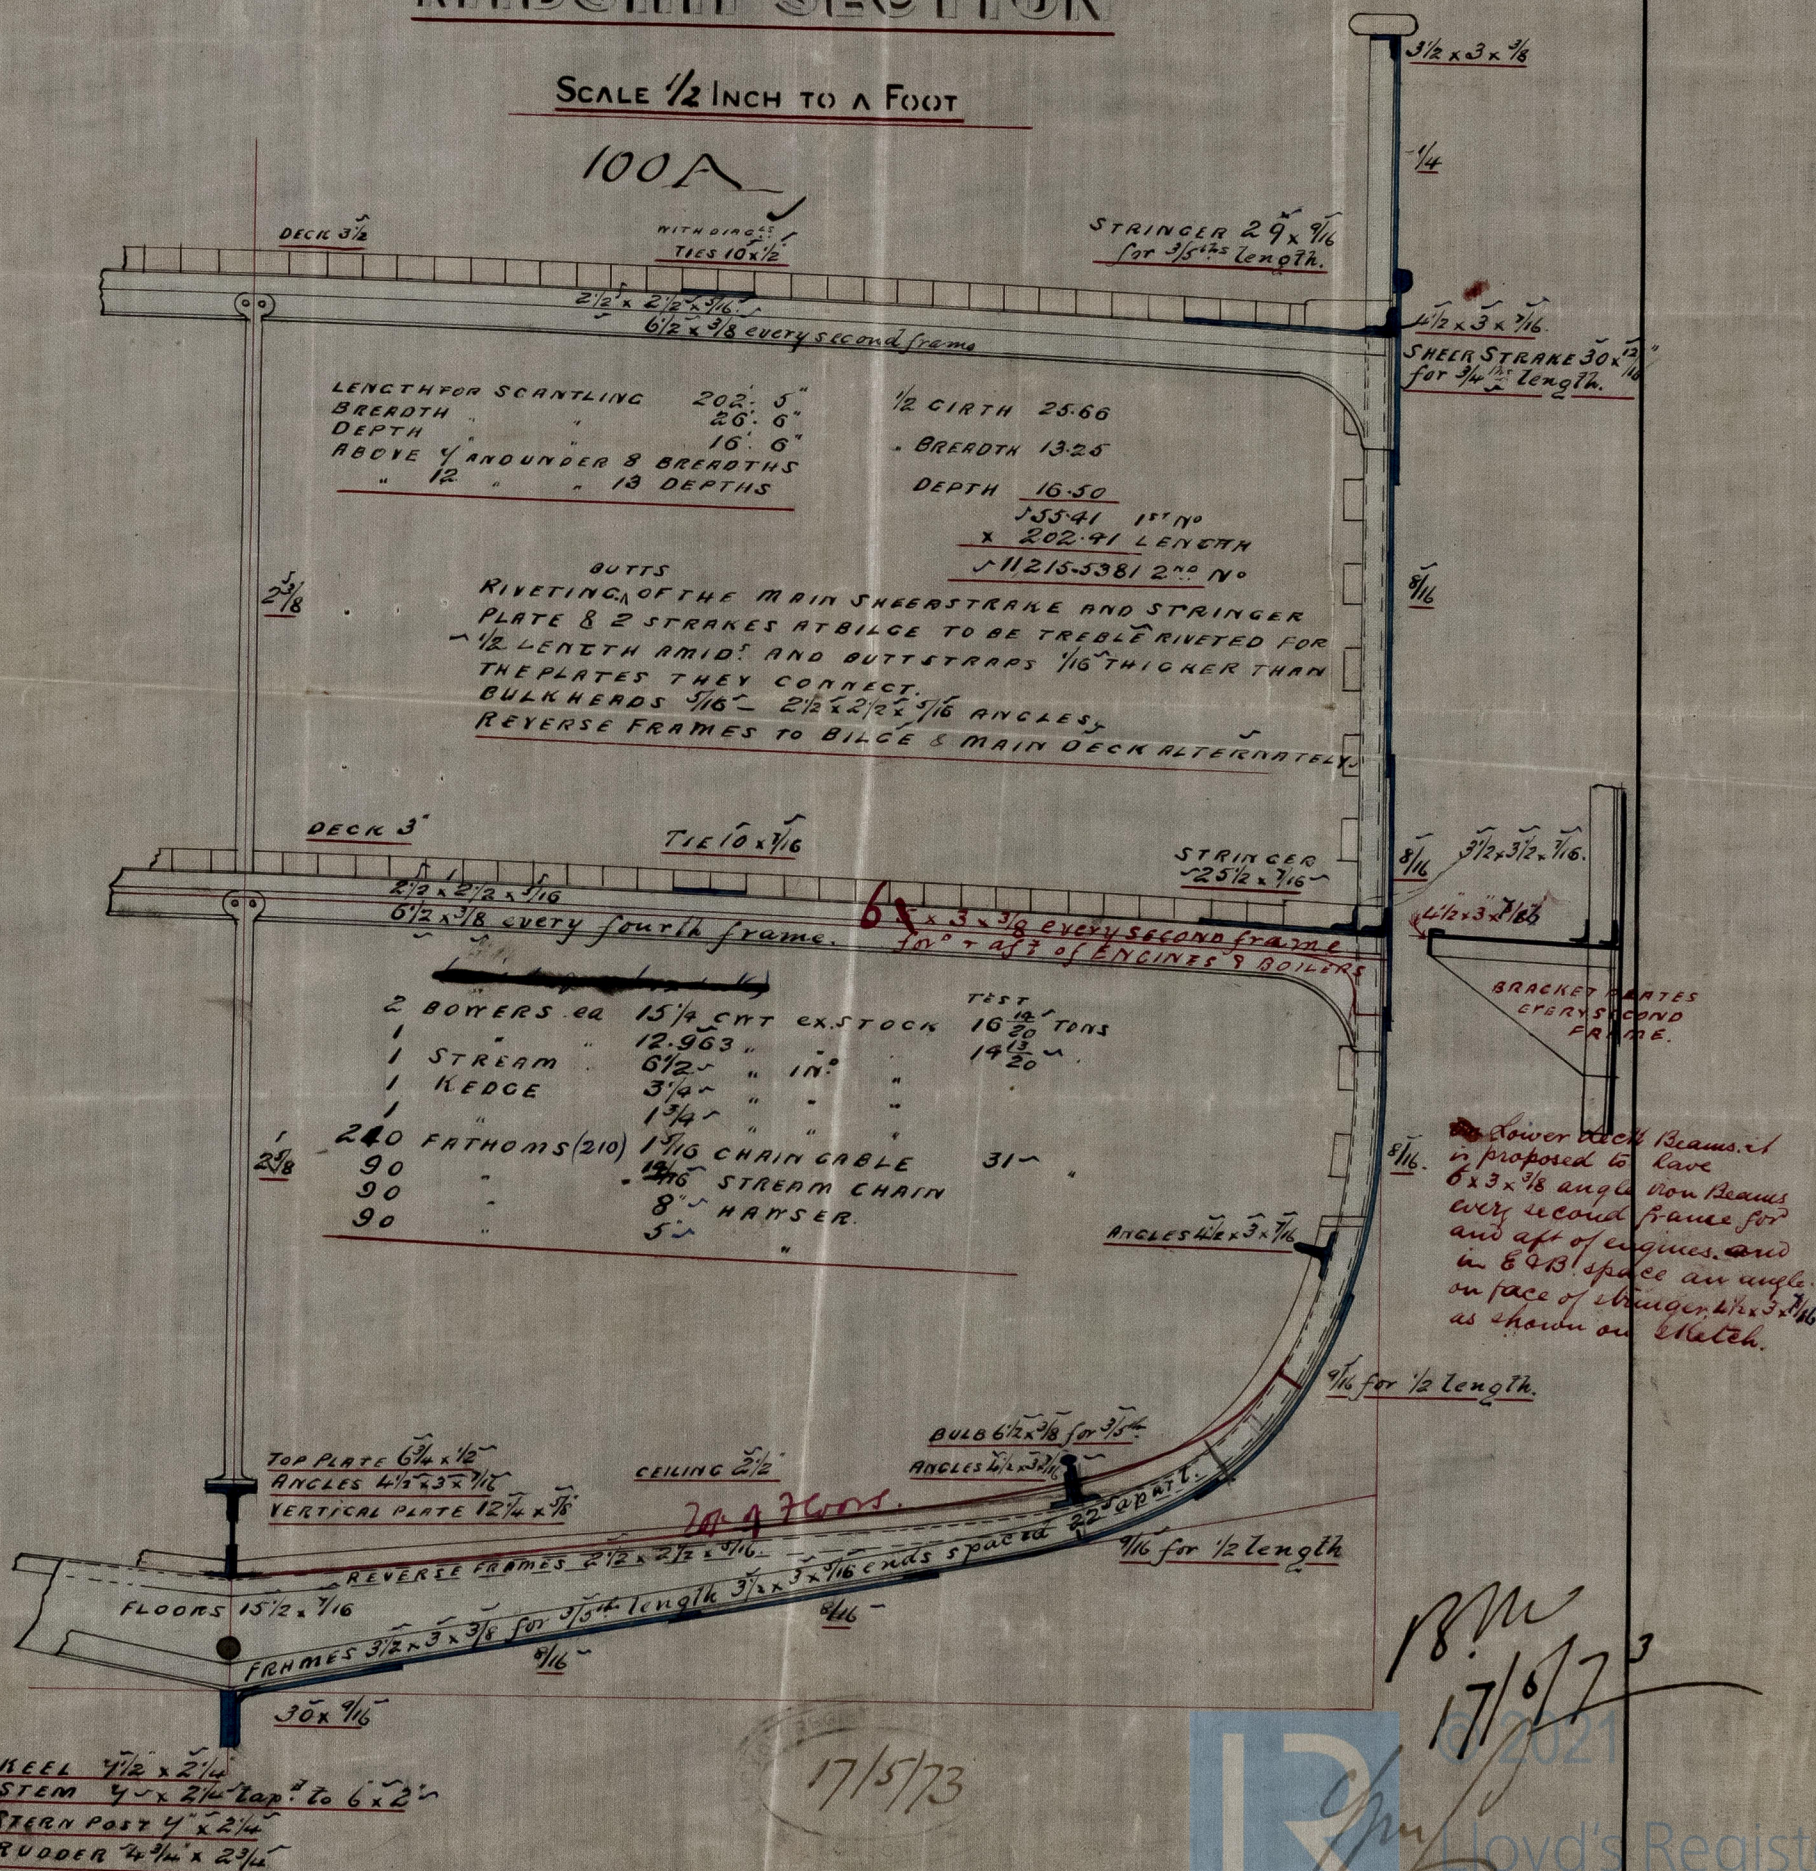

17/5/73

18th  
17/5/73