"Welfare" – Report No 12407.

Midship Section.

S.S No. 102.

Class 90 A, Scale 1" = one foot.

Rec 25/8/73

½ moulded breadth ____ 8' = 11½"
depth from top of keel ____ 10 = 1
½ Girth of section ____ 16 = 8
35° = 8½ = 35·708 × 79 = 2,820.

Breadth to length 4·4 — Depth do 7·8.

Dimensions.

Length as per rule ____ 79'-0"
Breadth moulded ____ 17-11
Depth from top of keel ____ 10-1.

"Note"

Sectional Area of Built Angles — 3·125.
" " " proposed beam. — 3·281.

Frames 2½" × 2¼" × 5/16" spaced 21"
Reverse 2¼" × 2¼" × ¼" to upper turn of Bilge.
Floors 11" × 9/16" 1/16" thicker under E. & B.
Keel & Stem 6" × 1⅛" Post 6" × 2¼"
Rudder head 3" heel 2"
Bulkheads ¼" Engines aft.

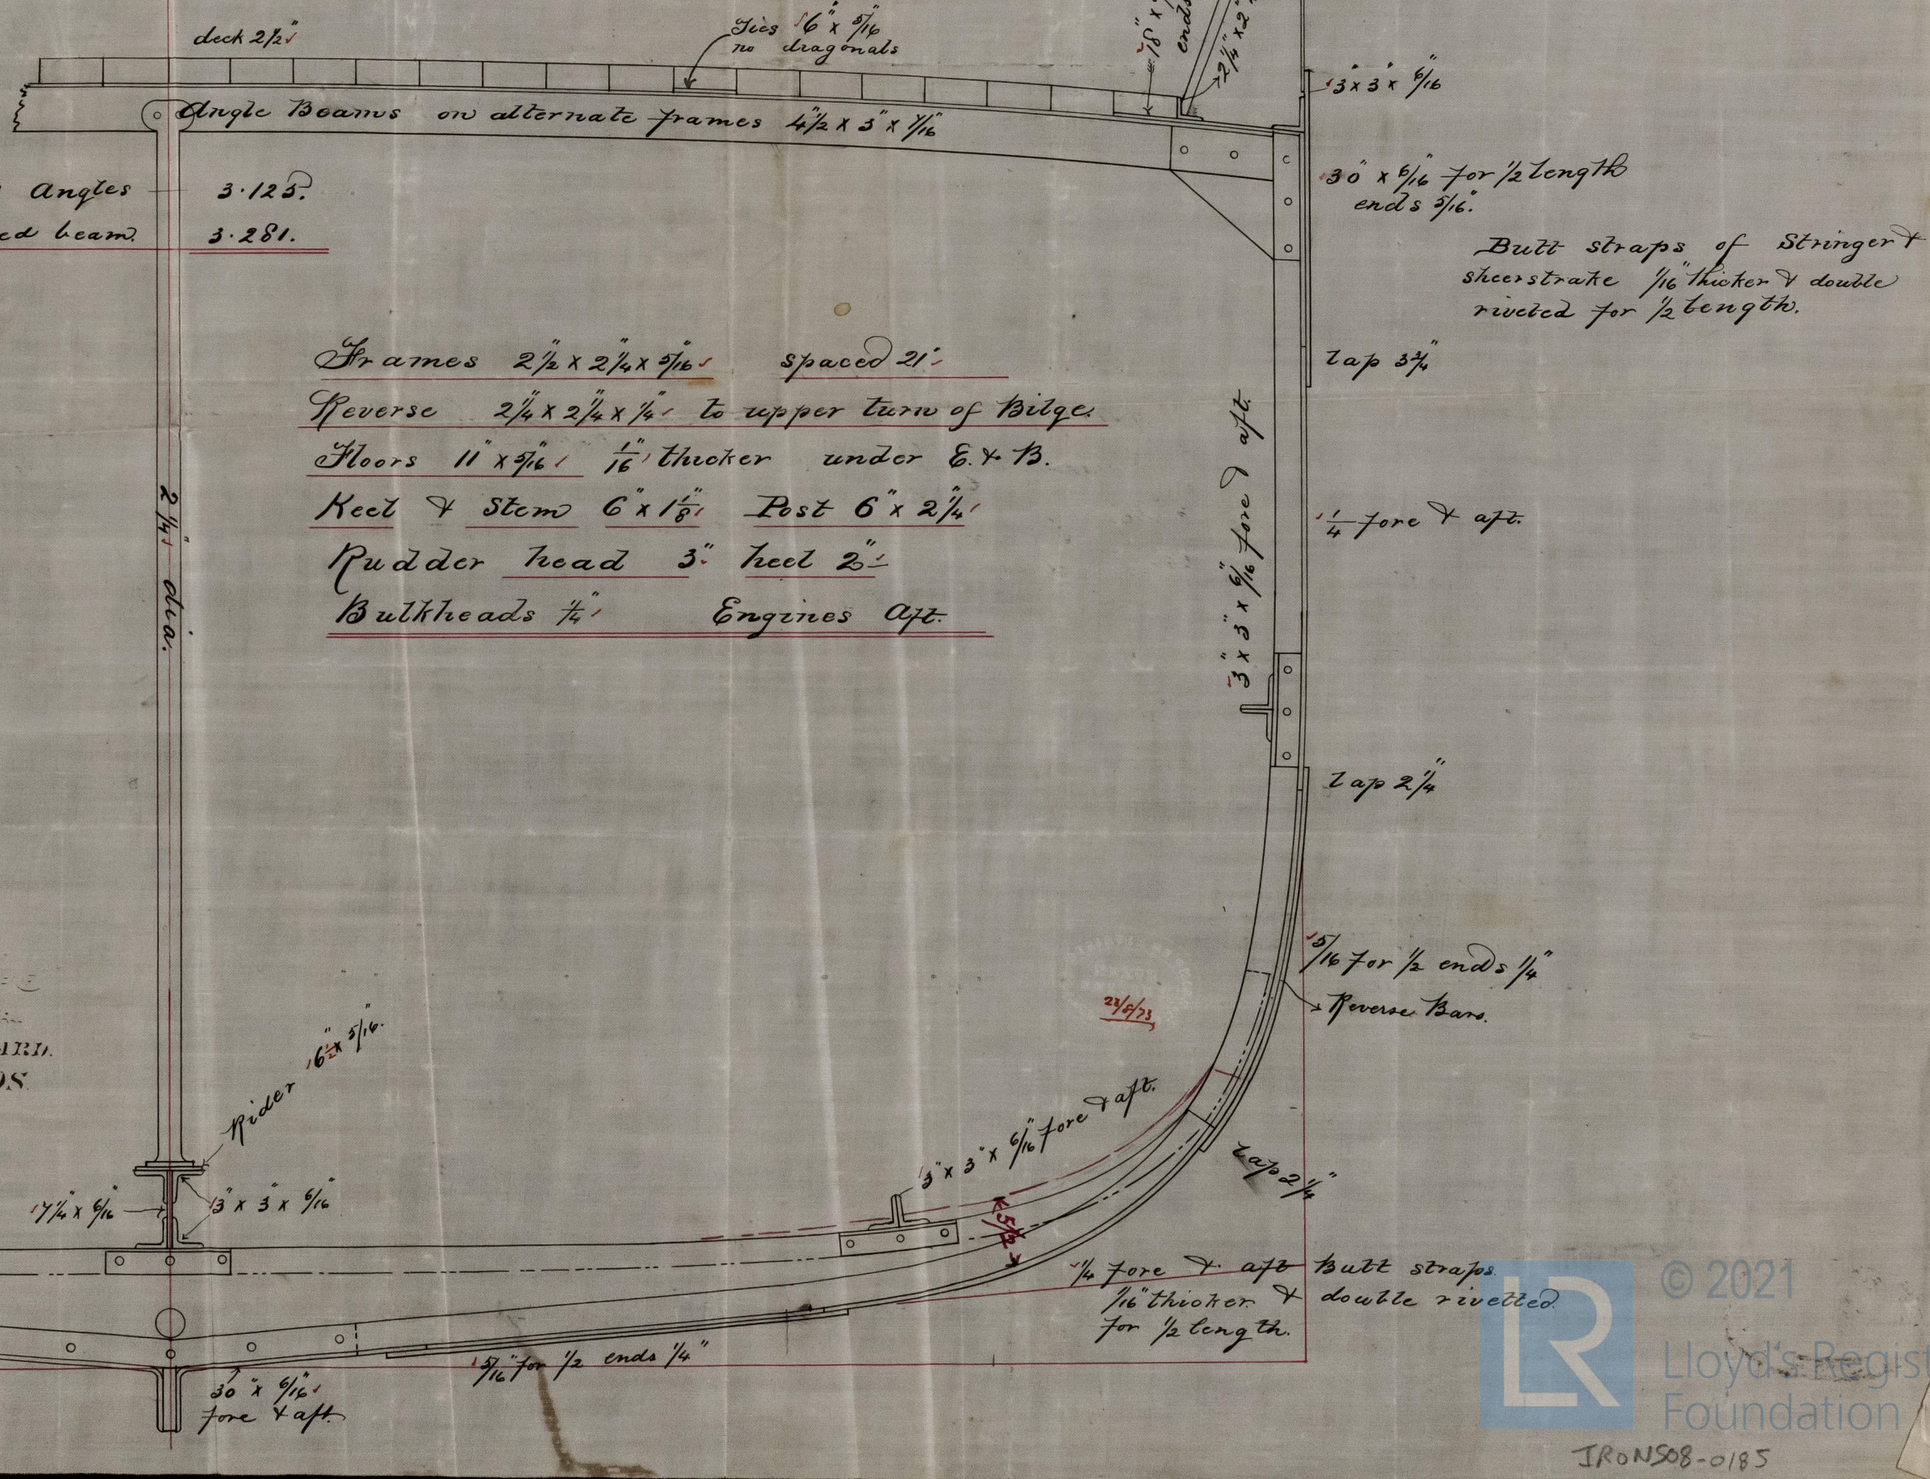

John Sotlley & Co.
THE LAWE
IRON SHIP BUILDING YARD.
SOUTH SHIELDS.

LLOYD'S REGISTER OF SHIPPING 25/8/73 LONDON

25/8/73

© 2021 Lloyd's Register Foundation
IRONS08-0185