

12576 Iron

No 62 "Girce" Report No 10,675  
 " 64 "Rhoderick Dhu" No 10,746  
 " 66 "Eastern Monarch" 10,841


MIDSHIP SECTION OF NO 62 I. S. S.  
 64 & 65

TO BE CLASSED AT LLOYD'S HULL

SCALE  $\frac{1}{2}$  INCH = 1 FOOT

Rec. 13/2/73

South Dock Iron Shipyard  
 July 11th 73

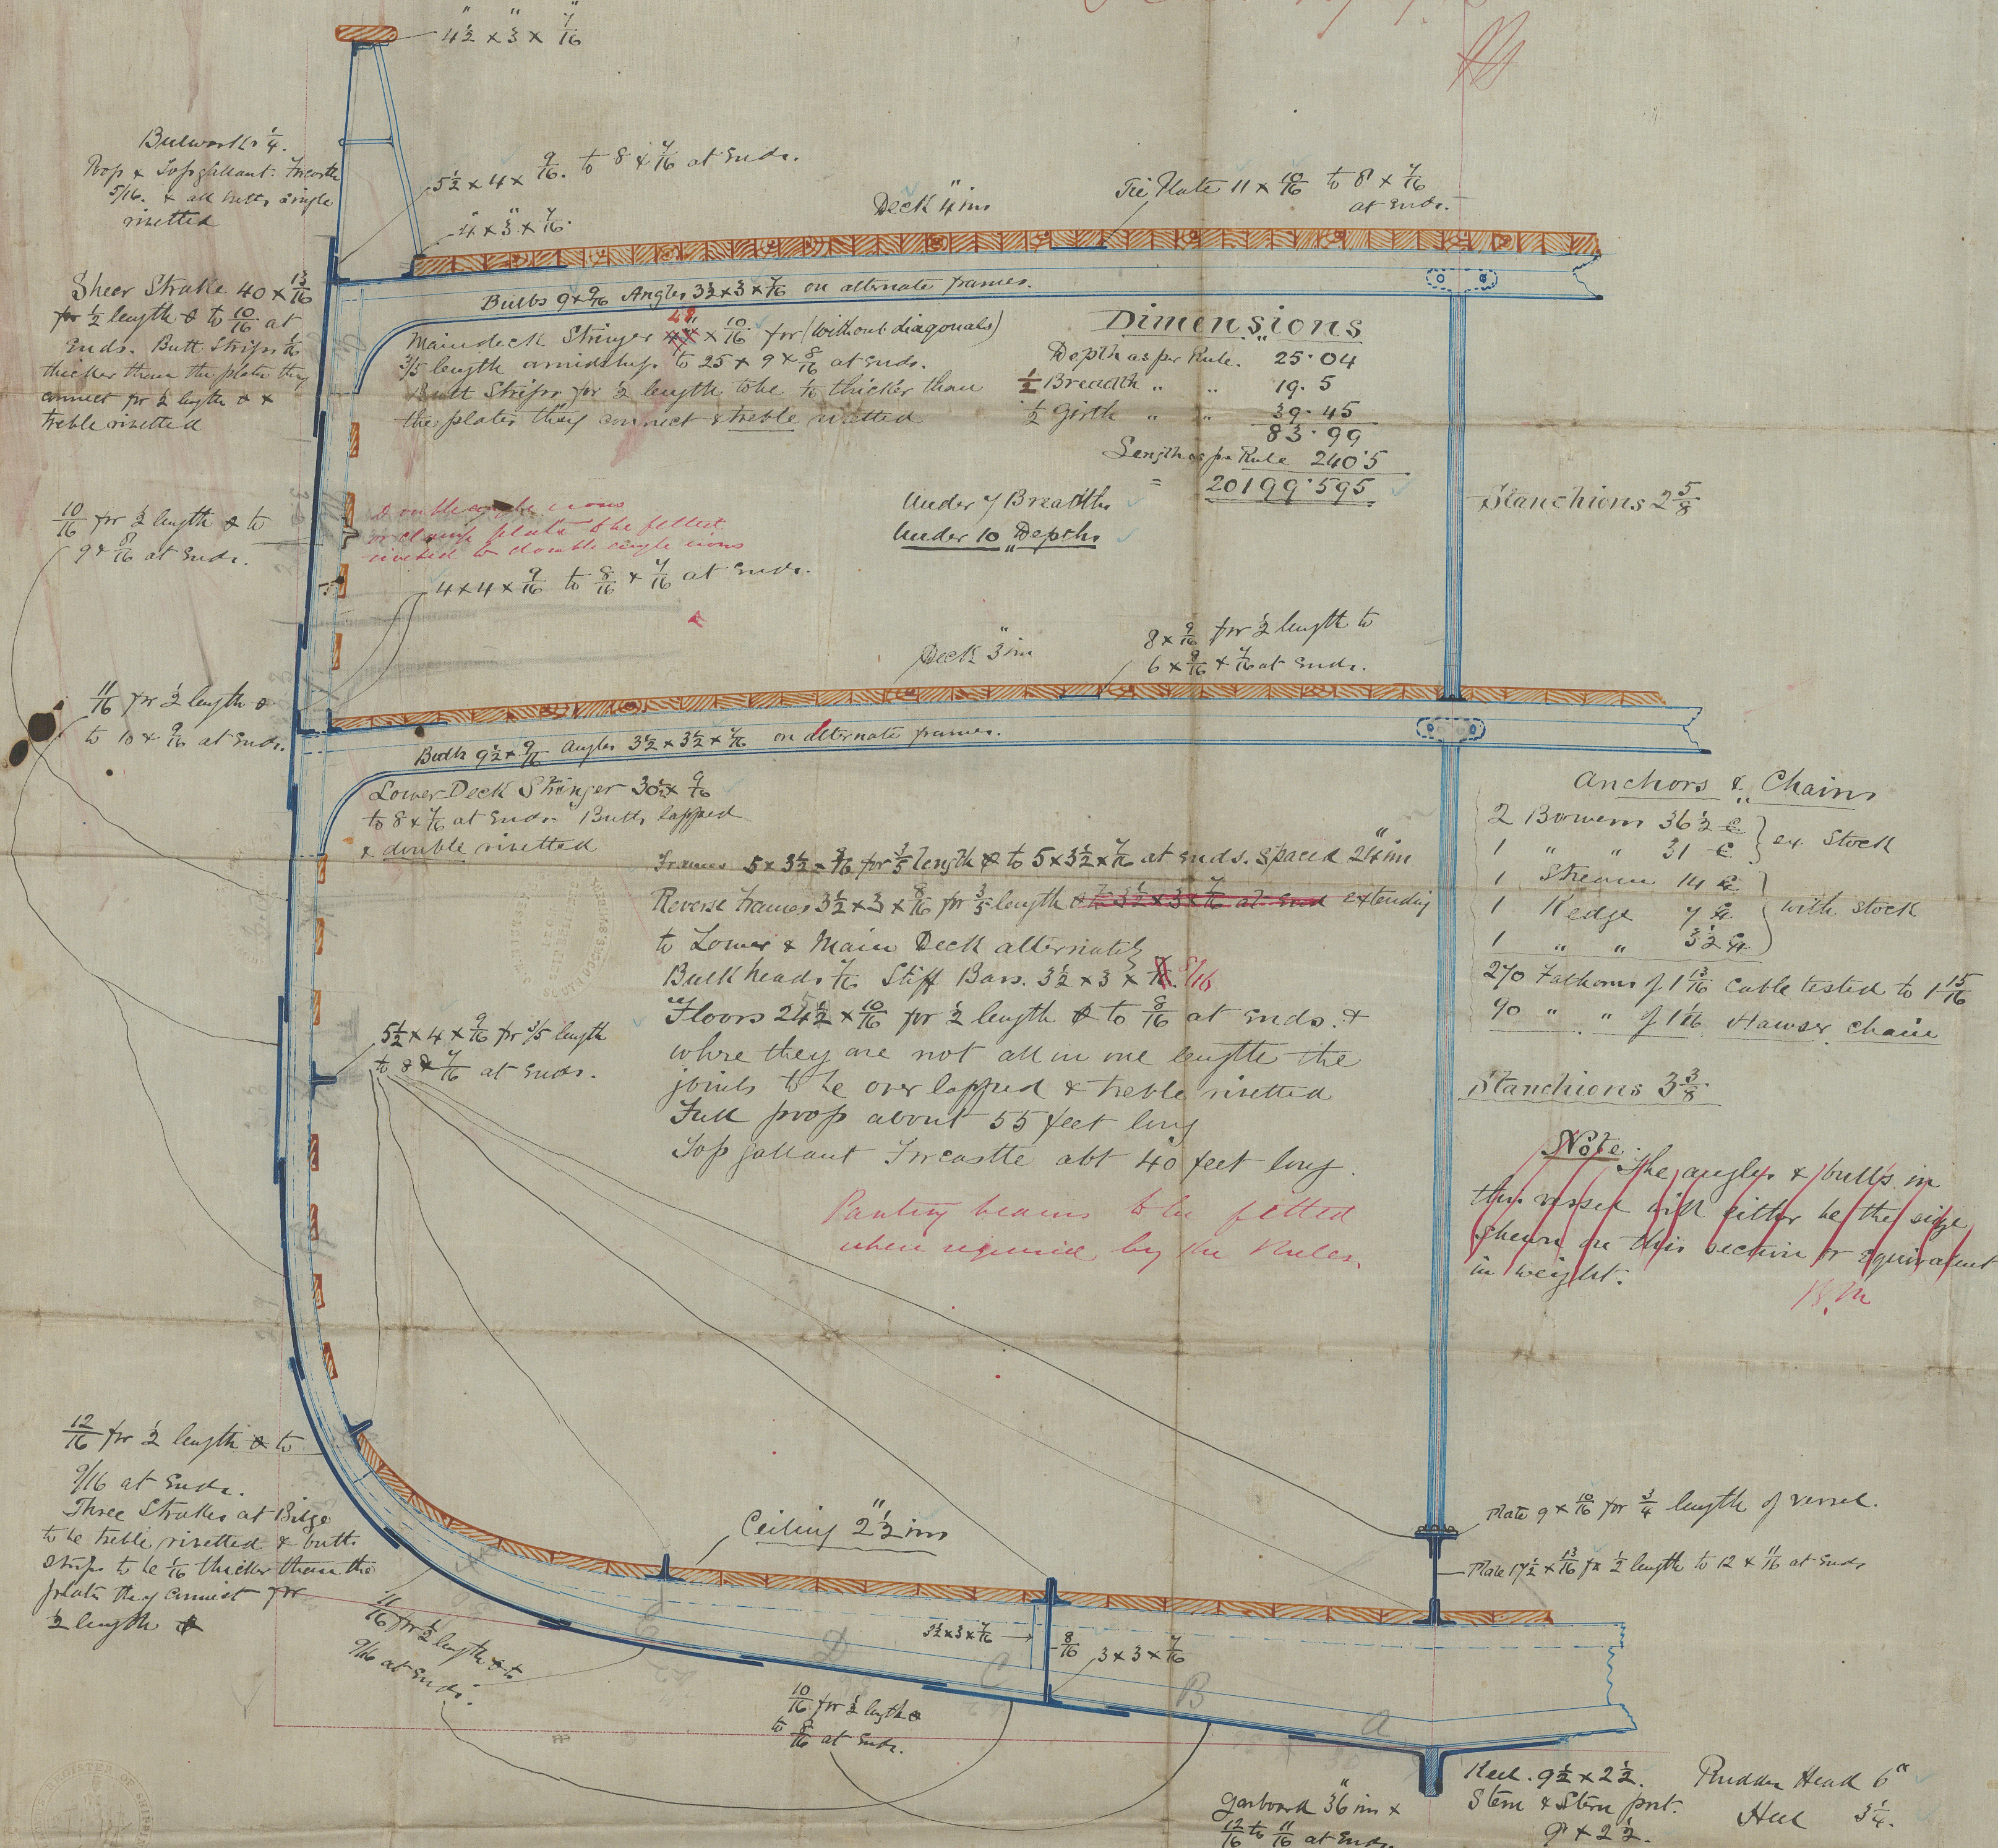

Dimensions

Depth as per Rule	25.04
1/2 Breadth	19.5
1/2 Girth	39.45
Length as per Rule	83.99
	20199.595

1/2 Girth	= 39.7
1/2 Breadth	= 19.0
Depth	= 25.8
	= 84.5
	= 22.0
	= 169.00
	= 169.01
	= 185.91.0
	= 84.5 + 185.91

- Anchors & Chains
- 2 Bower 36 1/2 L
  - 1 " " 31 L
  - 1 " " 14 L
  - 1 " " 7 L
  - 1 " " 3 1/2 L
- 270 fathoms of 1 1/2" cable tested to 1 1/2"  
 90 " " of 1 1/2" stoway chain

Stanchions 3 1/2

Note: The angles & bolts in this vessel will either be the size shown on this section or equivalent in weight.

18th  
 15/2/73  
 Littered the Surveyor  
 Sunderland 15/2/73

J.W. MOUNSEY & CO  
 IRON SHIP BUILDERS  
 SOUTH DOCK.  
 SUNDERLAND