


"John O. Scott." Report No 12430.

12586 Iron

90A - Numerals  $\frac{59.45}{12.781}$   
Rec 10/11/73 M

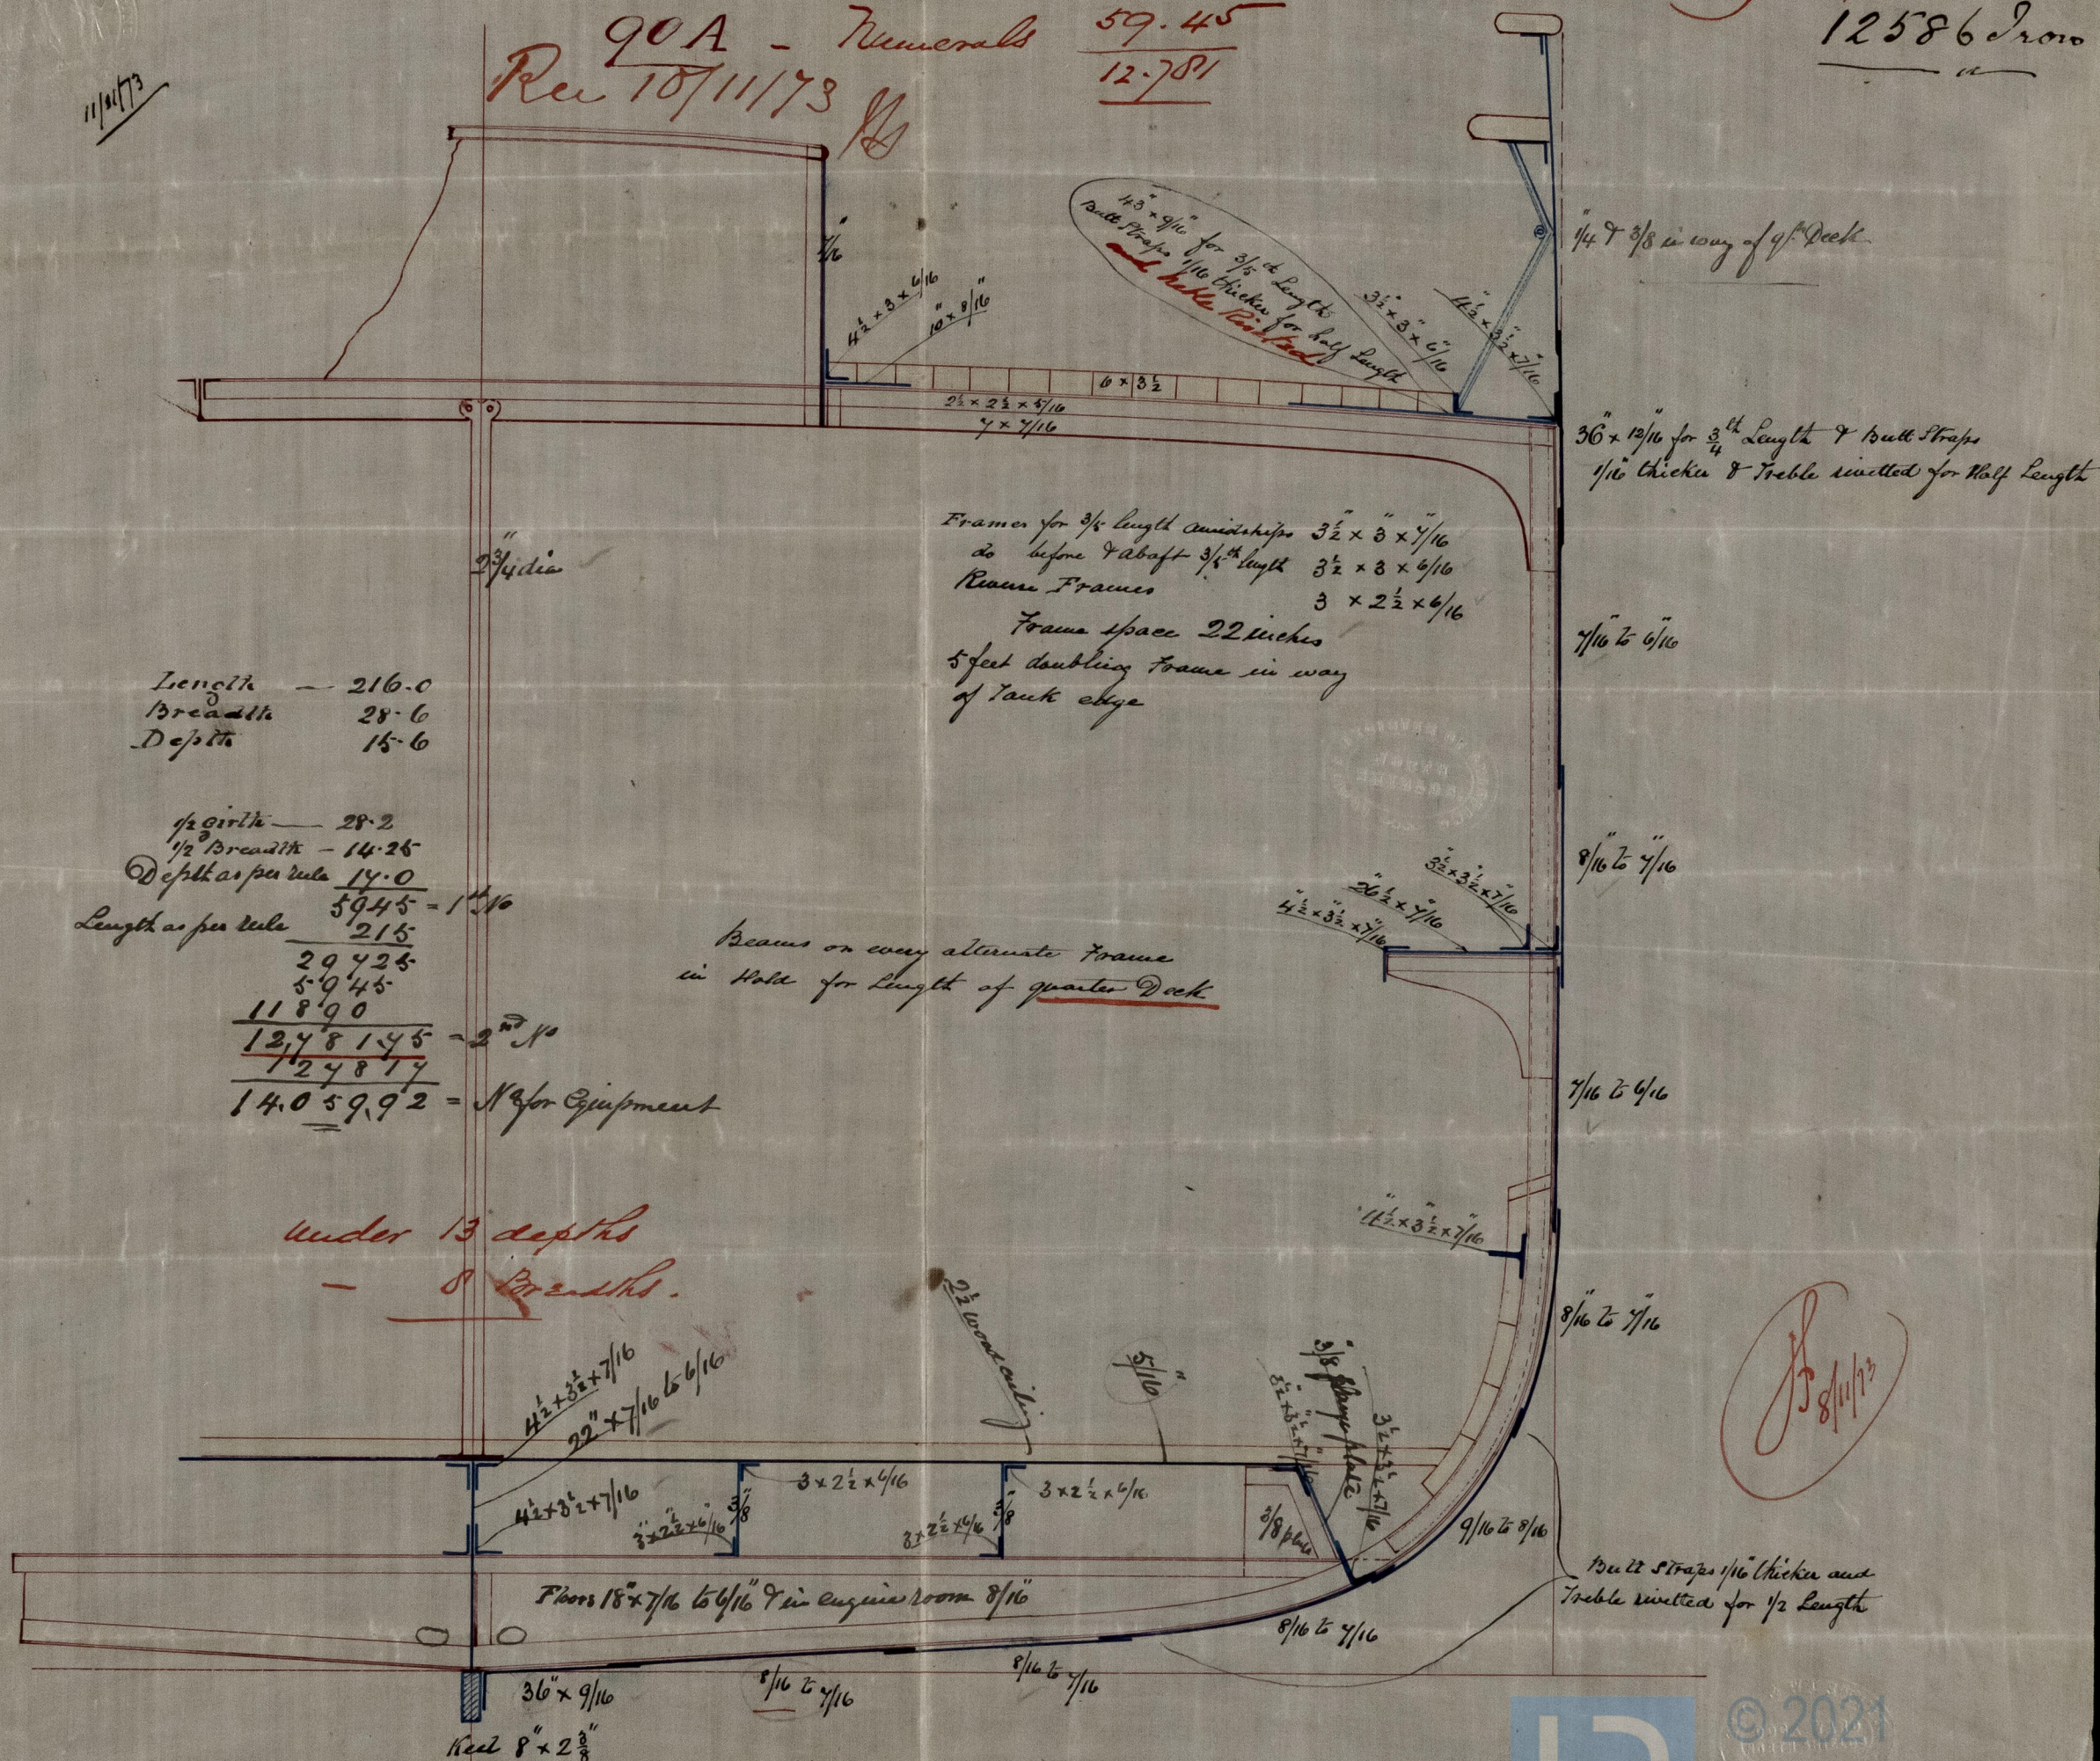

under 13 depths  
— 8 Breaks.

Length — 216.0  
Breadth 28.6  
Depth 15.6

$\frac{1}{2}$  Girls — 28.2  
 $\frac{1}{2}$  Breadth — 14.25  
 Depth as per rule 14.0  
 Length as per rule  $\frac{5945}{215} = 1^{11}\frac{1}{10}$   
 $\frac{29425}{5945}$   
 $\frac{11890}{12,781.45} = 2^{2}\frac{1}{10}$   
14.059.92 =  $N^o$  for Equipment

Beams on every alternate frame  
in Hold for Length of quarter Deck

RM  
11/11/73