Ship "Mairi Bhan" Glasgow Report No 3811

Midship Section of Ship

No 242

Scale 1/2 Inch to a Foot

To Class 100 A. in Lloyds.

Must be altered by tonnage instead of numeral.

Dimensions by Lloyds

Length	224 now lengthened 228 f-6	Half Breadth	18·25
Breadth	36·5	do Girth	37·05
Depth of Hold	22·46	Depth to top of Keel	24·50
			79·80 = Numeral.

Rec. 16/9/73 & 26/11/73

Proportions

Beams. ~~6·13~~ 6.24

Depths. ~~4·97~~ 4·30

79·8 × 228 18194 / 1819 / 20·013. Equipmal

79·8 × 224 = 17,875·20 = Numeral
add 1/10 1787·5
19,662·7 = Equipment Numeral

Equipment. (Under 1400 tons Gross)

1 Bower anchor.	32 Cwt ex stock	Best	$30\frac{2}{20}$ tons
2 do anchors	of 59¼" agregate Wt		
1 Stream anchor.	13 " with Stock		
1 Kedge do	6½ do		
1 Kedge do	3¼ do.		
270 fhs	$1\frac{3}{16}$ Stud-chain cable.	"	$59\frac{2}{20}$
90 fhs	1" Stream chain or 10" Rope.		
90 fhs	9½" Hawser		
90 fhs.	6" Warp		

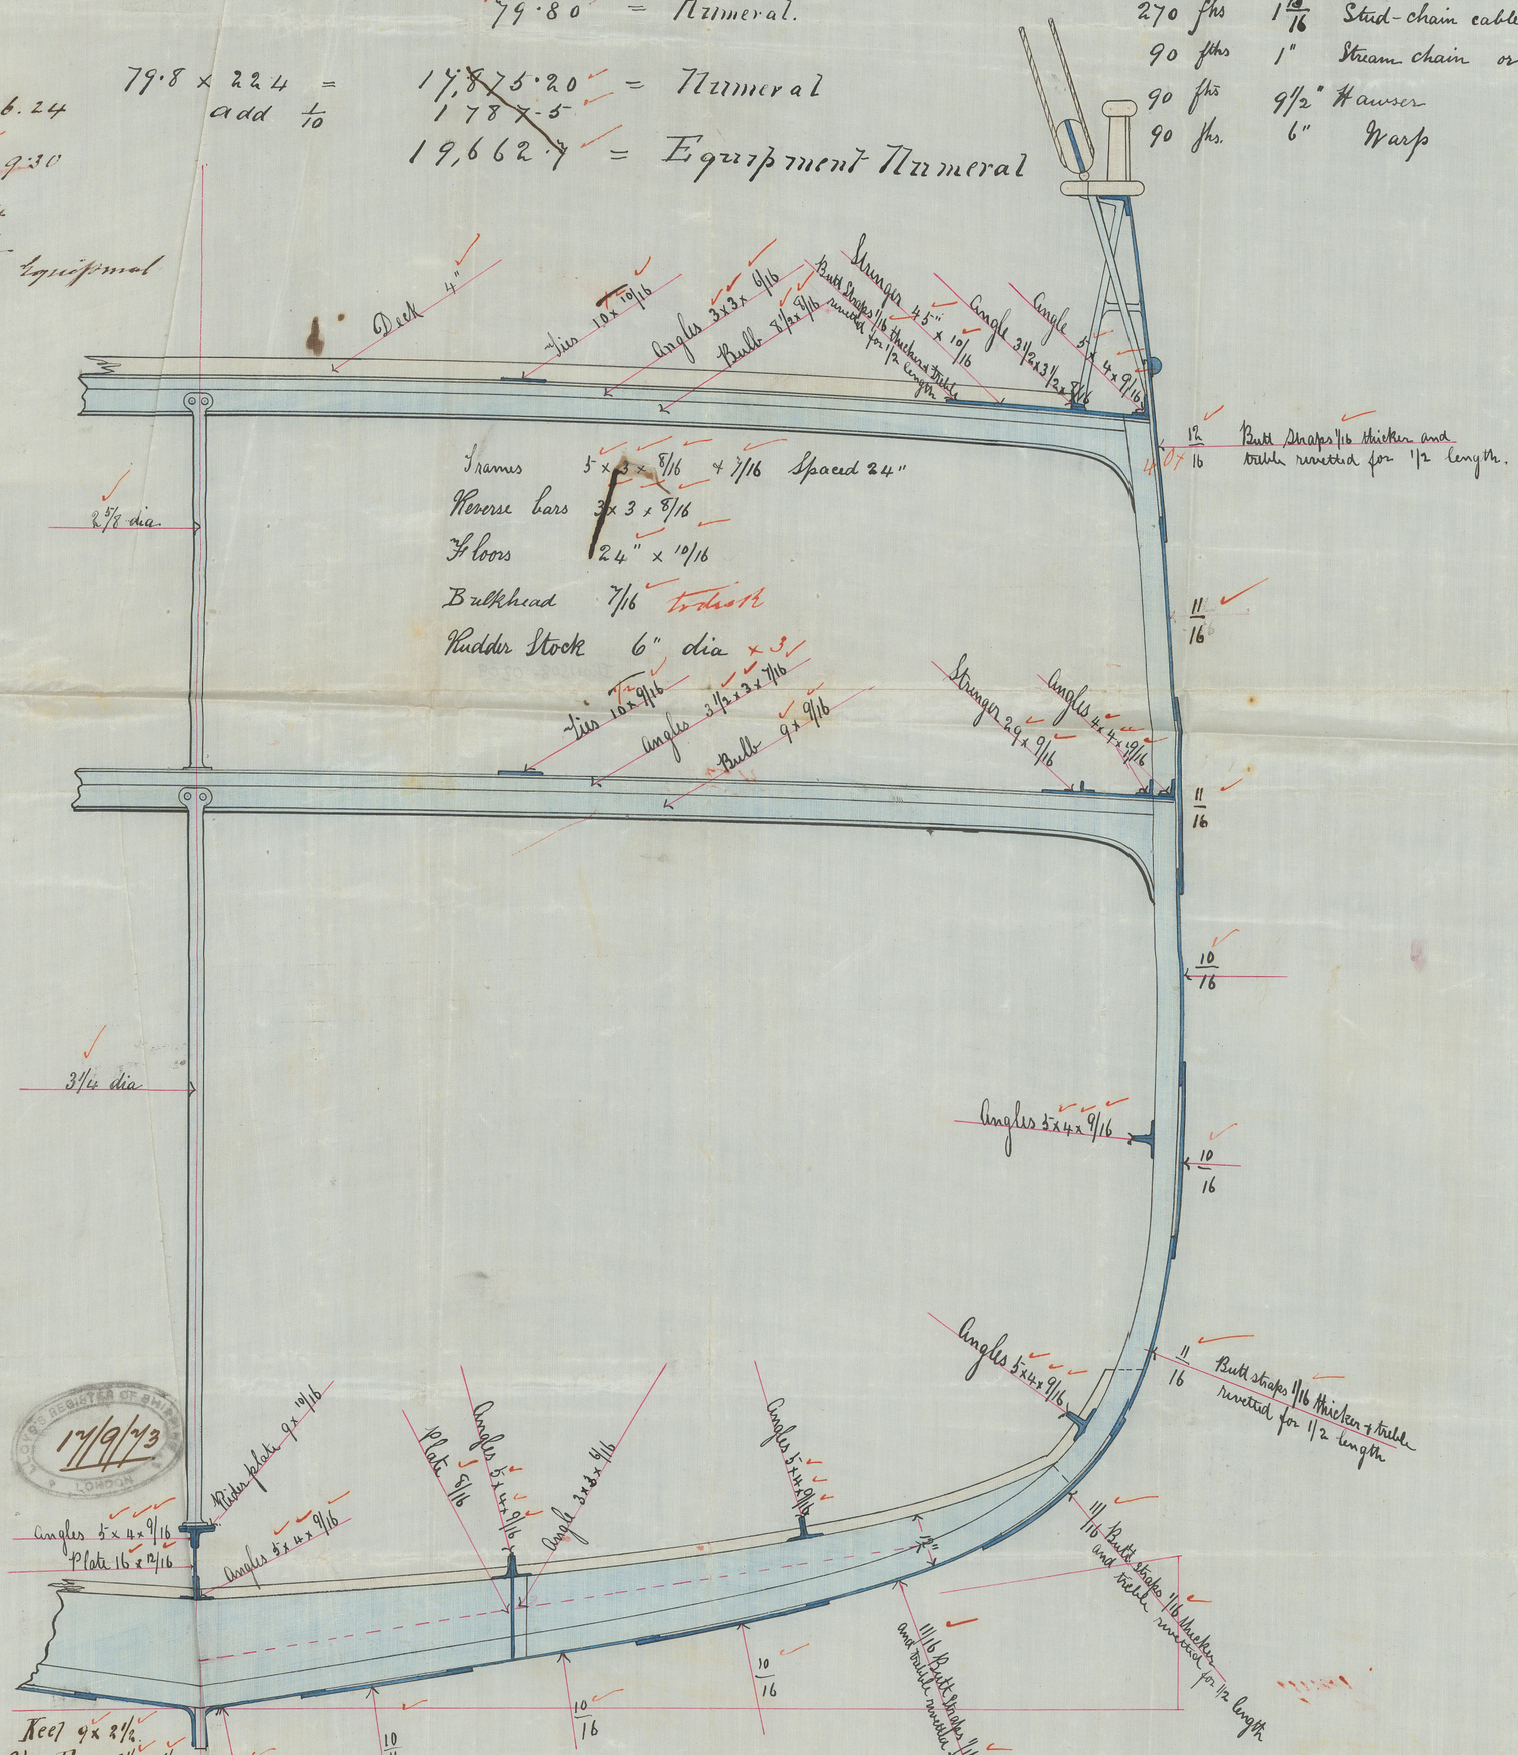

Lloyds Register of Shipping London 17/9/73

Returned to London about output 25/11/73

BMC 17/9/73

WB 15/9/73

BARCLAY, CURLE & Co.
Shipbuilders & Engineers
GLASGOW.

© 2021 Lloyd's Register Foundation

12591. Iron.

© 2021 Lloyd's Register Foundation

IRON508-0209