

Half Breadth 19.0  
 Depth to Keel 24.8  
 Half Girth 37.7  
 Length 81.5  
 22.5  
 10,337


Class 100A

Ship "Rodney" Report No 10,843

Proportions.  
 Under 6 breadth and 10 depth.

No 234  
Scale 1/2" = 1 foot

Stops 1/2" and 1/4" in 2  
lengths table rivets

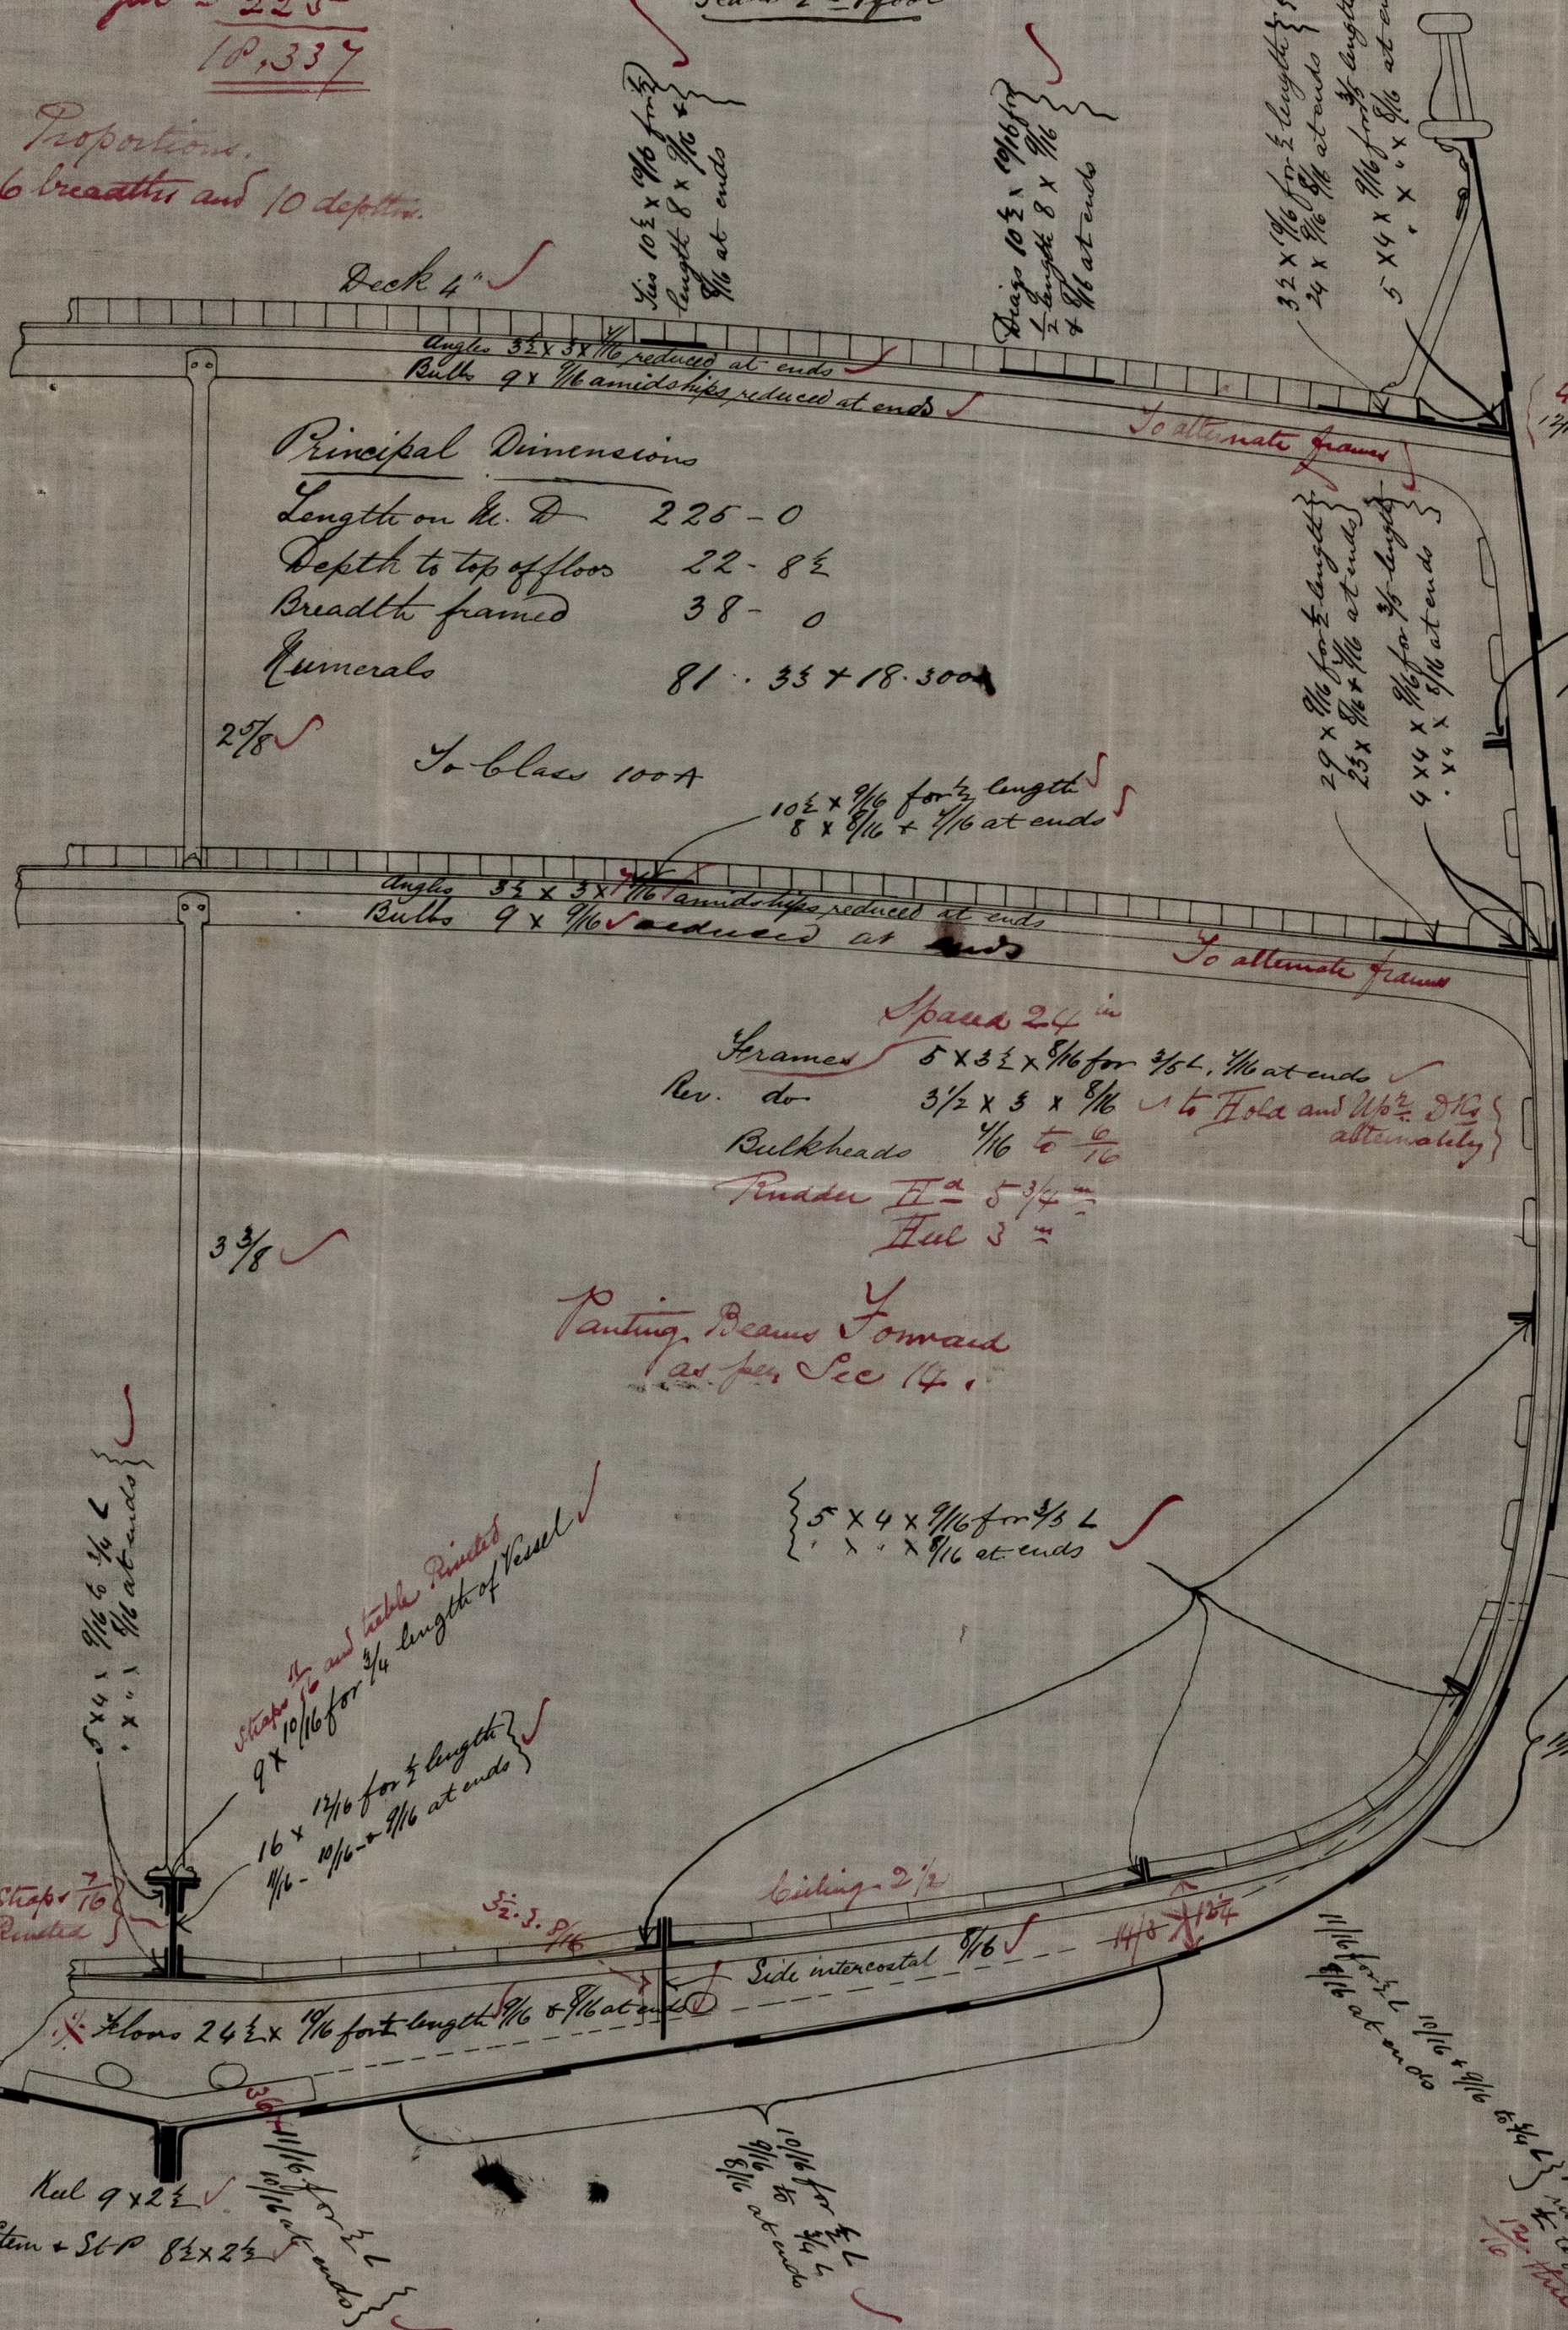

Principal Dimensions

Length on keel 225-0  
 Depth to top of floor 22-8 1/2  
 Breadth framed 38-0  

To class 100A

Spaced 24 in

 Rudder 5 3/4  
 Hull 3

Pasting Beams Forward  
 as per Sec 14.

No 234

Scale 1/2" = 1 foot



© 2021

Lloyd's Register Foundation

IRONS08-0213