

Palmer Shipbuilding & Iron Co  
Limited  


January 31 1874.

13.274

# Midship Section

S.S. "Dorley" (  $\frac{705}{534}$  tons ) Tonnage now  $\frac{950.13}{700.20}$   
Scale  $\frac{1}{2}$ " = One Foot.

To be lengthened 30 feet - INCREASING TONNAGE  
143 1/2 TONS  
Rec 10/2/74 & 12/3/74  
LL

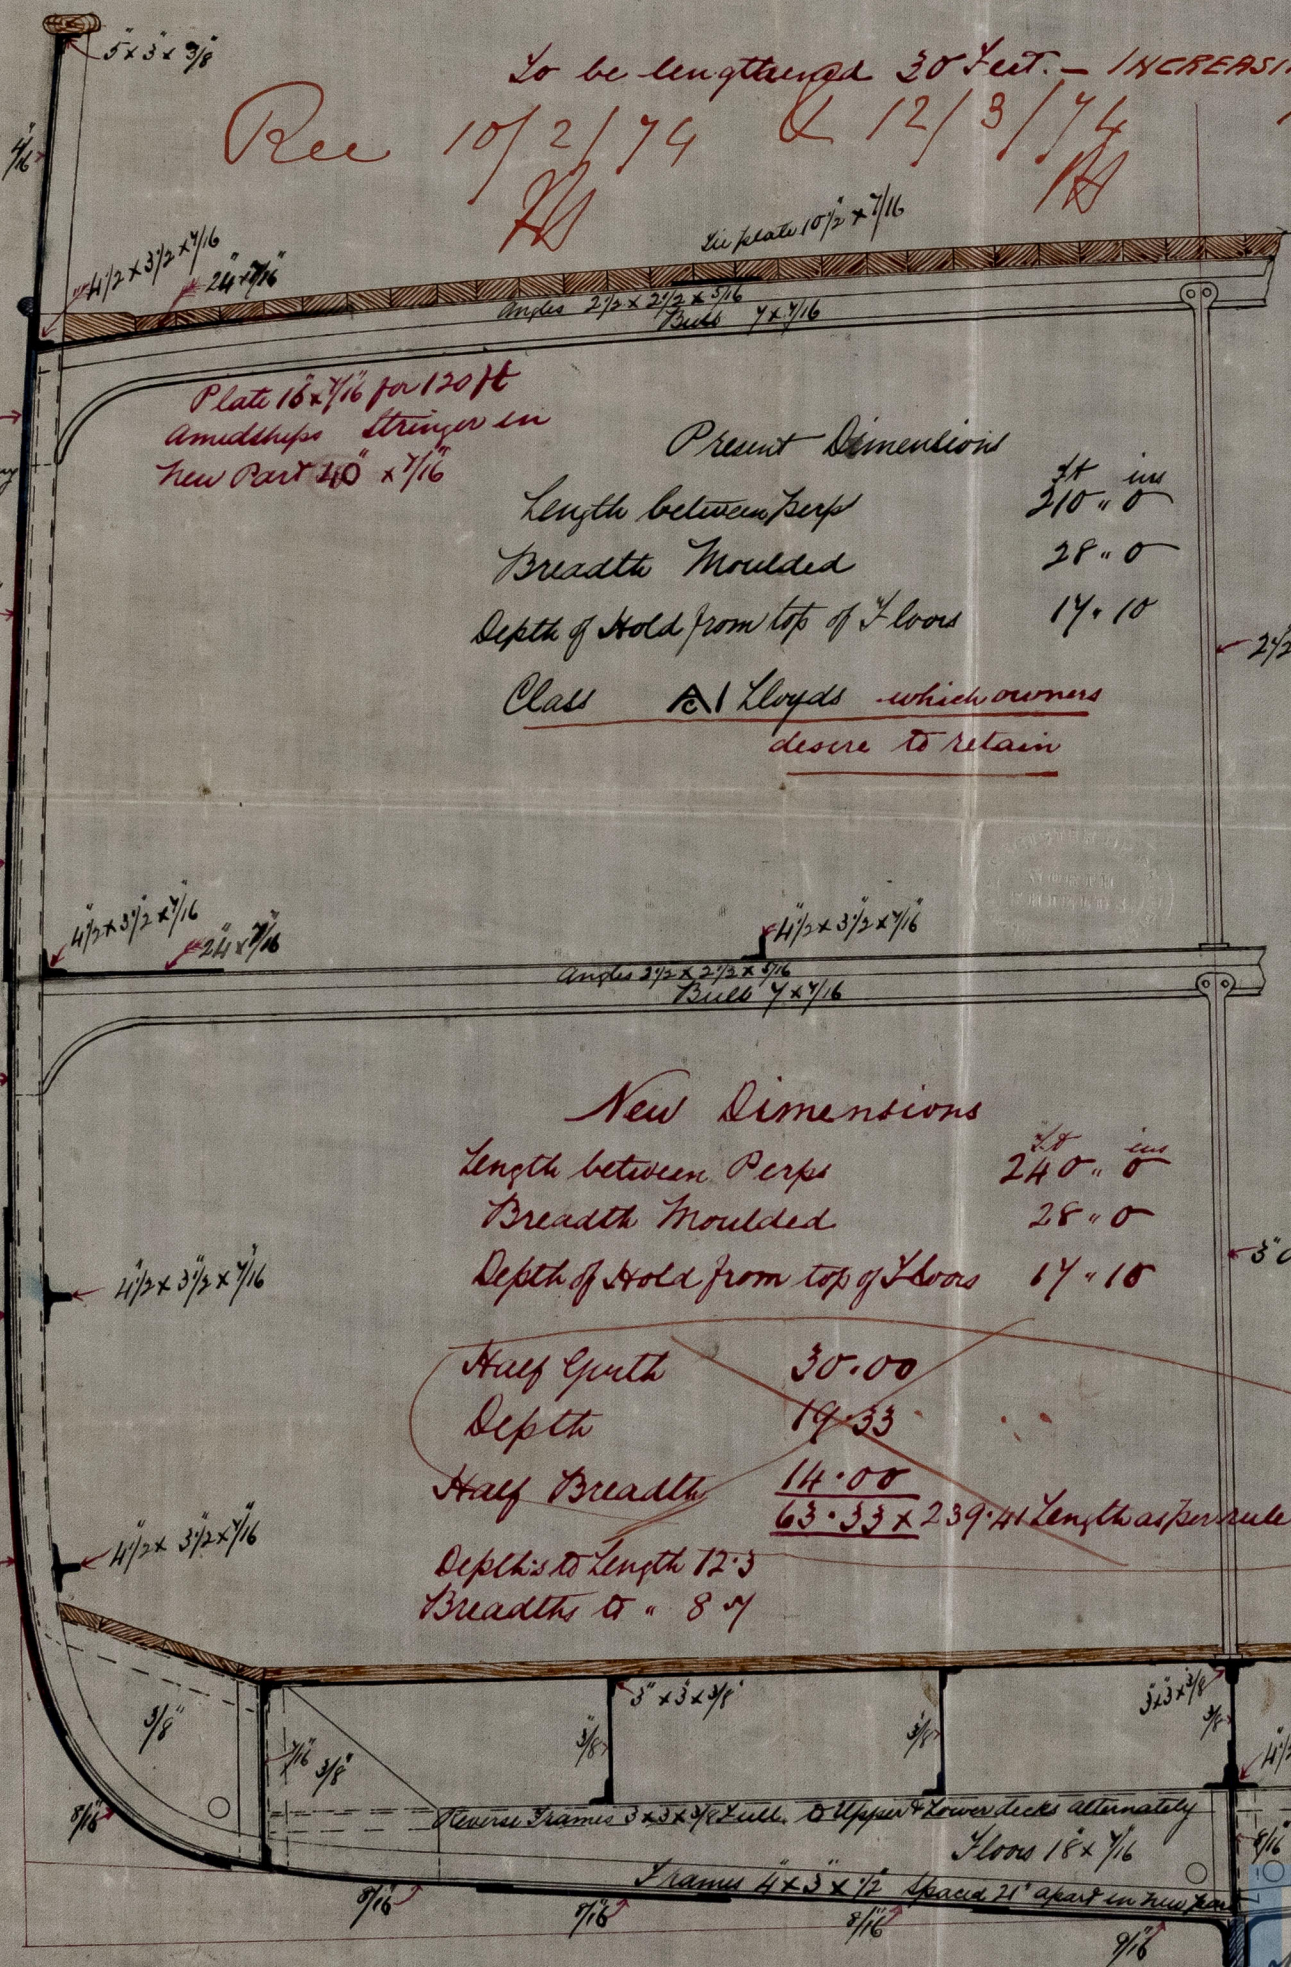

Present Dimensions  
Breadth Moulded 28' 0"  
Depth of Hold from top of Floors 14' 10"  
Class A1 Lloyds which owners  
desire to retain

New Dimensions  
Length between Perps 240' 0"  
Breadth Moulded 28' 0"  
Depth of Hold from top of Floors 14' 10"  
Half Girth 30.00  
Depth 14.33  
Half Breadth 14.00  
63.33 x 239.41 Length as per rule = 15,161.  
Depth to Length 12.3  
Breadth to " 8.7

© 2021  
Lloyd's Register  
Foundation  
13/2/74



12612 Jan.

82.00  
200.50




© 2021

Lloyd's Register  
Foundation

IRON 508-0220