
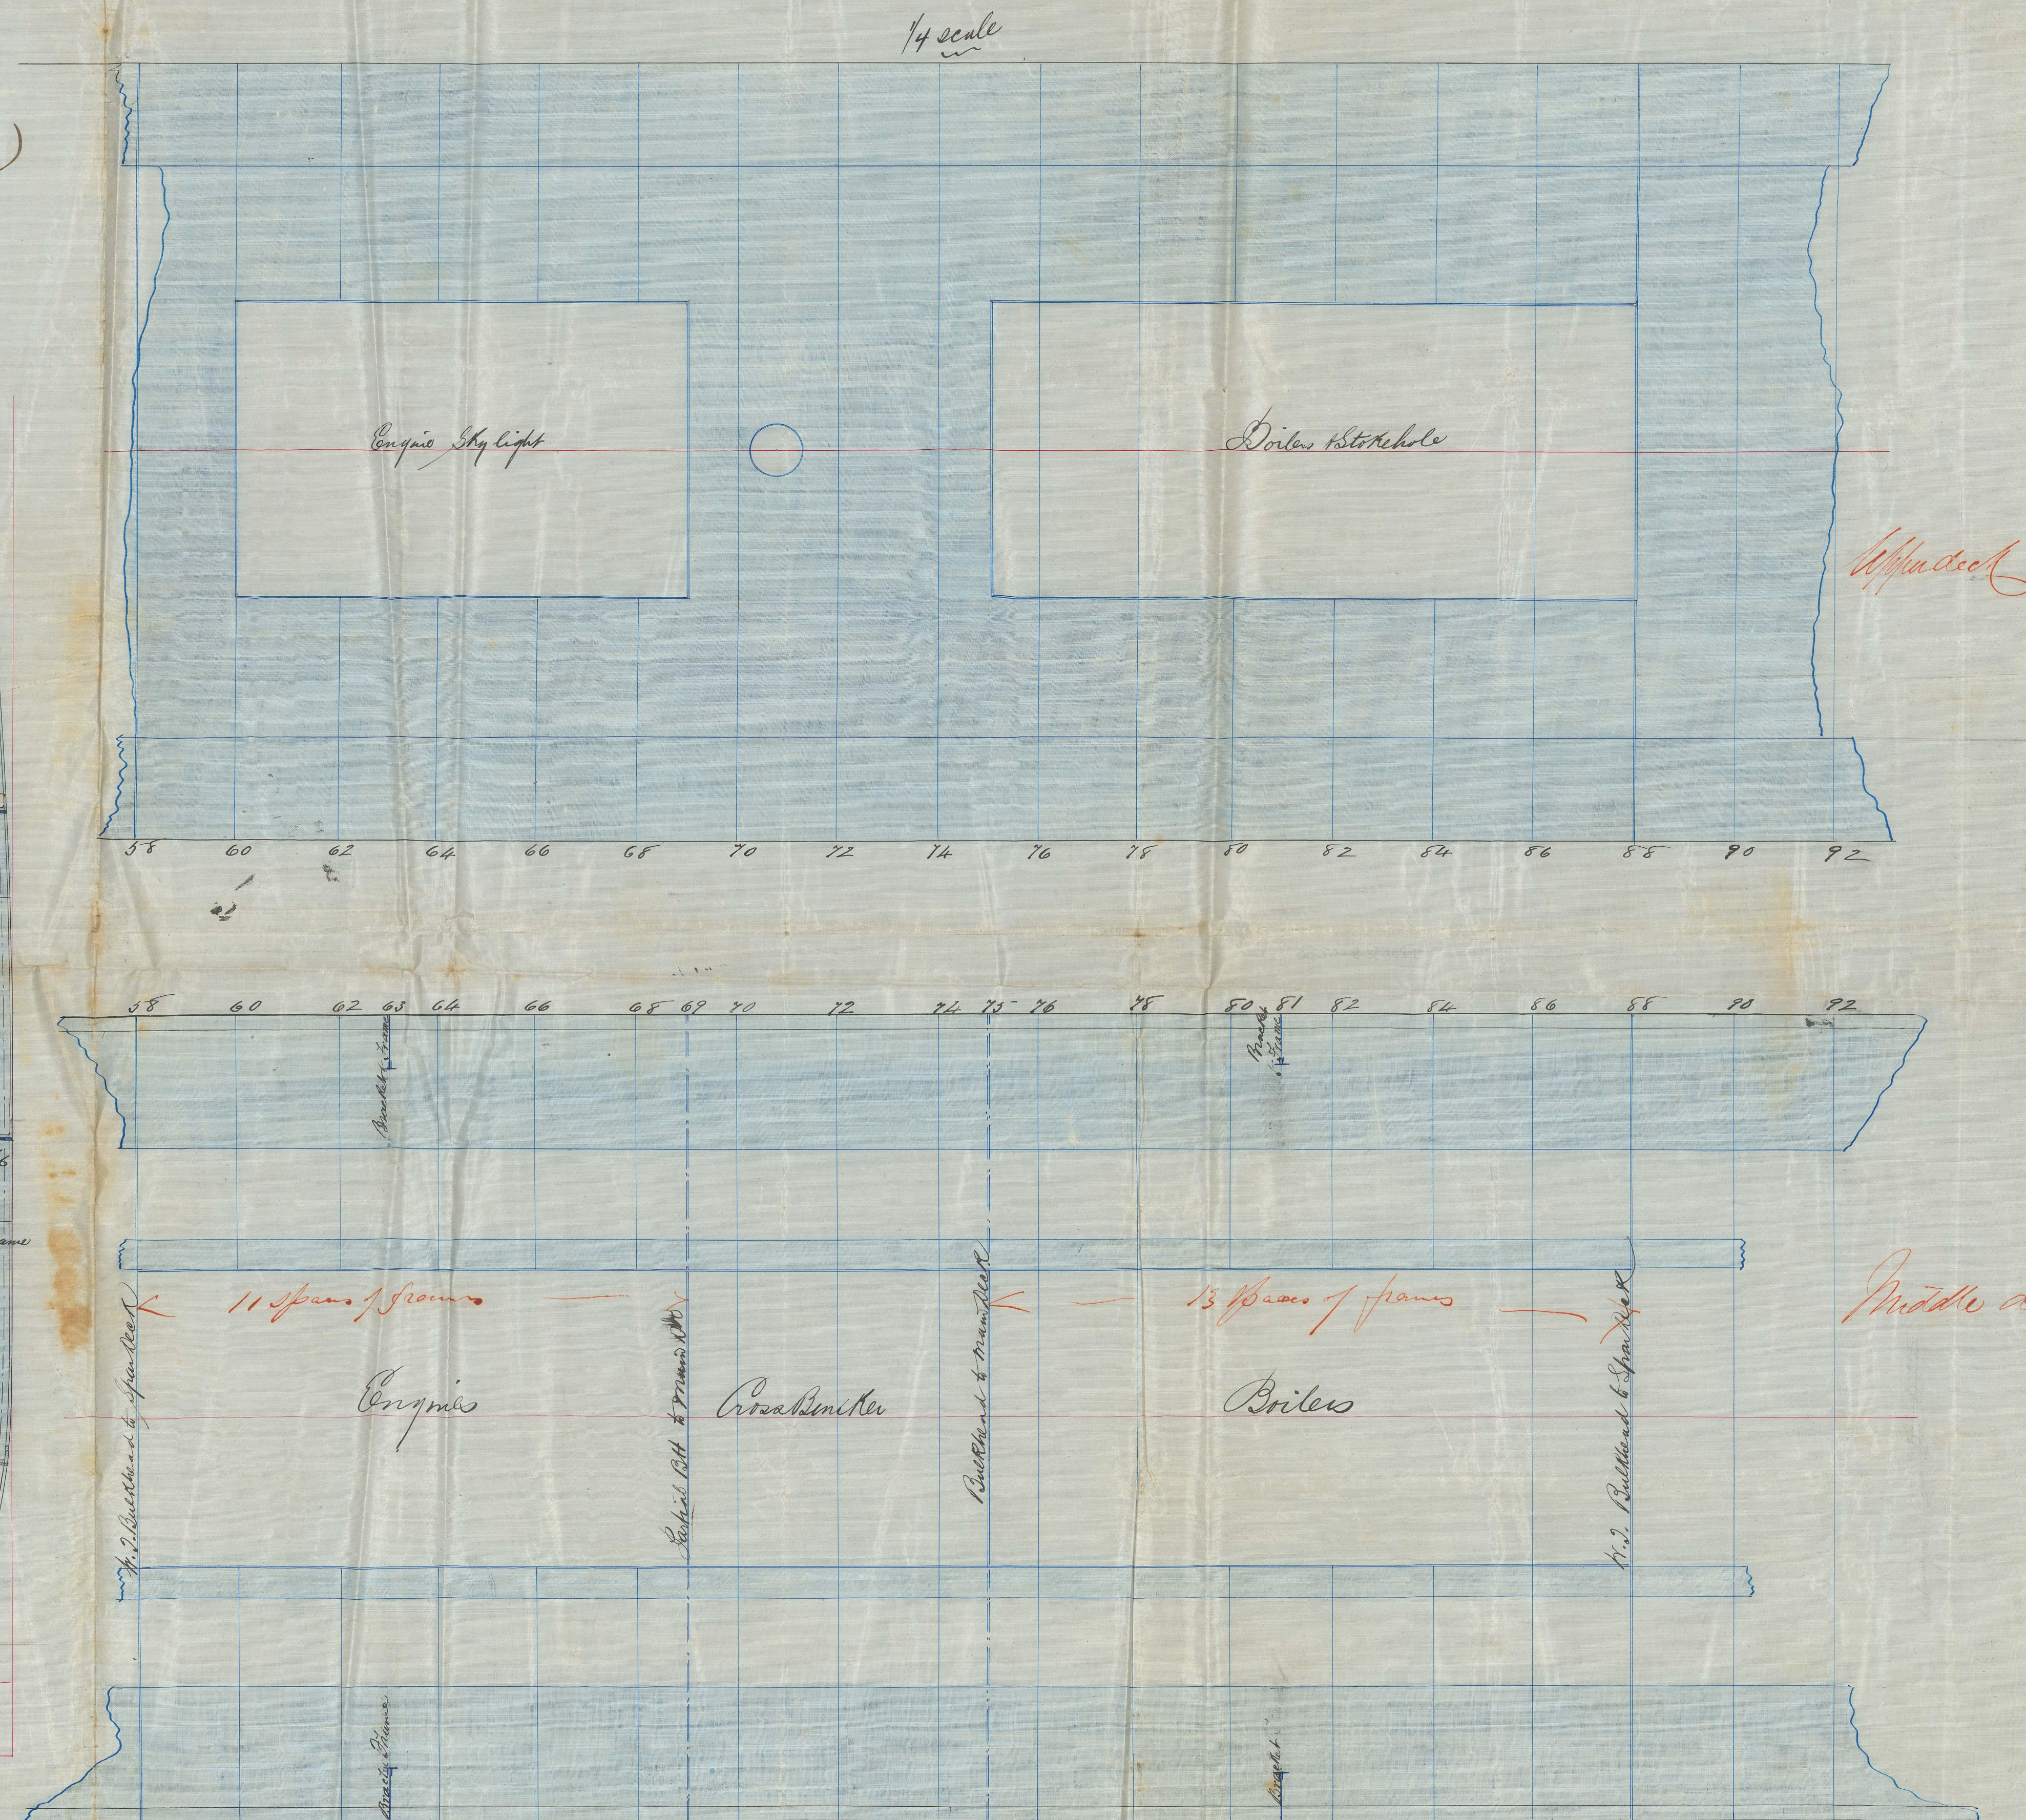


Sketch showing proposed strengthening
in Engine & Boiler Rooms
S.S. Africa (and Whispie)
S.S. 172-73
Specimen No 3541
Per 18/8/73

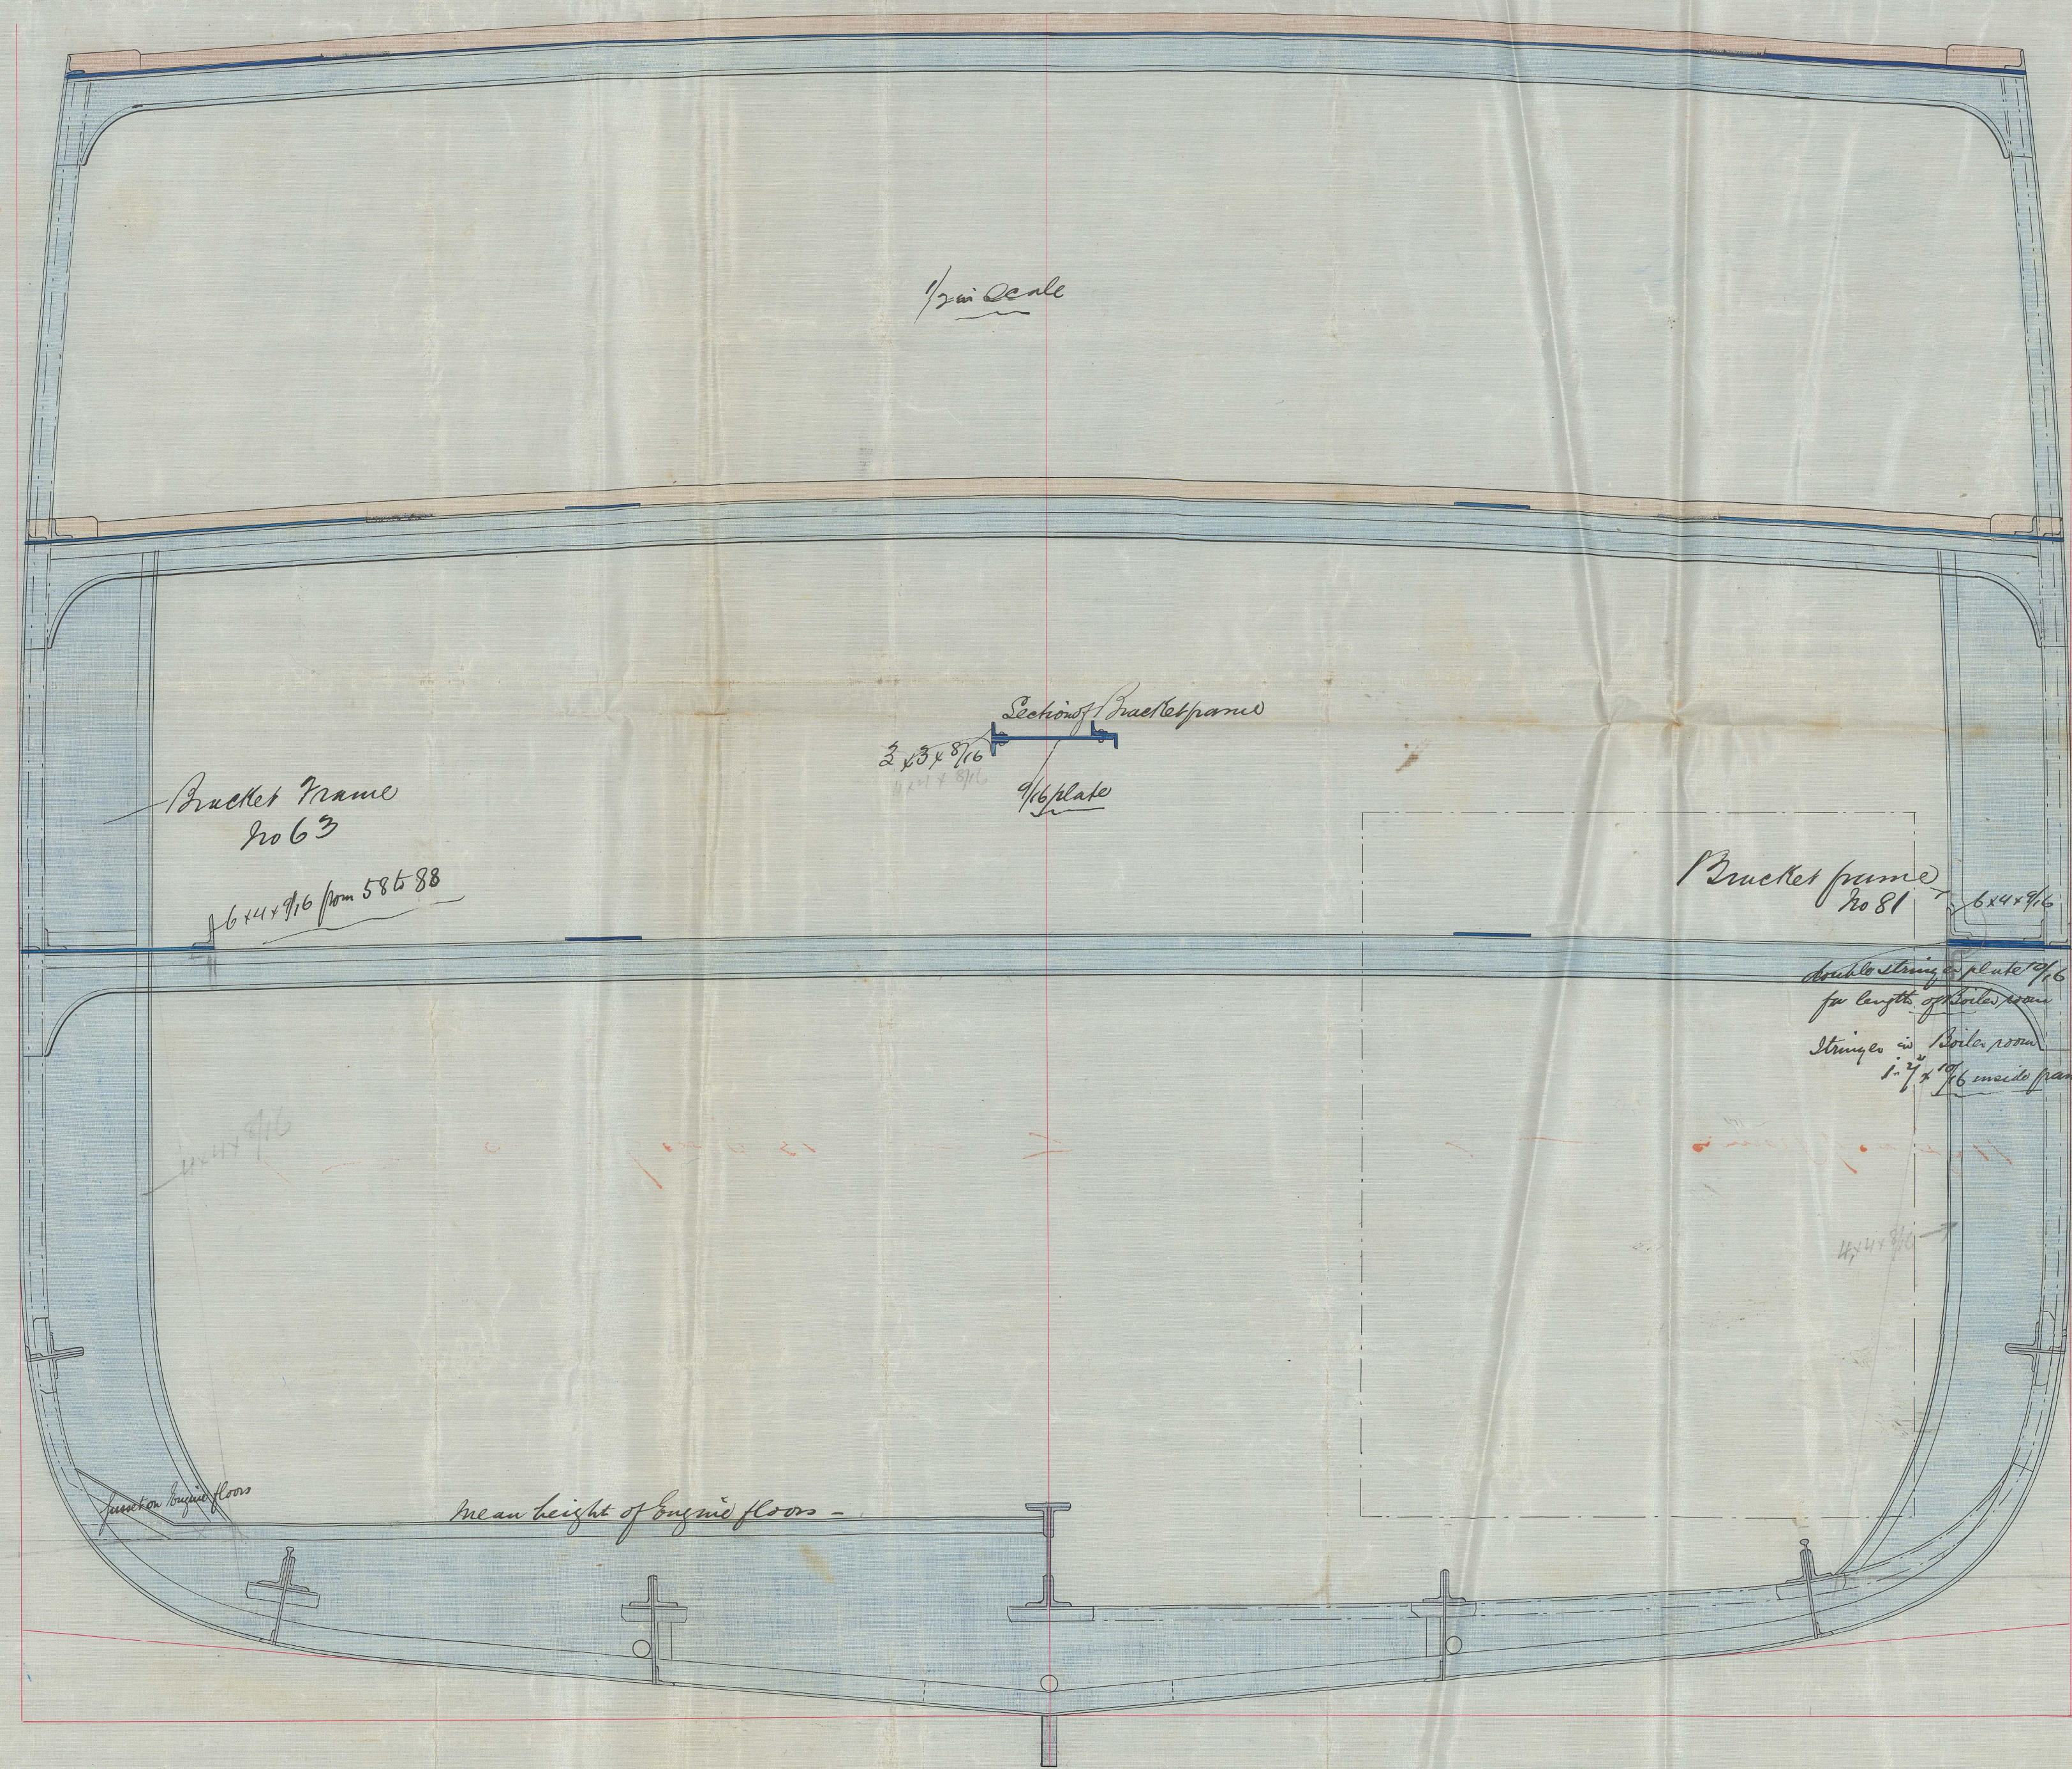

W. DENNY & BROS.
IRON SHIPBUILDERS
DUMBARTON.

19/8/73

19/8/73

12732 Iron



© 2021

Lloyd's Register
Foundation

IRON SUB-0250