12785 Iron

Glasgow Report No. 2825

Midship Section of S.S "Celt"

Scale 1/4" = 1 foot

Rec 22/5/73 10/6/73

Dimensions when Lengthened 50 feet will be
Length 310·5
Breadth 34
Depth 27·5

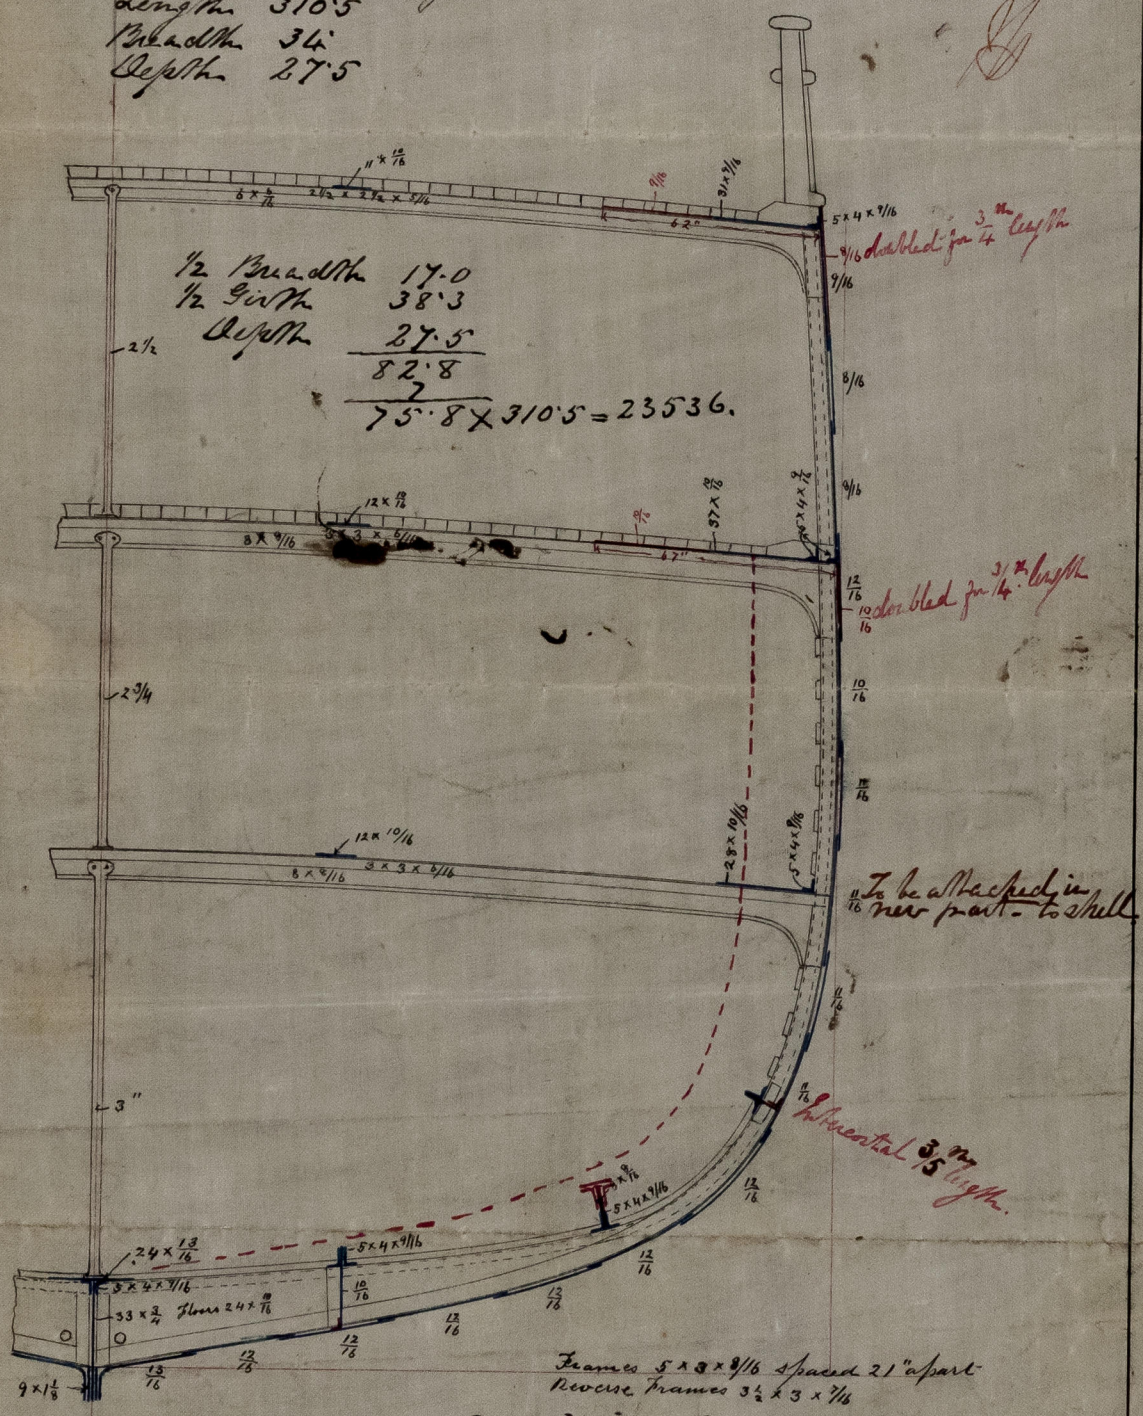

A & J. Inglis
ENGINEERS & SHIPBUILDERS
GLASGOW

Proposed additions in Red.
Keelson Angle iron in lengthened part to be as per rule.

May 20th 1873

26/5/73

IRONS08-0274

10/6/73

© 2021 Lloyd's Register Foundation