



Rec 26/1/74

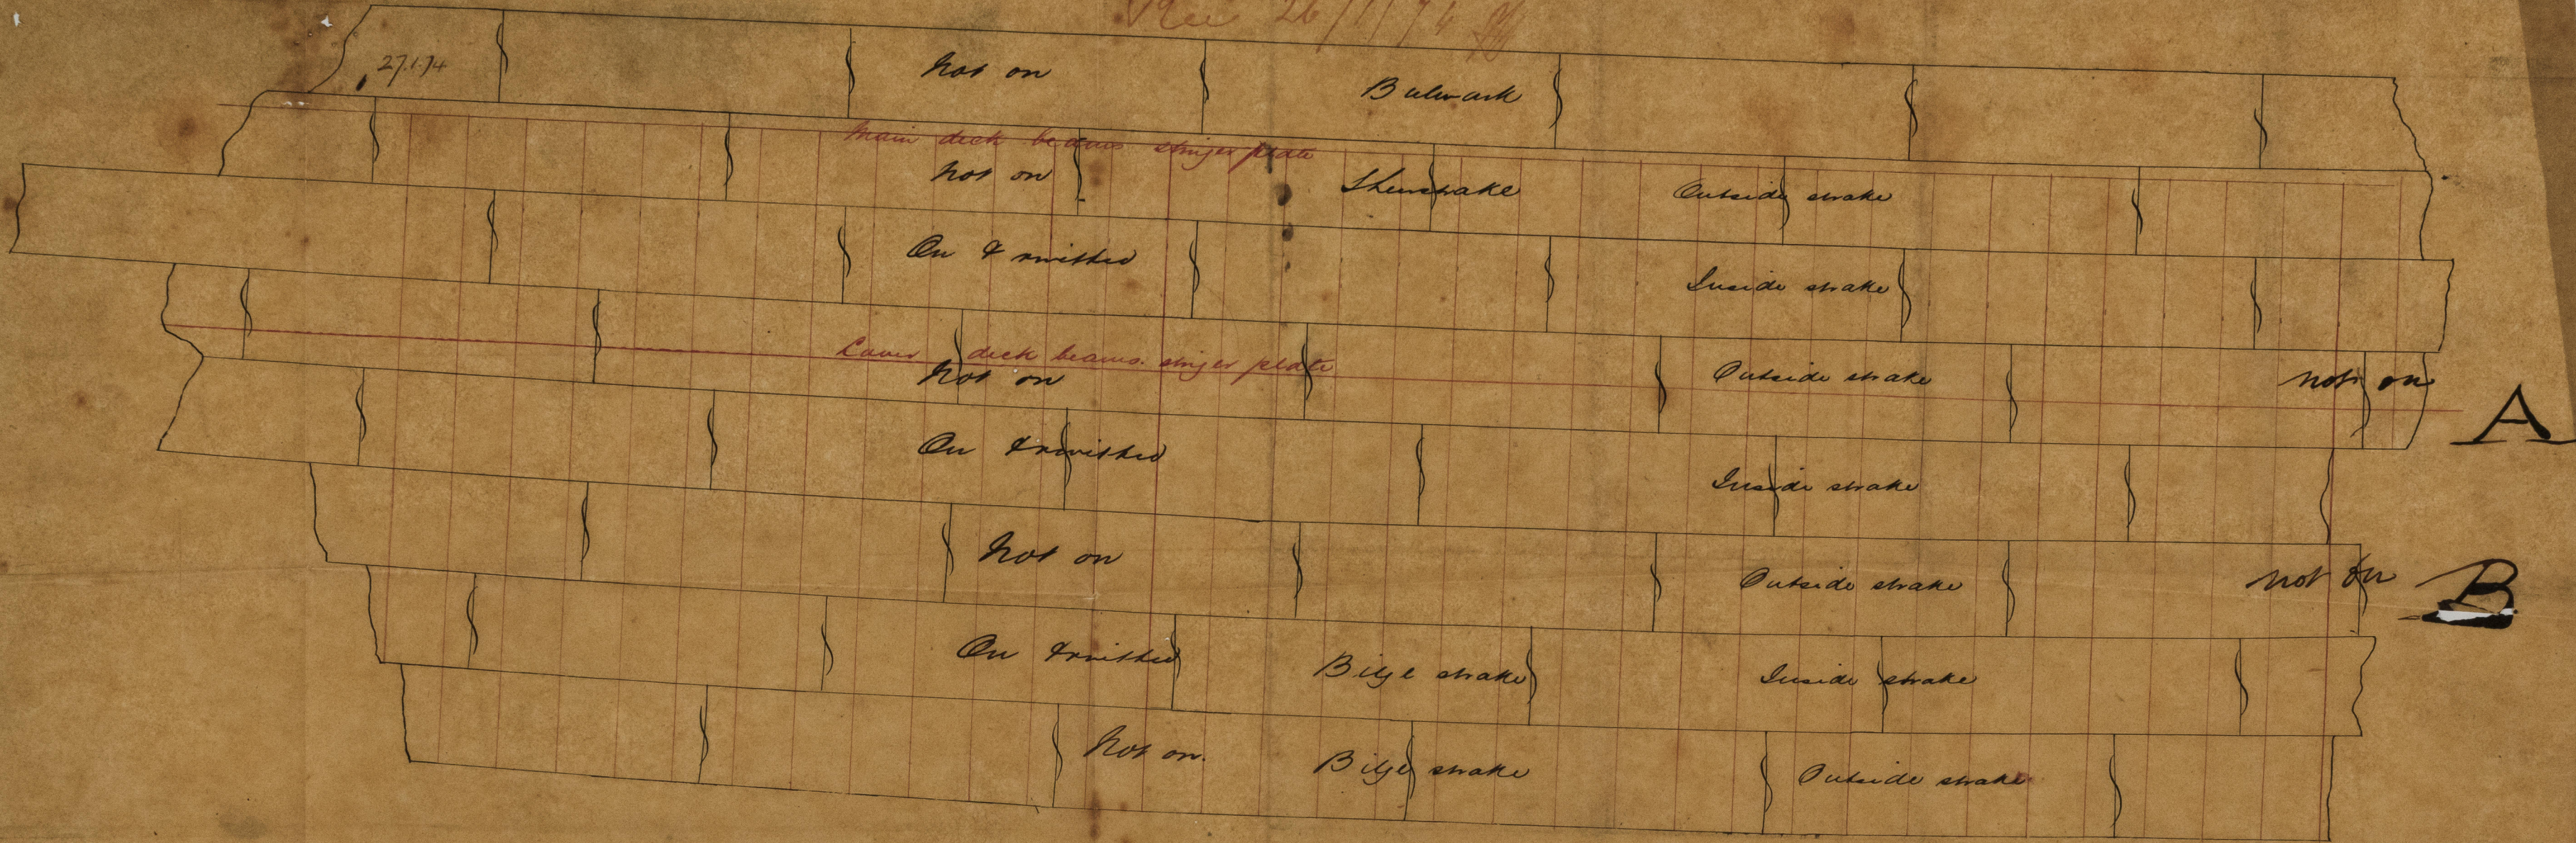

6 frame plates. all butts 2 frame spaces clear.

No. 235
Scale 1/4" = 1 foot.

H. Graham
Receiver of
W. Pile Ho's Estate.

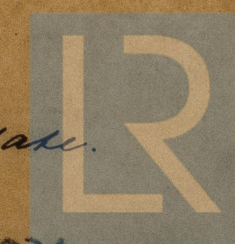

© 2024
Lloyd's Register
Foundation

IRON509-0026

1870
26/1/74