

Half-Breast 19.9
Deep to Keel - 25.9
Half Girth - 39.9
1st 2nd = 85.7
Length - 24.6
2nd 2nd 21.082

Proportions
width & breadth
and 10 depths

May 18

$$\begin{aligned} & \sqrt{\frac{1}{2}} \times \sqrt{\frac{1}{2}} \times 9 \\ & \sqrt{\frac{1}{2}} \times \sqrt{\frac{1}{2}} \times \frac{9}{16} \times 36 \\ & \dots \times \dots \times \frac{9}{16} \text{ at } n \end{aligned}$$

Double Butt shape
9/16" thick table riveted

Moulded at
4 1/4" x 7" from
Mind Line
123

Floor
9/16"

Kul 9 1/2 x 2
Stem 1 1/2 post 4

Principal Dimensions

Length on Main Deck 246.0'
Breadth frames 39.10
Depth to top of keel 25 24.11 1/2
Girth of midship frame 39.11
Gunwales 85.8' between 18400 & 24400

11 x 9/16 in $\frac{1}{2}$
length - 8 x 9/16
8 x 9/16 at ends

Days in way
of forward
mainmast
11 x 9/16

Angles $3\frac{1}{2} \times 3\frac{1}{2} \times \frac{1}{16}$ anniships ✓ $3 \times 3 \times \frac{1}{16}$ at ends
Bolts $9\frac{1}{2} \times \frac{1}{16}$ anniships ✓ $8 \times \frac{1}{16}$ at ends

Frames for 3/8 length $5 \times 3\frac{1}{2} \times \frac{9}{16}$ ✓ 1 spaced $2\frac{1}{4}$ in
 " at ends $5 \times 3\frac{1}{2} \times \frac{9}{16}$ ✓
 Runners Bars $3\frac{1}{2} \times 3\frac{1}{2} \times \frac{9}{16}$ ✓ to Main and
 Bulkheads $\frac{9}{16}$ ✓ to $\frac{9}{16}$ Lower St. St.
 Rivets at Head 6 in or less $3\frac{1}{4}$ in

$5\frac{1}{2} \times 4 \times \frac{9}{16}$
 $\{ 5 \times 4 \times \frac{9}{16} \text{ for } \frac{3}{5} \text{ length}$
 $\quad \cdot \times \cdot \times \frac{9}{16} \text{ at ends}$

40 in wide by
 $\frac{13}{16}$ for $\frac{1}{2}$ length
 $\frac{12}{16} - \frac{1}{16} + \frac{1}{16}$ } Butte tape miked } $\frac{14}{16}$ for $\frac{1}{2}$ length
 at ends. } for $\frac{3}{4}$ length.

$\frac{11}{16}$ for 2 length
 $\frac{10}{16}$ & $\frac{9}{16}$ for $\frac{3}{4}$ length } Budd's triple needles }
 $\frac{9}{16}$ at ends } for $\frac{3}{4}$ length }

$\frac{1}{16}$ for $\frac{1}{2}$ length } But the ^{double} ~~length~~ ^{number} ~~is~~
 $\frac{1}{16}$ to $\frac{3}{4}$ " } for $\frac{3}{4}$ length
 $\frac{1}{16}$ at ends } whole length

11/16 for $\frac{1}{2}$ length
10/16 & 9/16 to $\frac{3}{4}$ " }
8/16 at end

$\frac{11}{16}$ for $\frac{1}{2}$ length
 $\frac{10}{16}$ to $\frac{3}{4}$ "
 $\frac{9}{16}$ at end

$\frac{11}{16}$ for $\frac{1}{2}$ length } Butts triple malle)
 $\frac{10}{16}$ & $\frac{9}{16}$ to $\frac{3}{4}$ " } for $\frac{1}{2}$ length }
 $\frac{8}{16}$ at ends } Straps $\frac{12}{16}$ thick

16 for $\frac{1}{2}$ length
& 10 16 to $\frac{3}{4}$ "
at ends

Butts triple marked
for $\frac{1}{2}$ length
Shape $\frac{13}{16}$ pict.

1/3

For the triple marked

No 236
Scale $\frac{1}{2} =$



ed sections

IRON 509-0029


Amended section
Letter to Sir Raymond
Funderland 1/3/73

© 2021
Lloyd's Register
Foundation

29

IRON 509-0029

12903
Iron

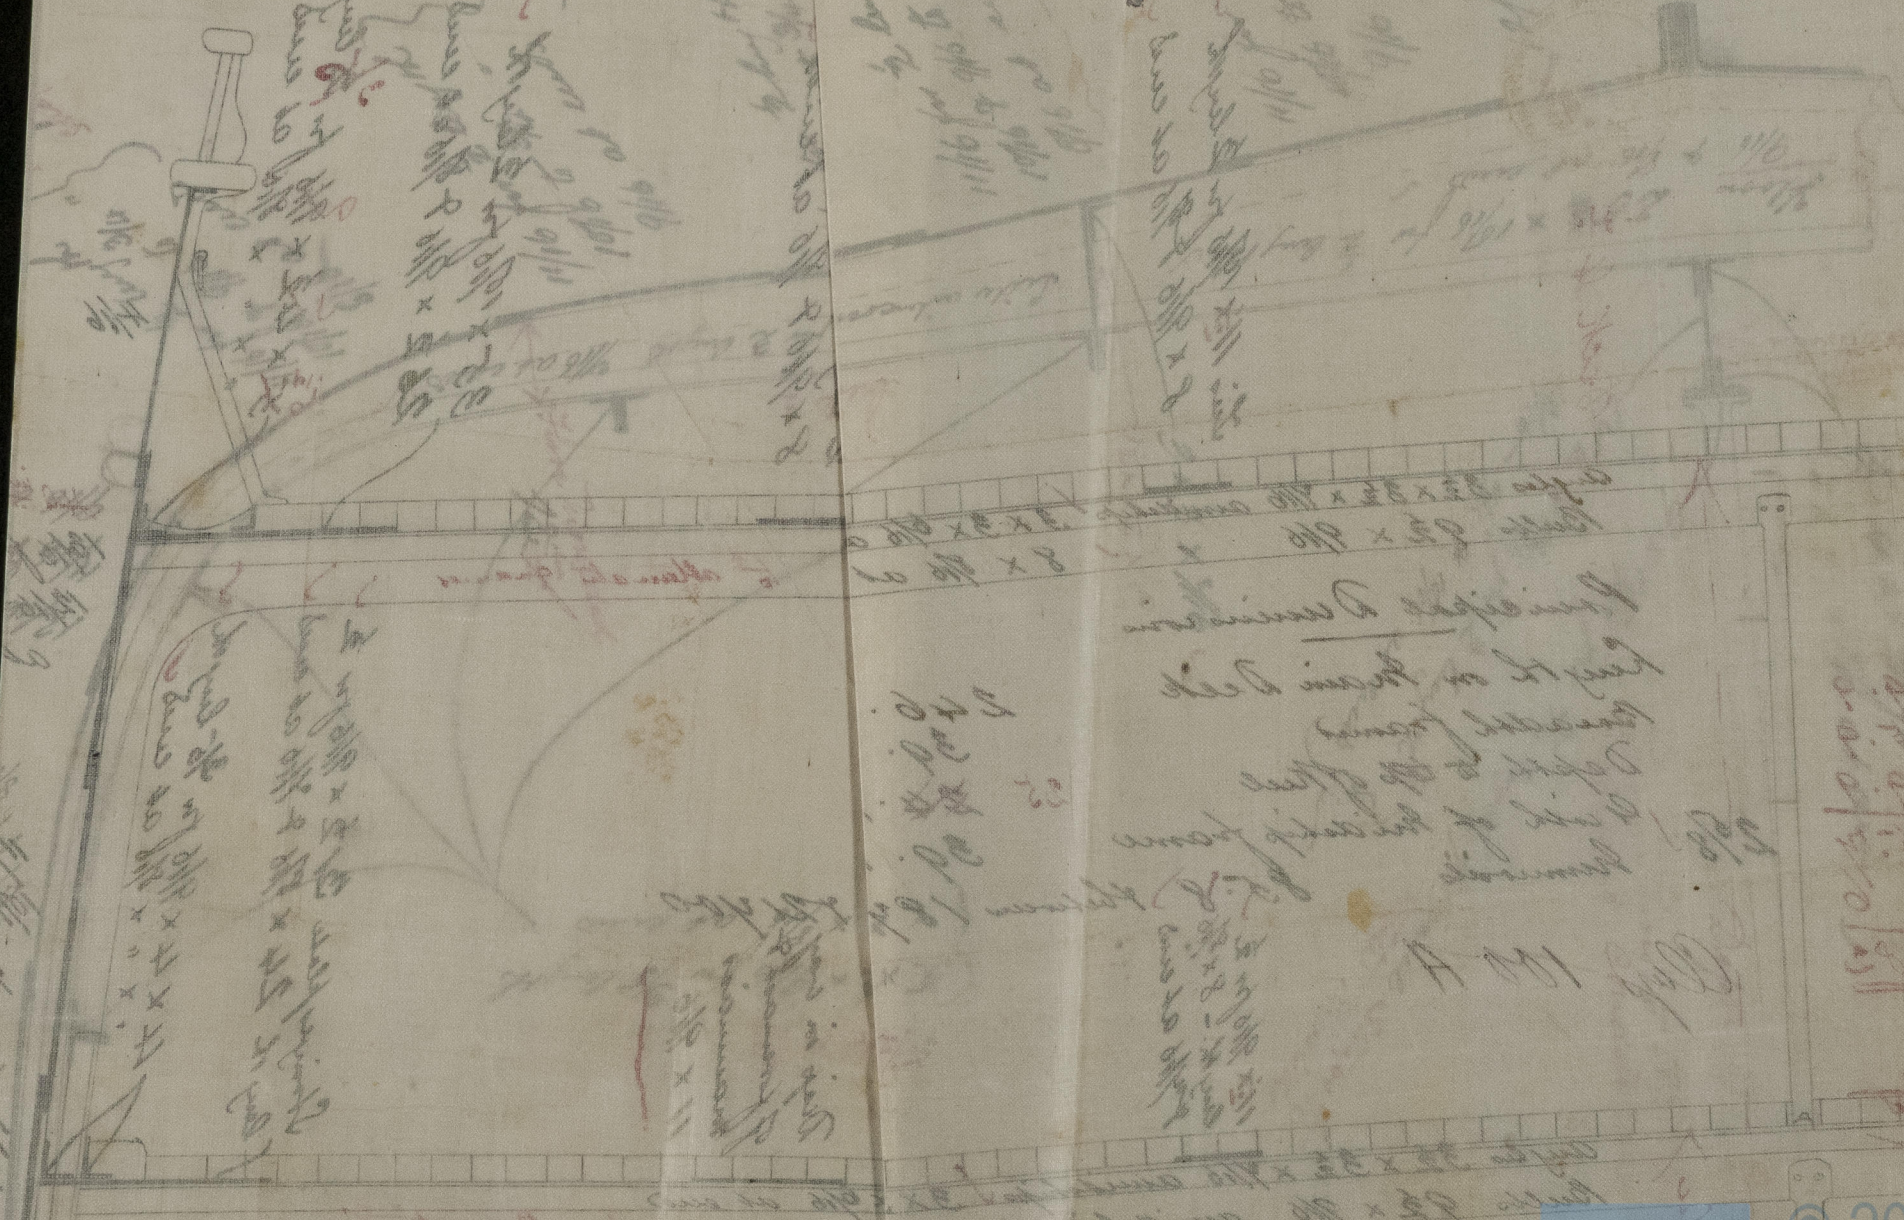

© 2021
Lloyd's Register
Foundation