

18951

mem


IRON 504-003

S.S. "Caroline"

Breadth (moulded)	28.0
Depth (d <sup>o</sup> )	16.6
Register Tonnage	360.8 tons

Rec 29/8/73  
AA

Deck house about 21 ft long.

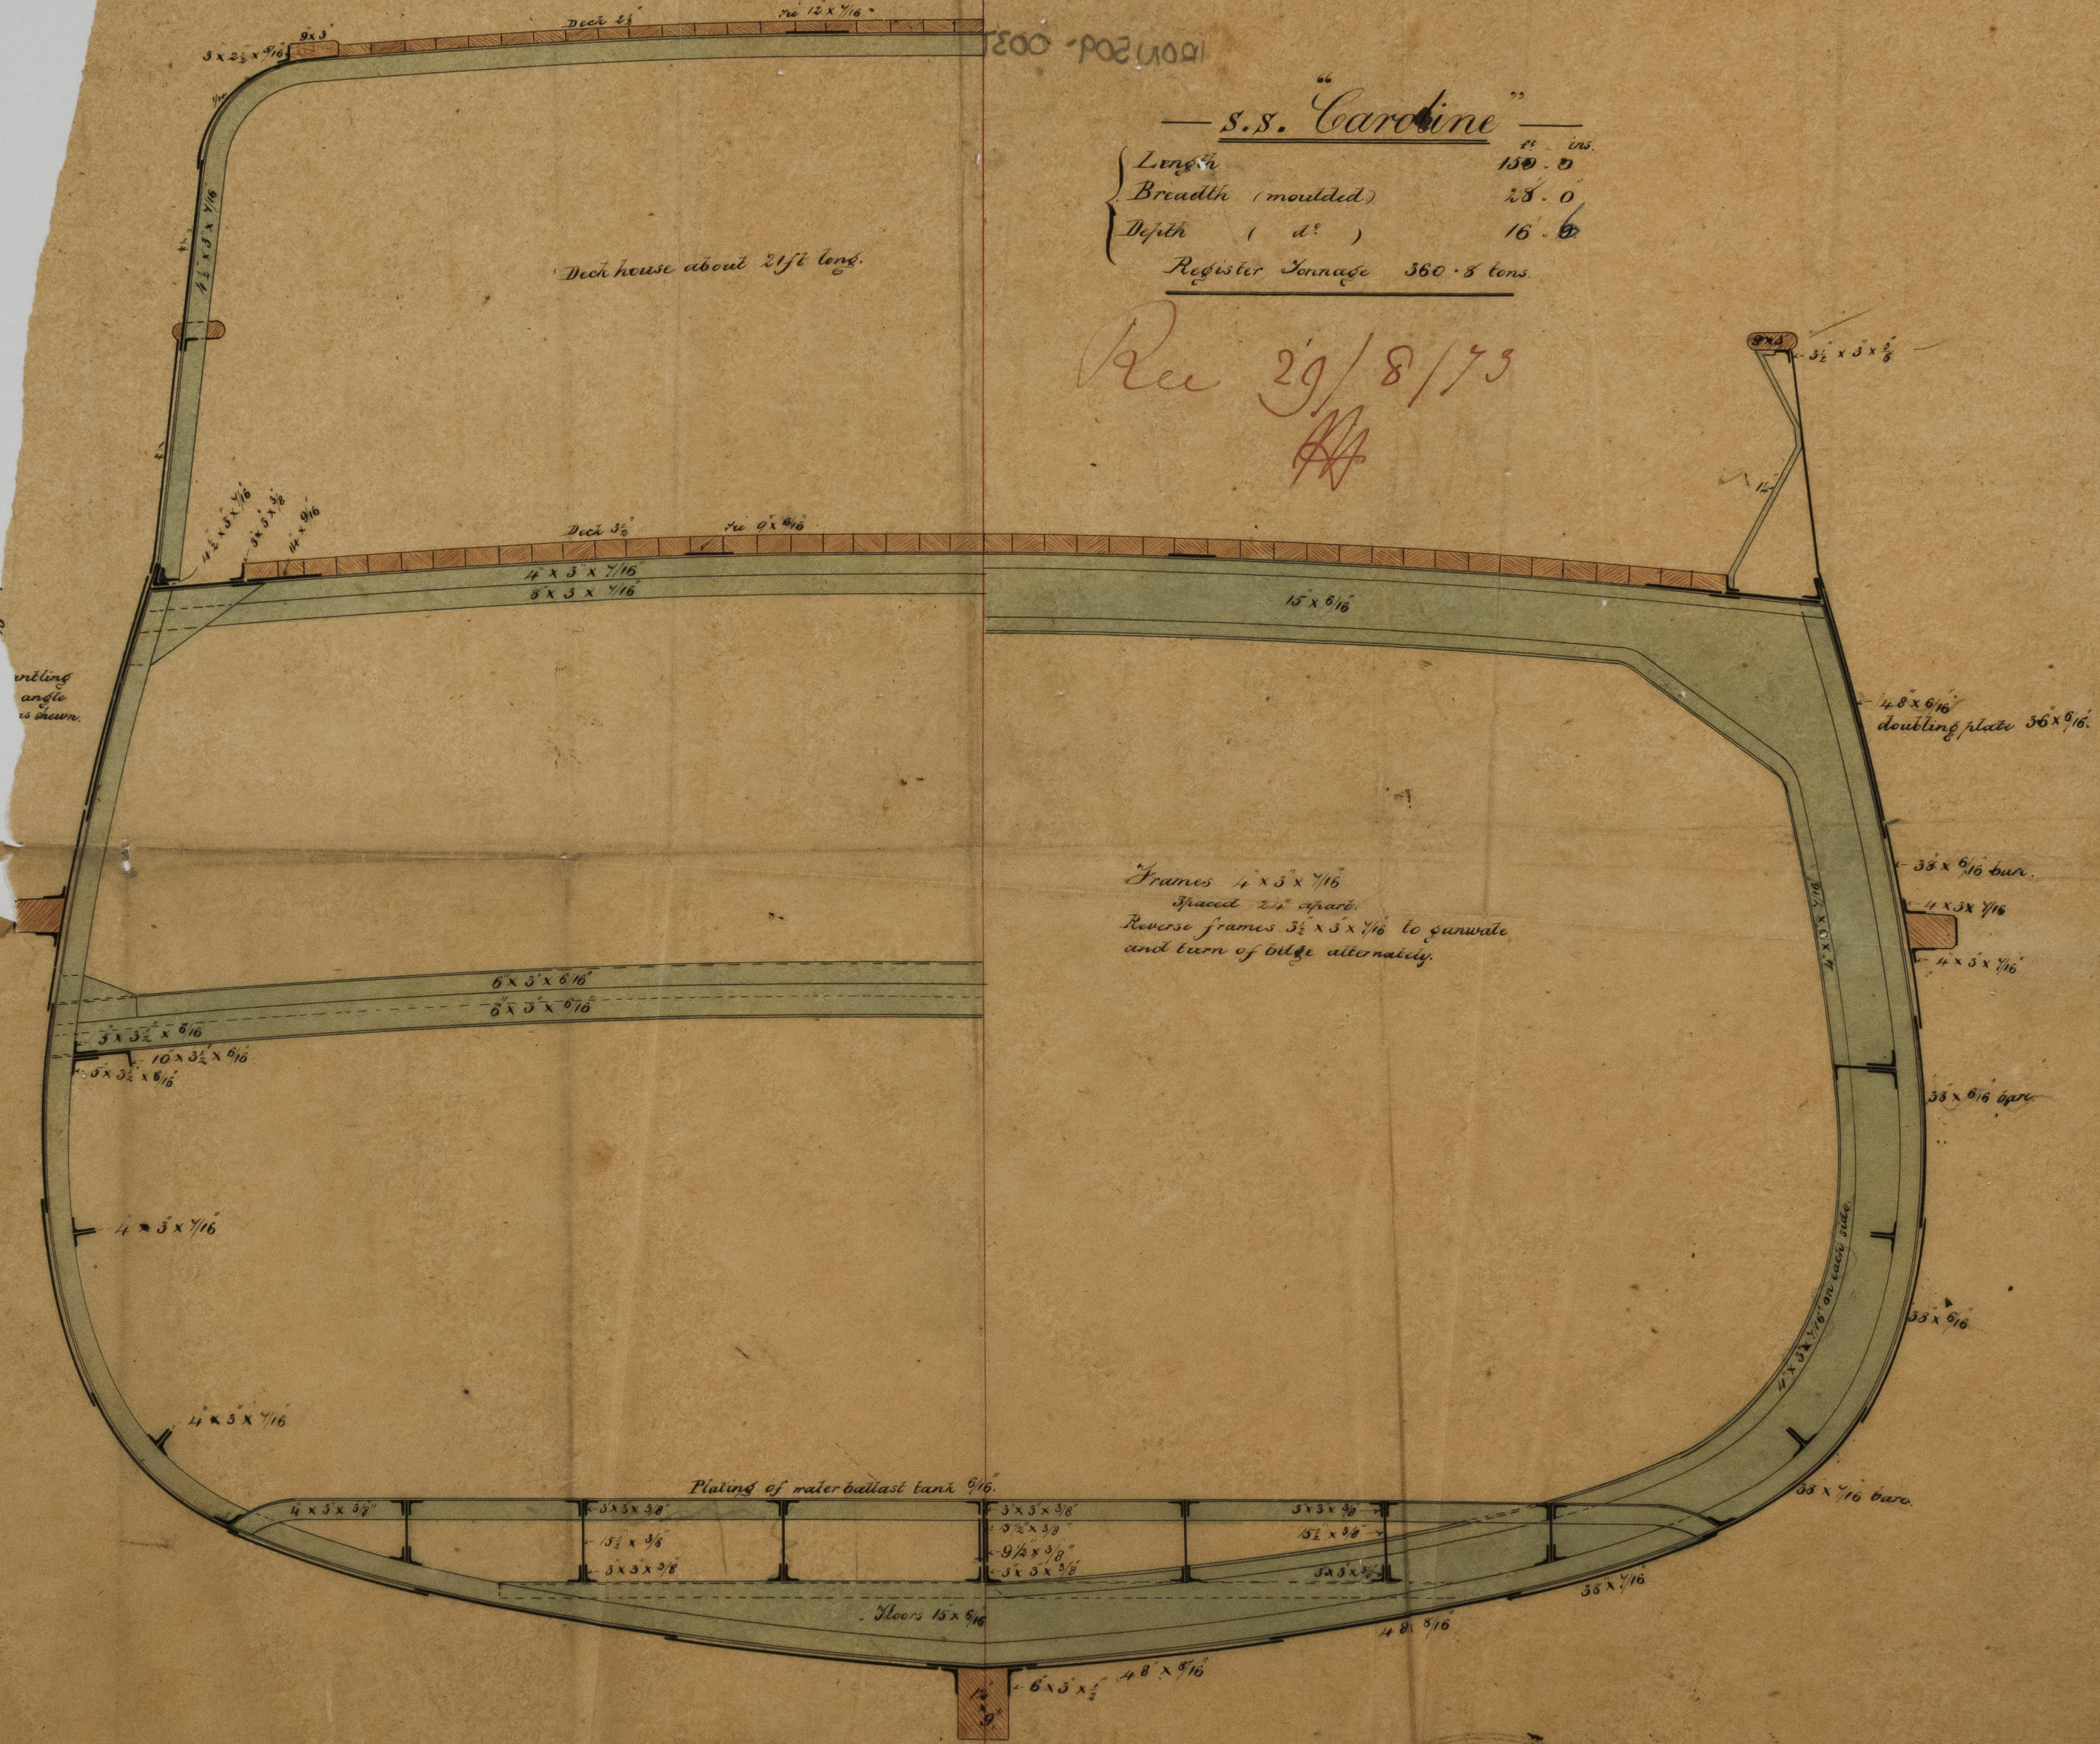

Frames 4 x 5 x 7/16"  
Spaced 2 ft apart.  
Reverse frames 3 1/2 x 5 x 7/16" to gunwale  
and turn of bilge alternately.

Plating of water ballast tank 9/16"

Floors 15 x 9/16"



SCALE 1/4" = 1 FOOT

IRON 504-0037



12921

Iron

IRON 509-0037



A



© 2021

Lloyd's Register  
Foundation