

# S.S. "Brazilian" No 188

Scale  $\frac{1}{2}" = 1'-0"$


Rev 13/2/74 & 11/8/74

1/2 Girth 34.2  
" Breadth 16.0  
Depth 25.10  
79.05  
74.0  
72.05

Under 10 depths to upper deck  
" 13.54 " " Main "  
" 8 breadths  
Length 237.5  
72  
1662.5  
137.100

Length 240  
Breadth 32  
Depth 17  
to Upper Deck 24

I

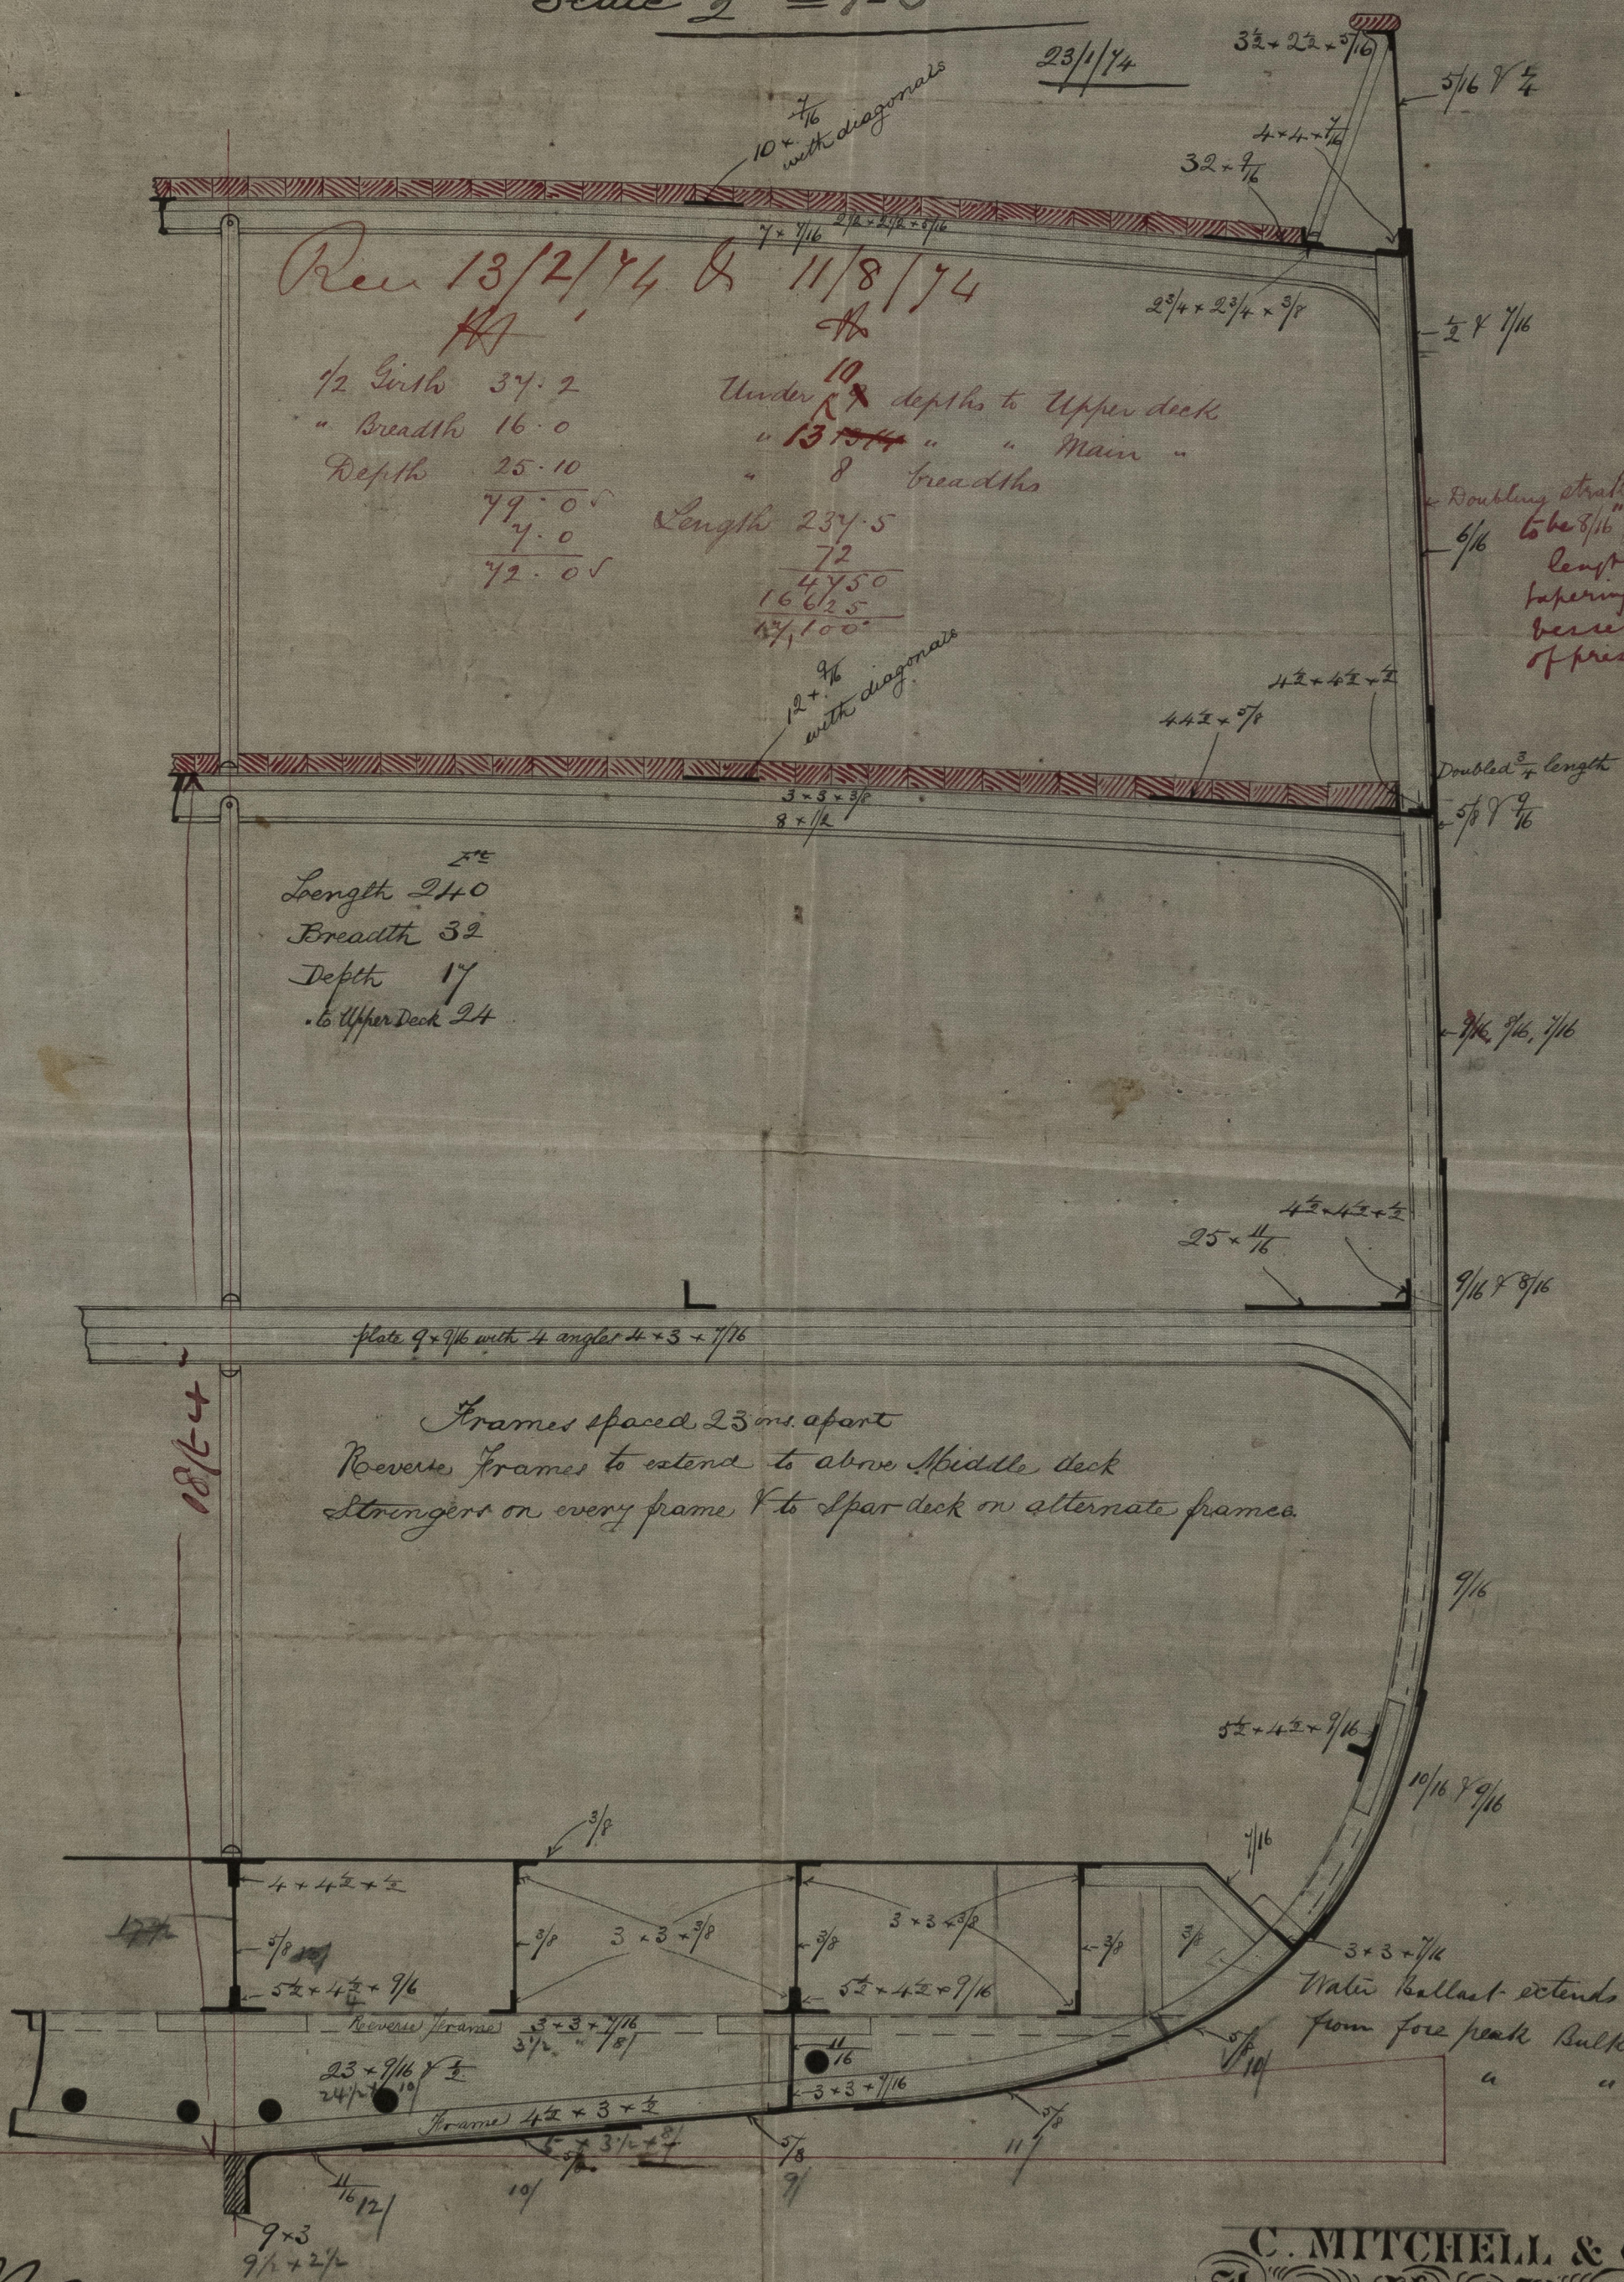

Frames spaced 23 ins. apart  
Reverse frames to extend to above middle deck  
Stringers on every frame & to Spar deck on alternate frames

Water Ballast extends continuously from fore peak Bulkhead to after

18M  
17/2/74  
17/2/74

C. MITCHELL & CO  
Iron Ship Builders  
LOW WALKER  
Newcastle-on-Tyne



13078

*[Handwritten signature]*

IRON 509-0097




© 2021

Lloyd's Register  
Foundation