

"Lionel" - Report No 12534.

13098 Iron



No 299

Under 11 depths

" 7 Beams

Scale $\frac{1}{2}'' = 1'-0''$

30/10/73.

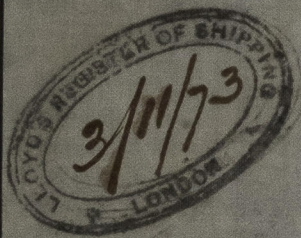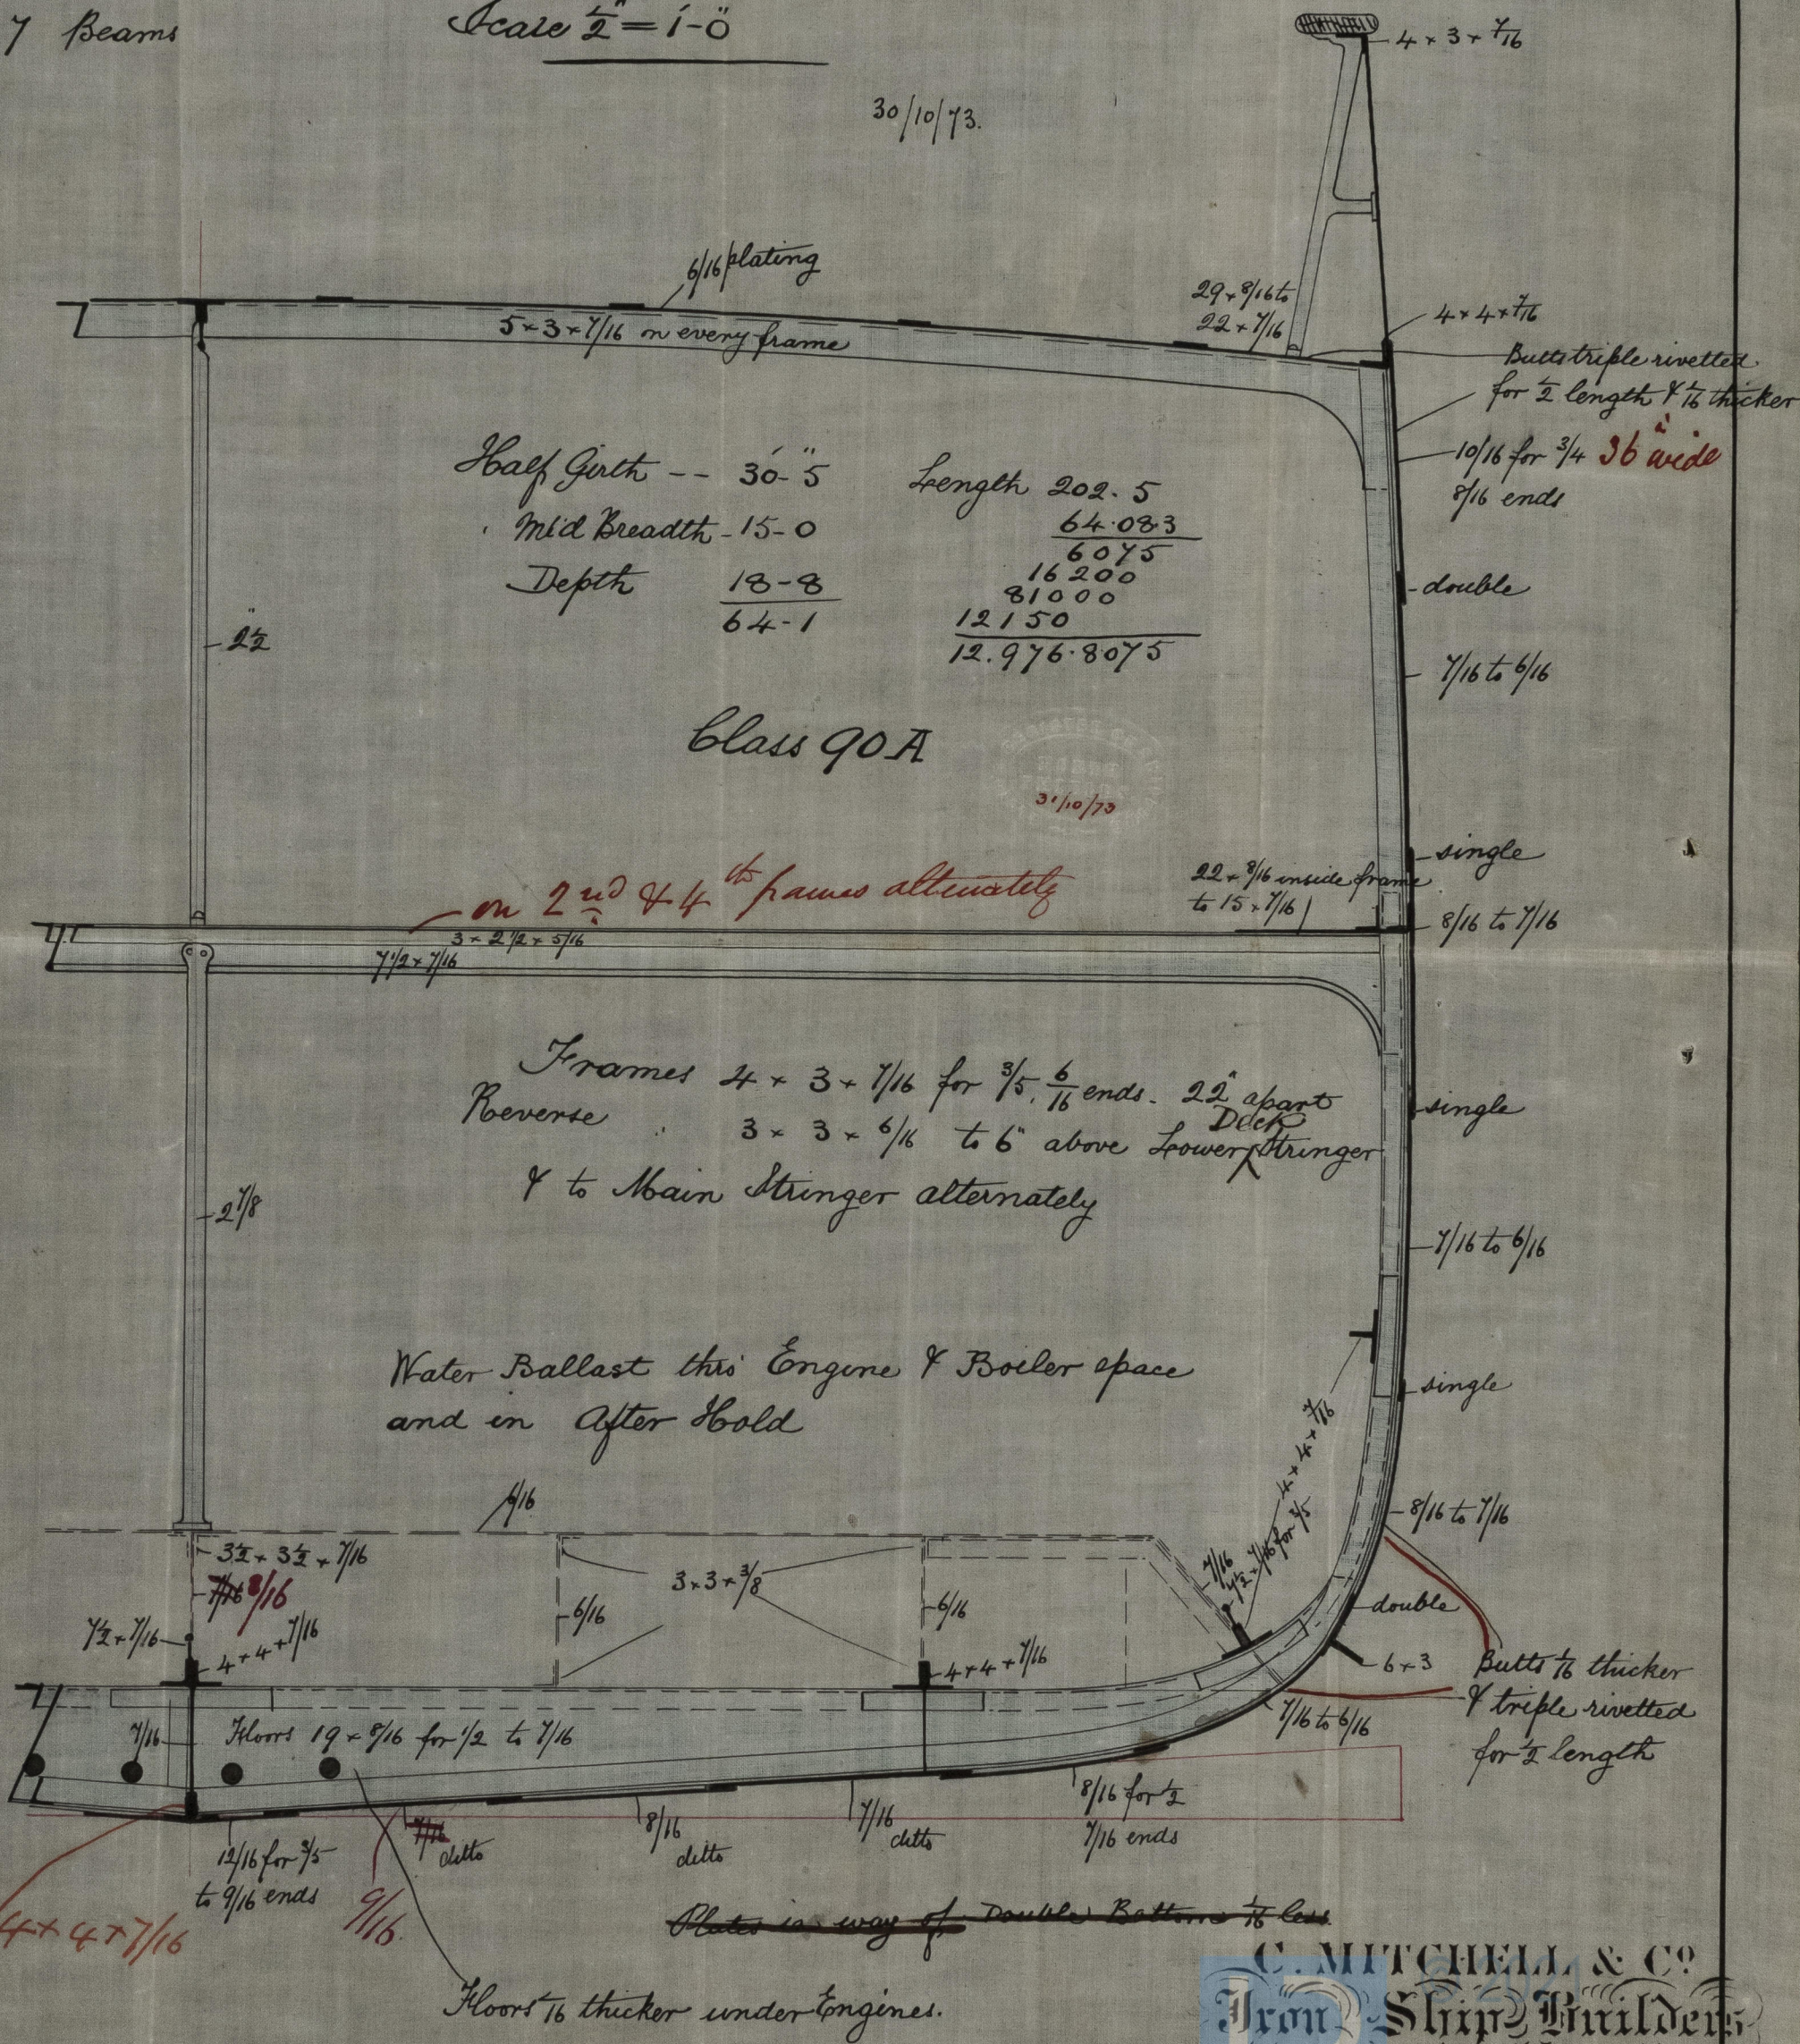

C. MITCHELL & CO
Iron Ship Builders
LOW WALKER
Newcastle-on-Tyne

IRON 509-0103