

The alternate rivets in frames
have been put thro the doubling strake.

July 14/74 E. L. W.

Sketch shewing holes
in doubling plate



S. S. Hankow

Scale $1\frac{1}{2}" = \text{one foot}$

Rev 5/8/74

13/6/74

Rev 16/6/74
Rev 17/6/74

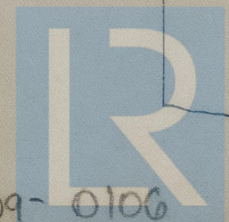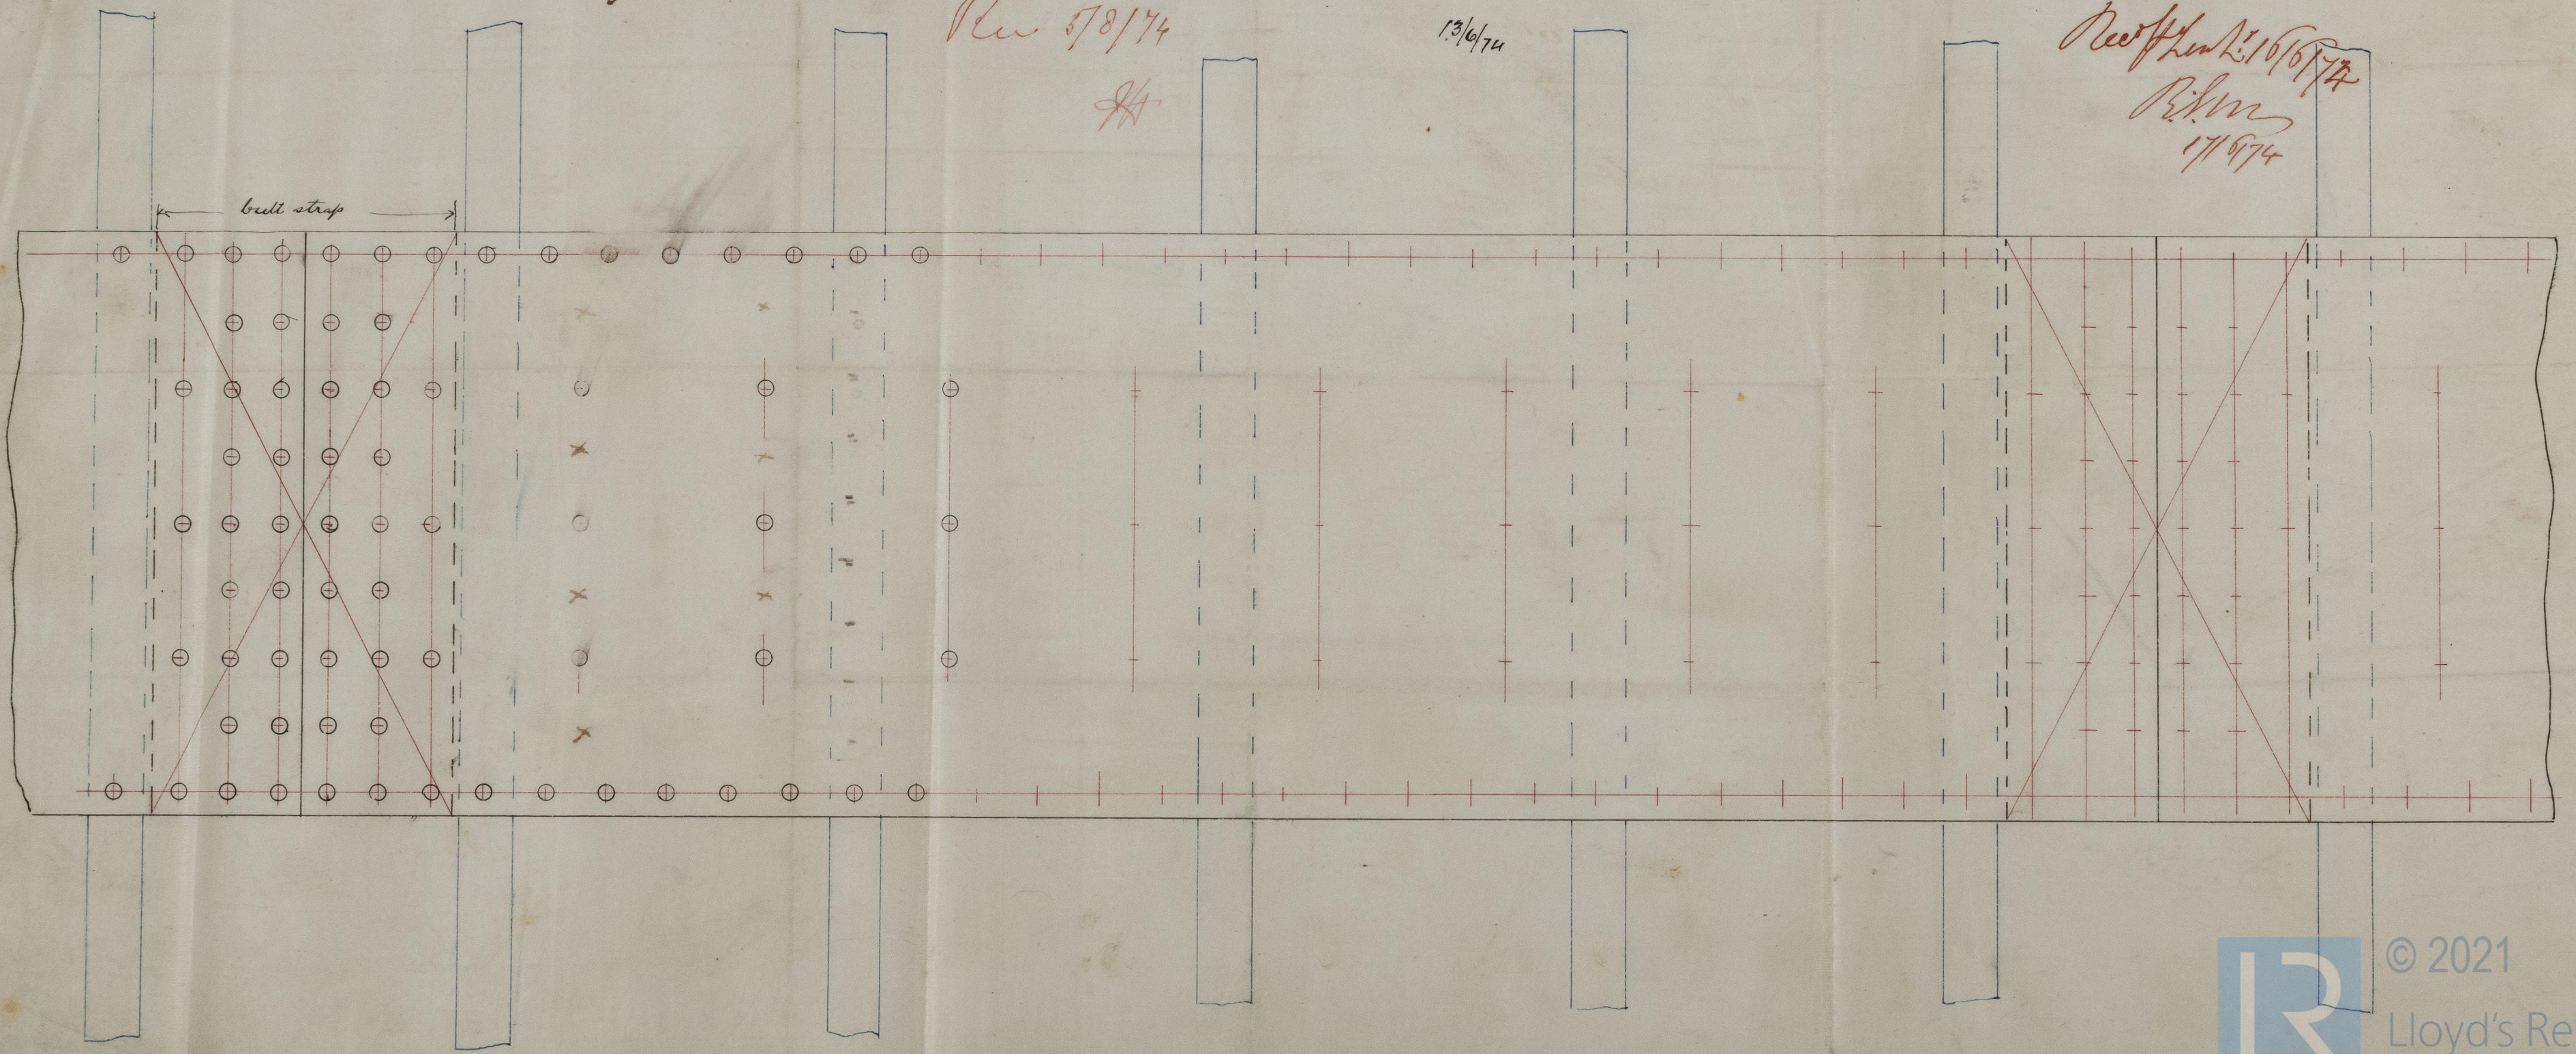

© 2021

Lloyd's Register
Foundation

IRON 509-0106