

Midships Section

S.S. No 108.


Scale $\frac{1}{2}$ " = one foot.

Class 90 a 3 decks,

$\frac{1}{2}$ moulded beam --- 16 = 11
 Depth from top of keel --- 26 = 6.
 $\frac{1}{2}$ Girth --- 39 = 3.
 Breadth to length --- 7.9. Less 7 = 0
 Depth to length --- 10.1. Bridge 13.7. 75 = 8 = 75.66 x 268.5 = 20,314.

Rec 29/11/73 & 16/12/73
 H

1.12.73

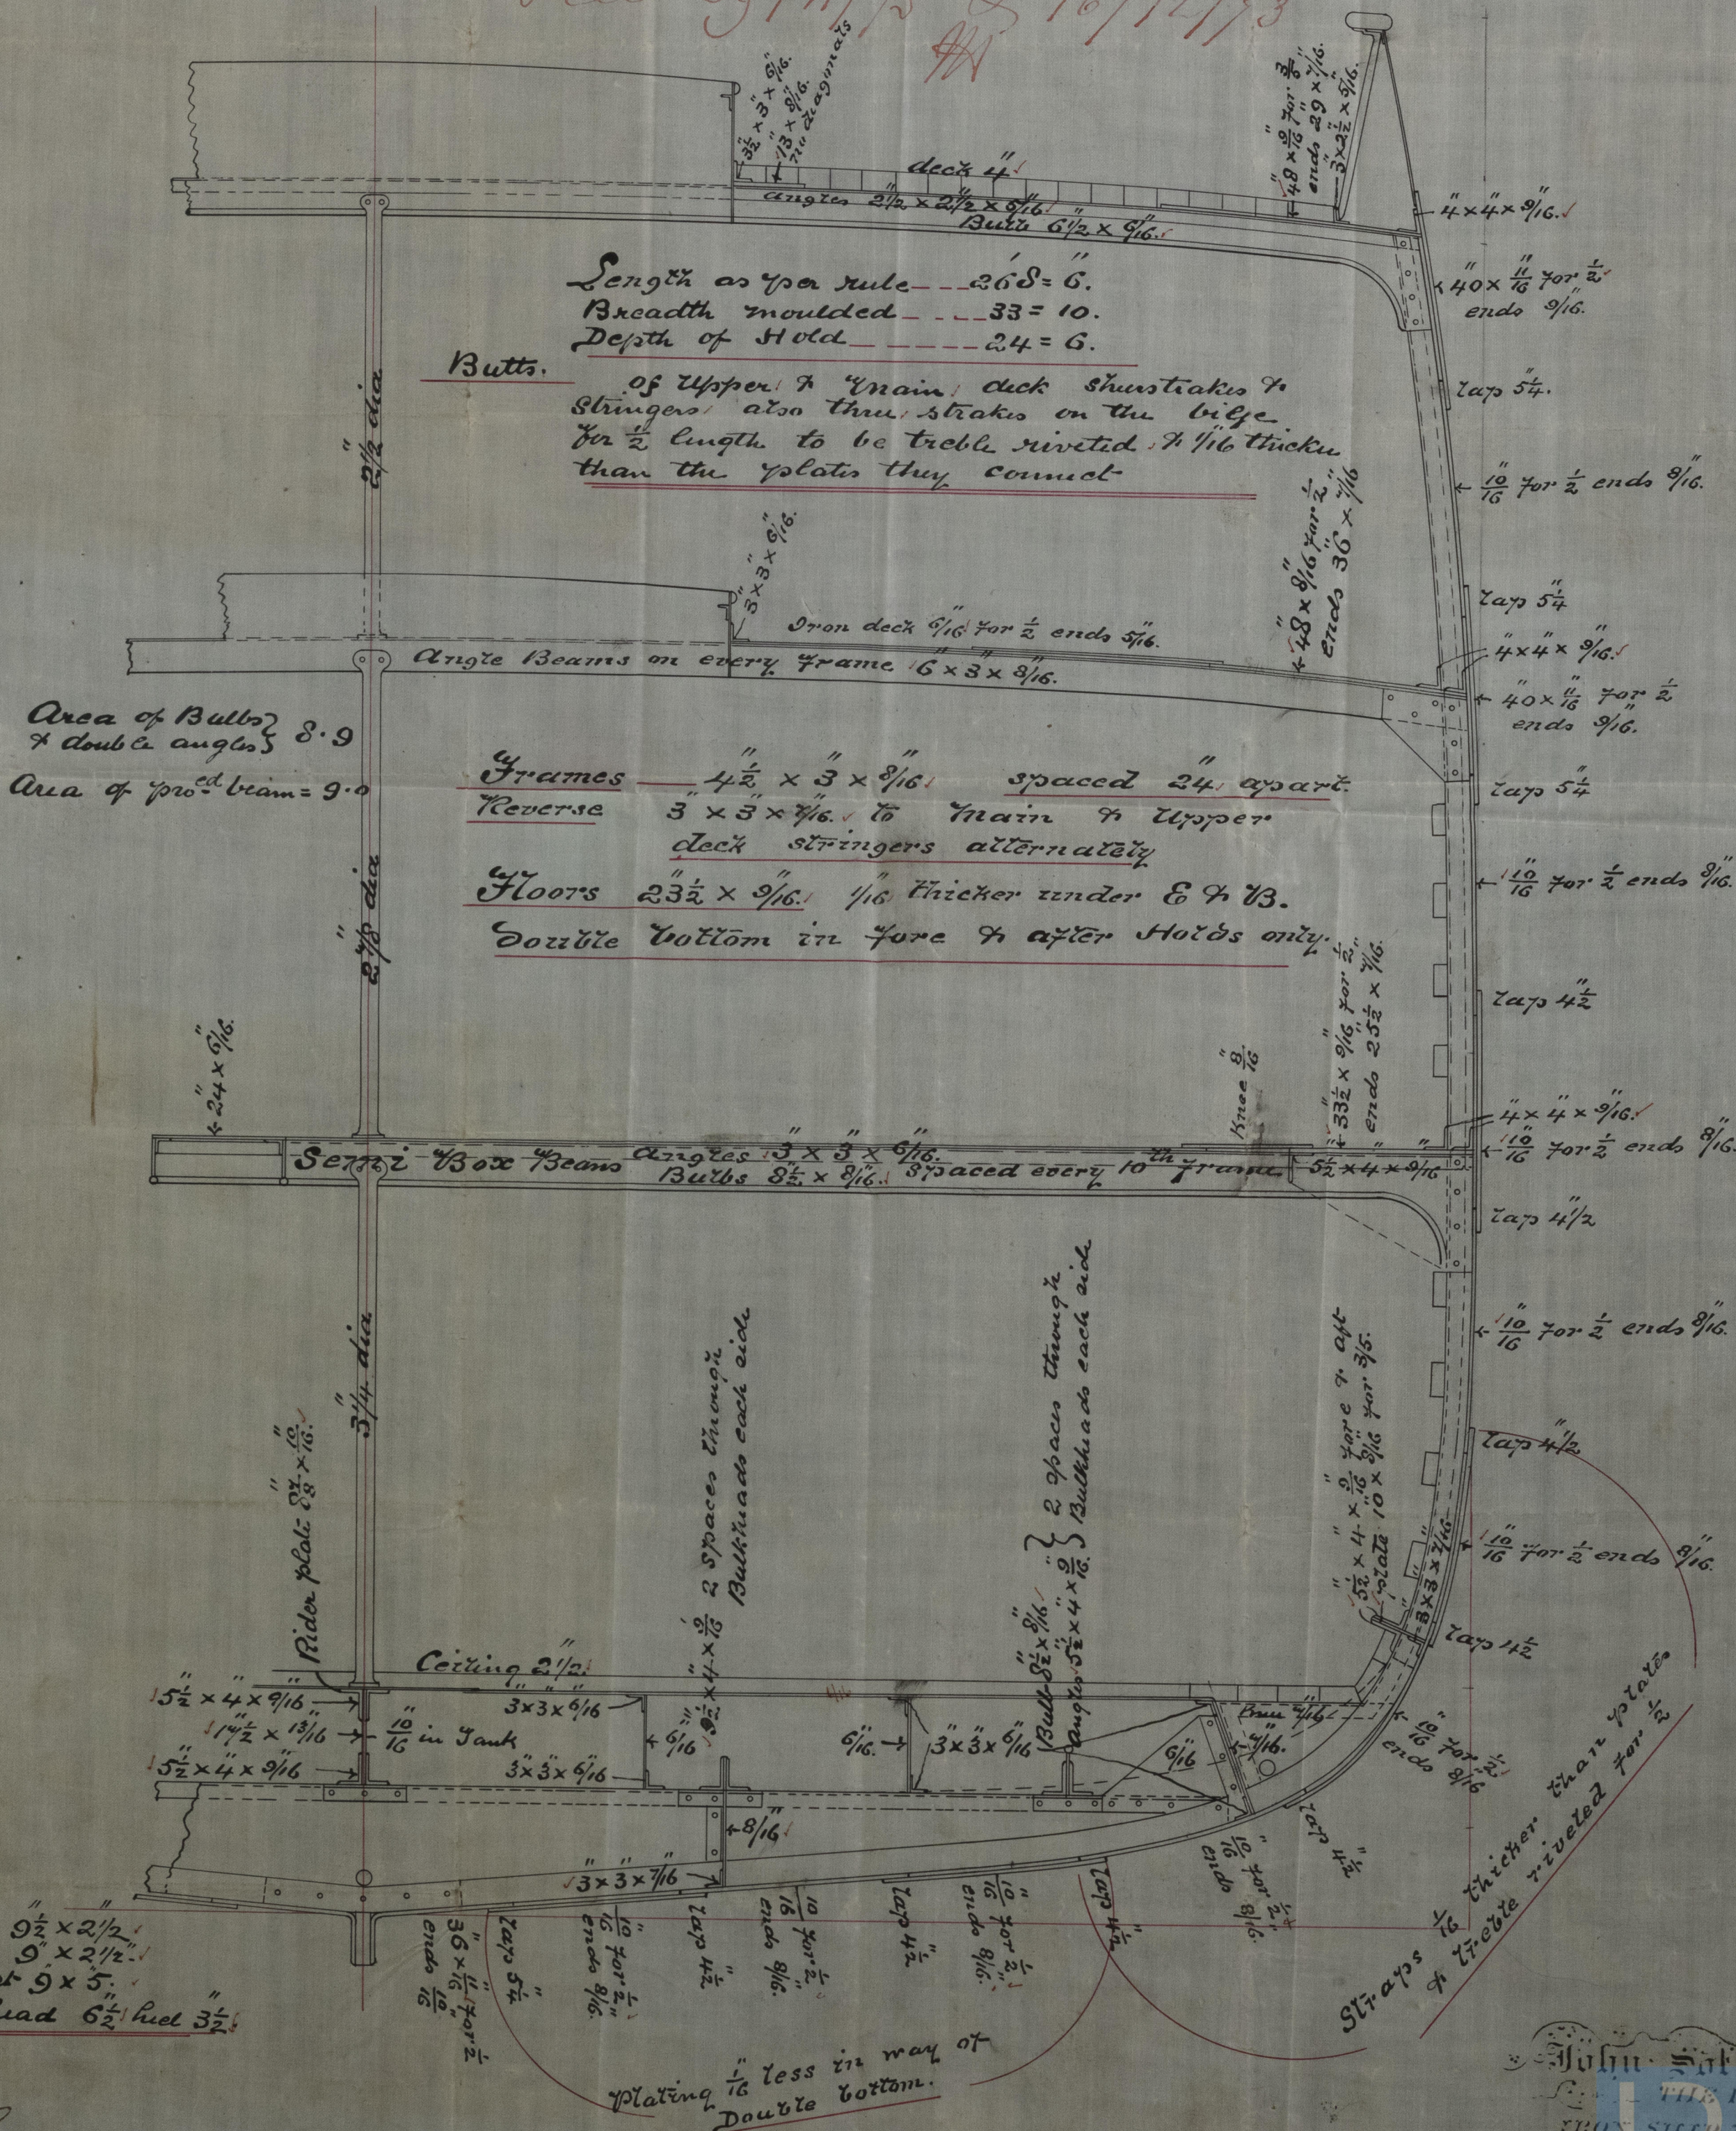

John Sattlen & Co
 THE LANE
 IRON STEEL BUILDING YARD
 SOUTH SHIELDS