

8.12.73


S.S. "Constance"  
Report No. 3346

Longitudinal Plan No. 3455.  
Scale 1/4 in. = 1 ft.  
Mr. H. Turnbull & Son, Whitby, Dec. 11/73.  
Plan 6/12/73

Fore hatch of main deck

Fore hatch of main deck

Length on Load Line 225 ft.  
Extreme Breadth 30 ft.  
Depth on Mould 17 ft. 0 in.  
Displacement on Tons 1350

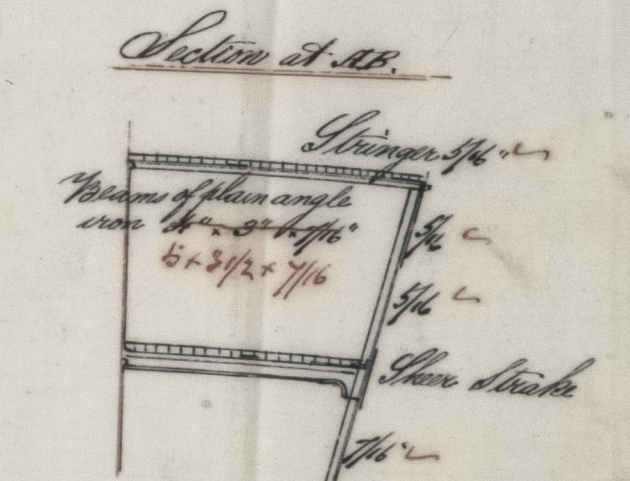

9/10/73 5/12/73  
8/12/73

180509-0123