


No 13292

IRON  
SHIPS

Arrangement of Beams & Stringers on Lower deck No 154

Scale  $\frac{3}{16}$  inch = 1 foot.

Dec 8/1/74

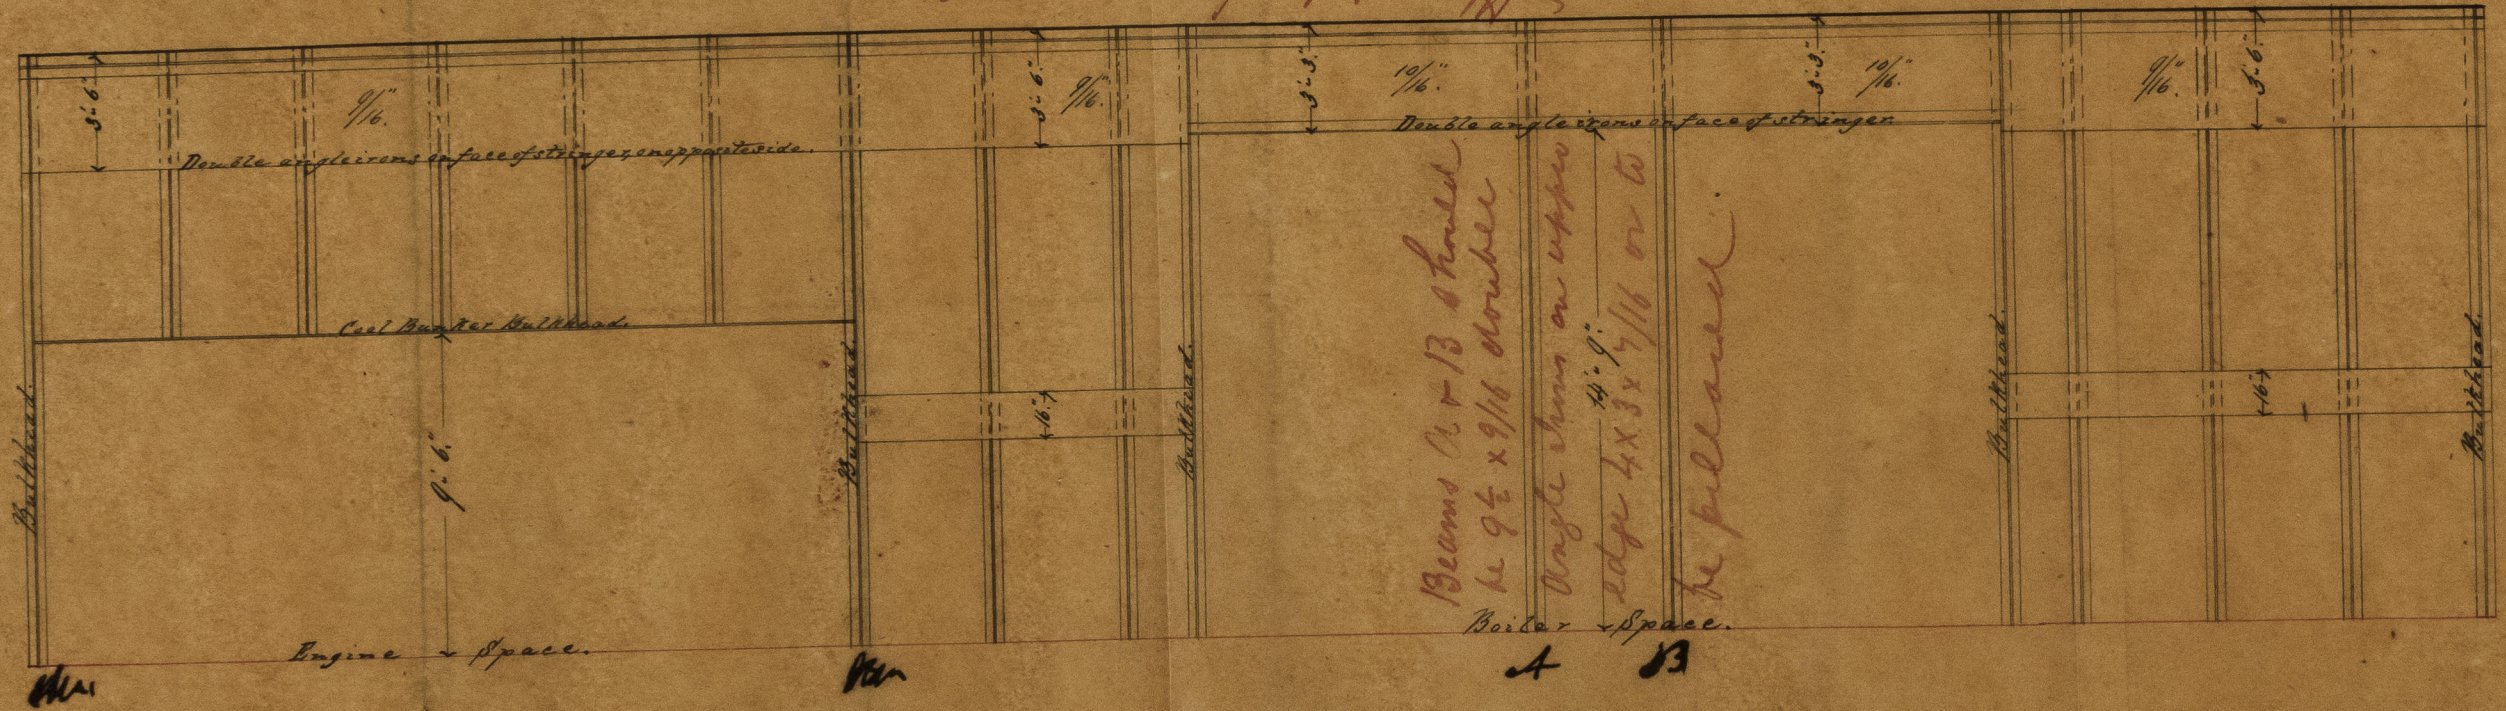

SCOTT & CO.,  
ENGINEERS AND IRON SHIPBUILDERS,  
GARTSDYKE,  
GREENOCK.

IRONSD9-0171



18th  
© 2017/75  
Lloyd's Register  
Foundation