

13293  
Sh


18<sup>th</sup>. July 1873

$\frac{1}{2}$  Section SS  $\frac{5}{E}$

90A

1/2 W Girth 35.9 ✓  
" " Breadth 19.9 ✓  
Depth 22.85 ✓  
Length 78.65 ✓ 1st No  
301.5  
893.25  
235450  
23712.975 ✓ 2nd No

Length 7.5 breaths  
13.1 Depth

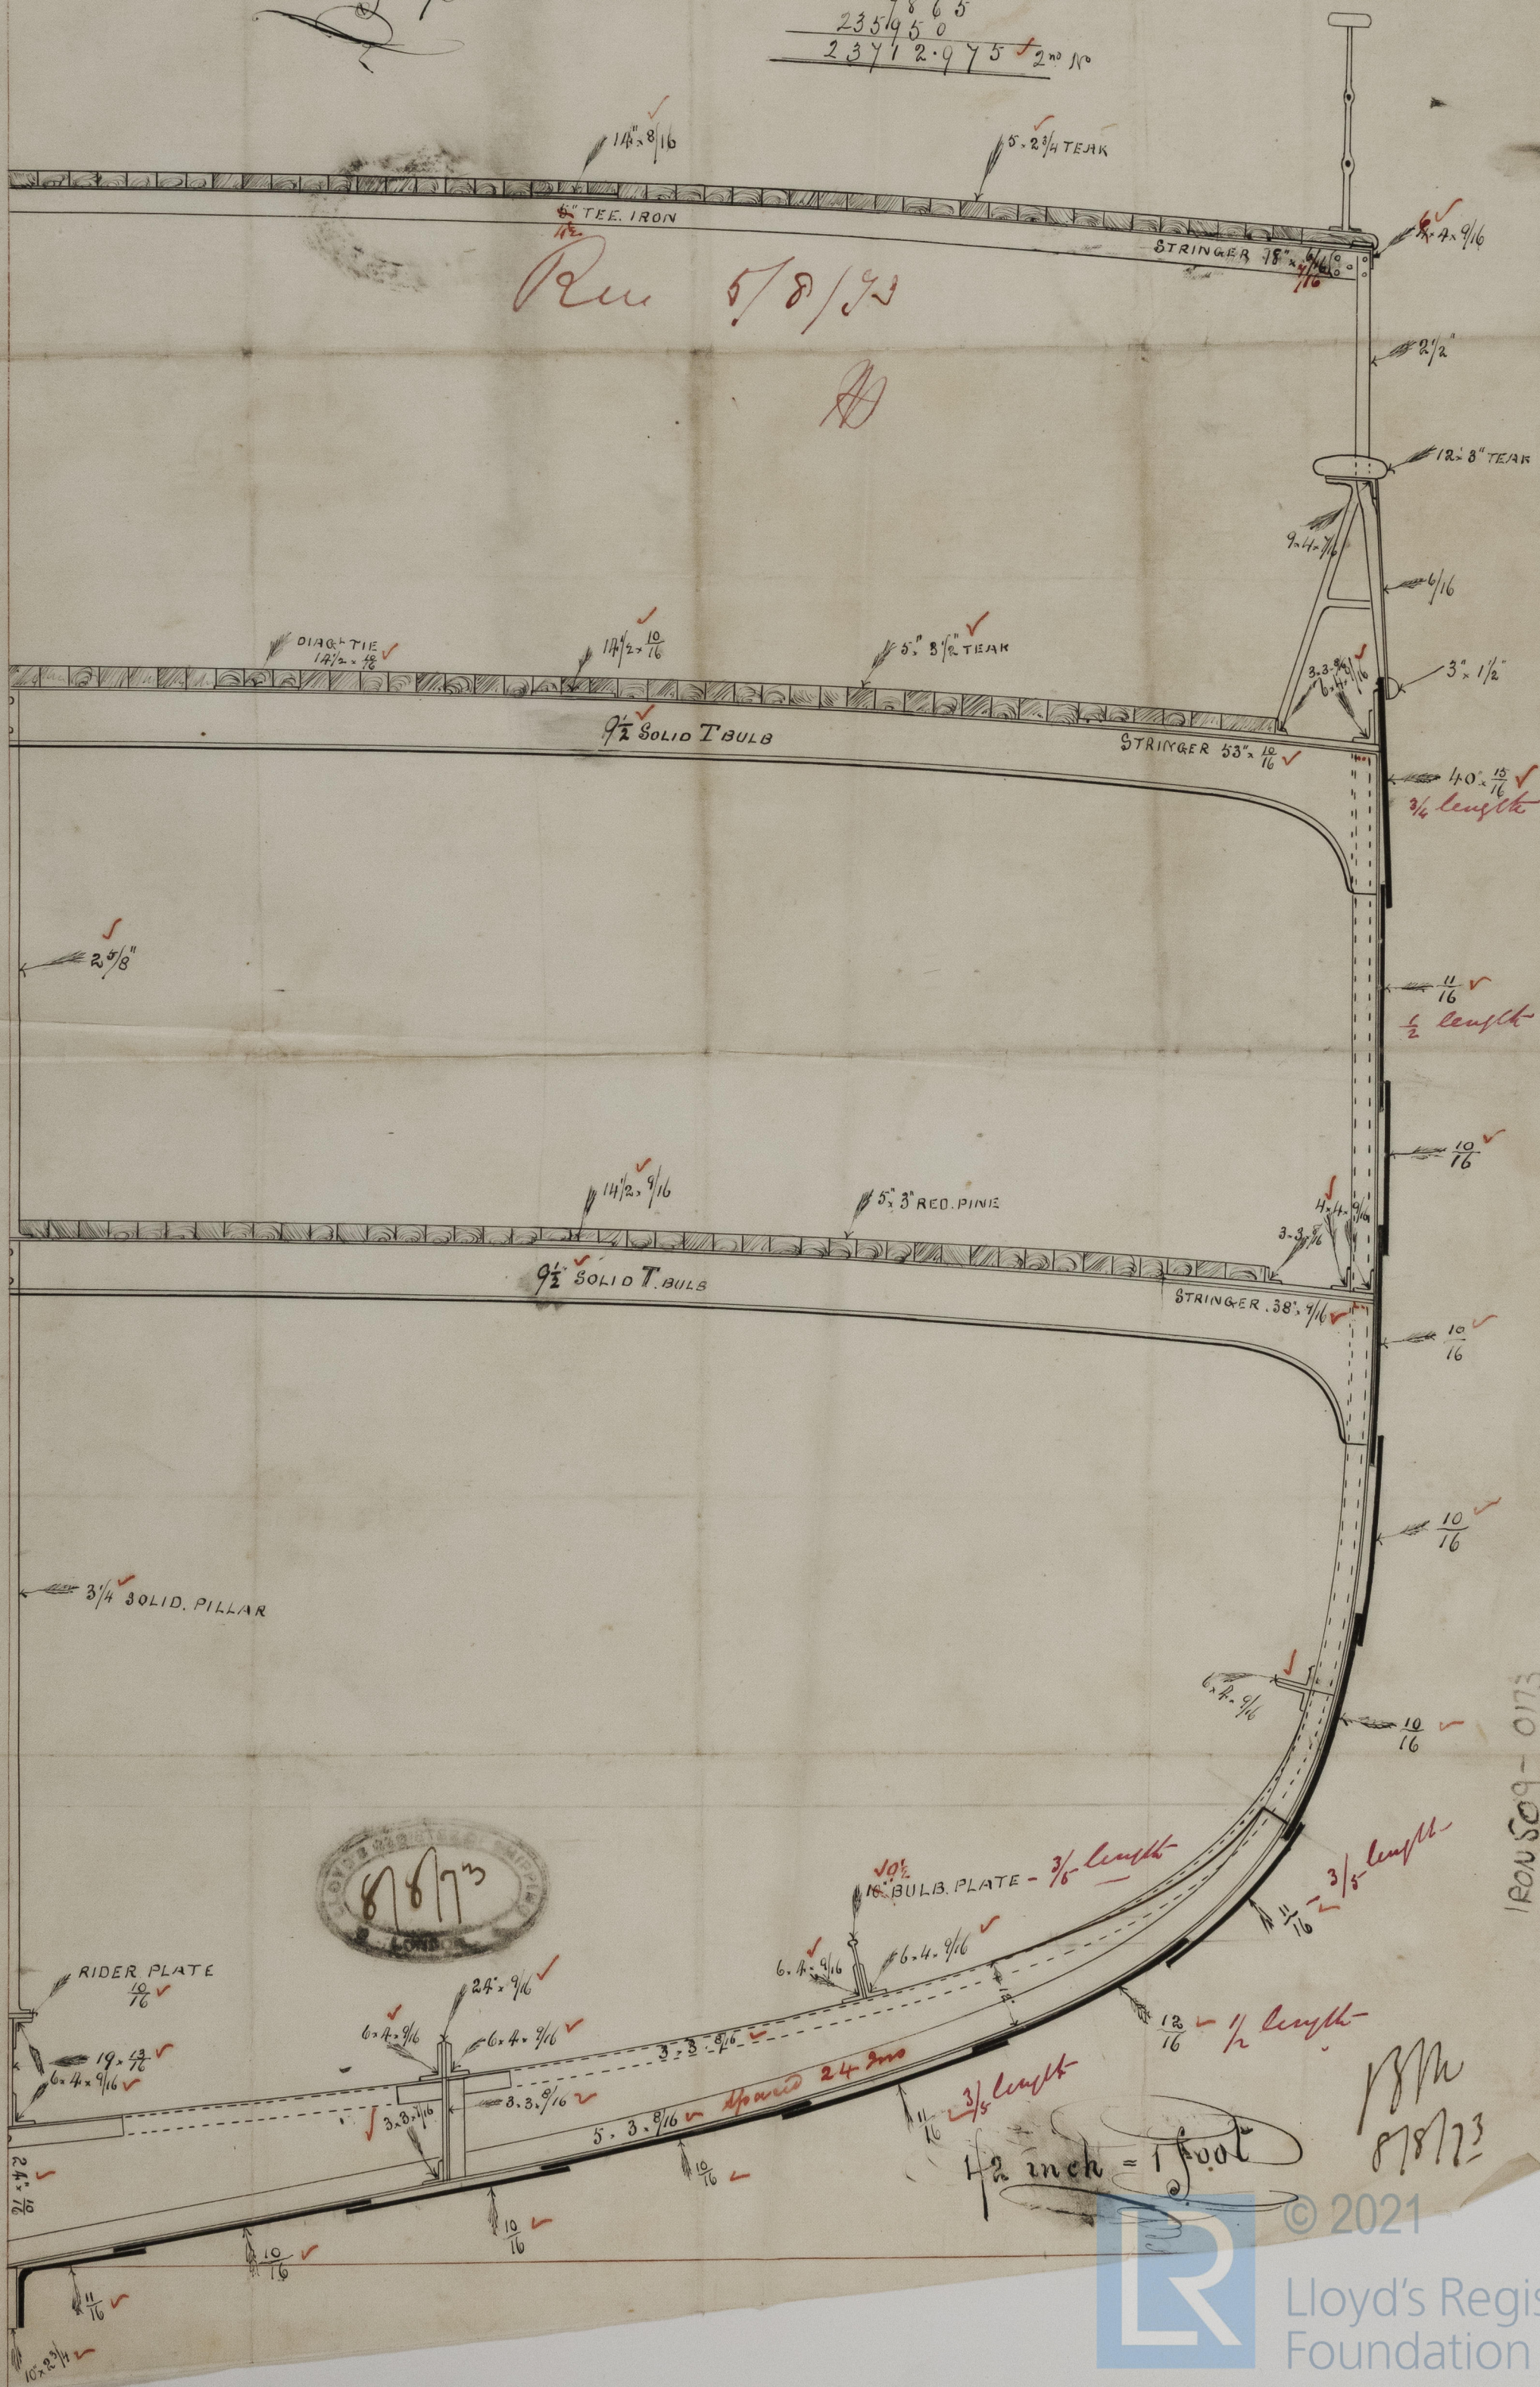

RON 809-0173

1872  
878723