

FORE & MAIN MASTS
 Report N^o 3362. S. S. "Madras"
 OF


N^o 135 S S

Scale 1/2 Inch to one Foot

Rec 19/3/74 & 27/3/74
PA

Lands of plate to be double riveted.

- Butts below Deck to be double riveted.*
- All Butts above Deck to be triple riveted.*
- Buttstraps to be 1/8 thicker than the plates they connect.*
- Fore part of masts both laps outside.*
- Laps of plates to be as shown on Tracing.*

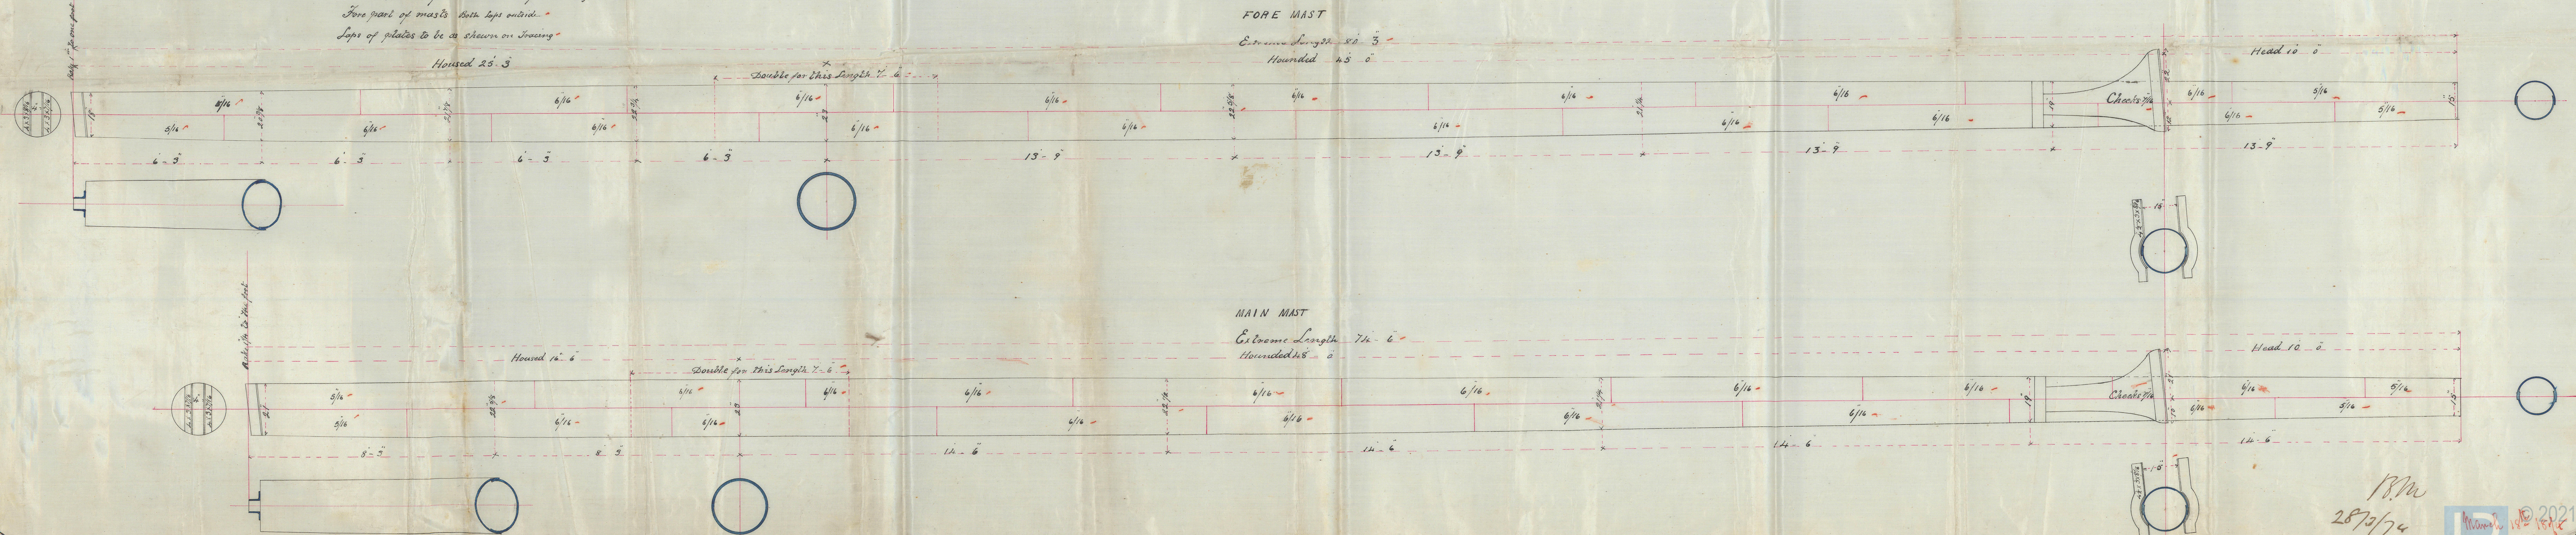








FORE MAST

MAIN MAST

Estimated
Measured

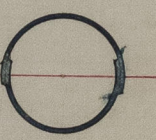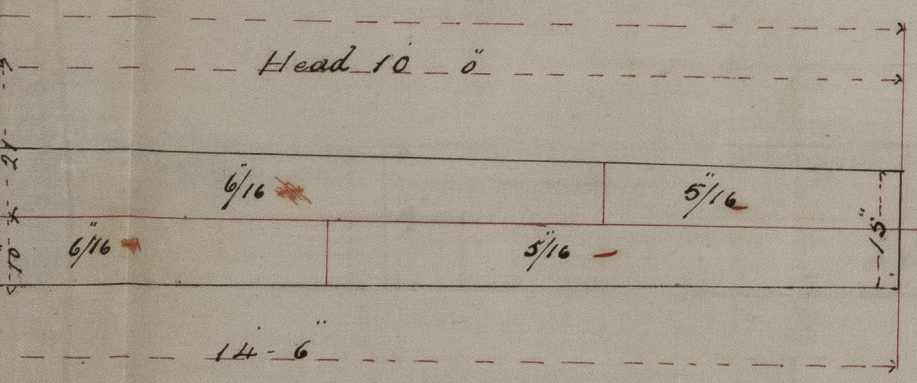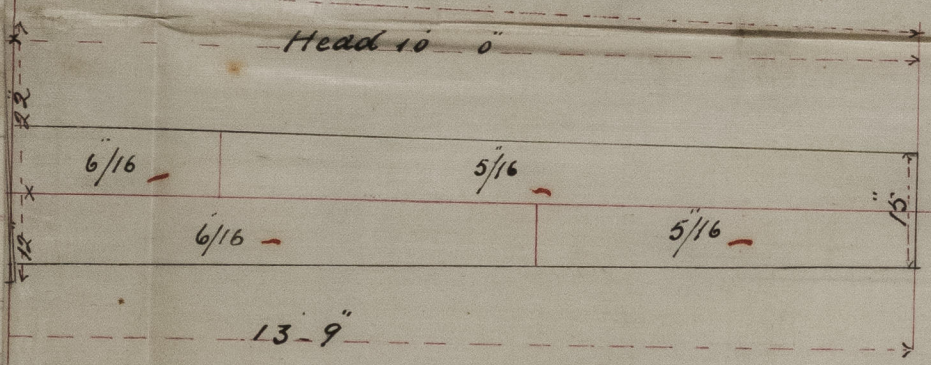

B.M.
2873/74

March 18th 1874
March 17-1874

IRON 509-0227



© 2021
Lloyd's Register
Foundation