

Report No 3362 L. S. Madras
ELEVATION


OF
No 135 S.S

Scale 1/4 Inch to one Foot

270'0" x 33'0" x 24'6"

In class 90A "3 Decks"

Rec 12/1/74
H

 

Substantial Beams to be fitted in Engine and Boiler spaces where practicable say 10 x 10 with corresponding angles in on upper and lower edge.

Forecastle
Stores
and
Parting beams to be fitted

W. B. L. M. Hodge
AV303


10
S. I. S. H.

Introduction

12/1/74


of 12/1/74

Rec 12/1/74

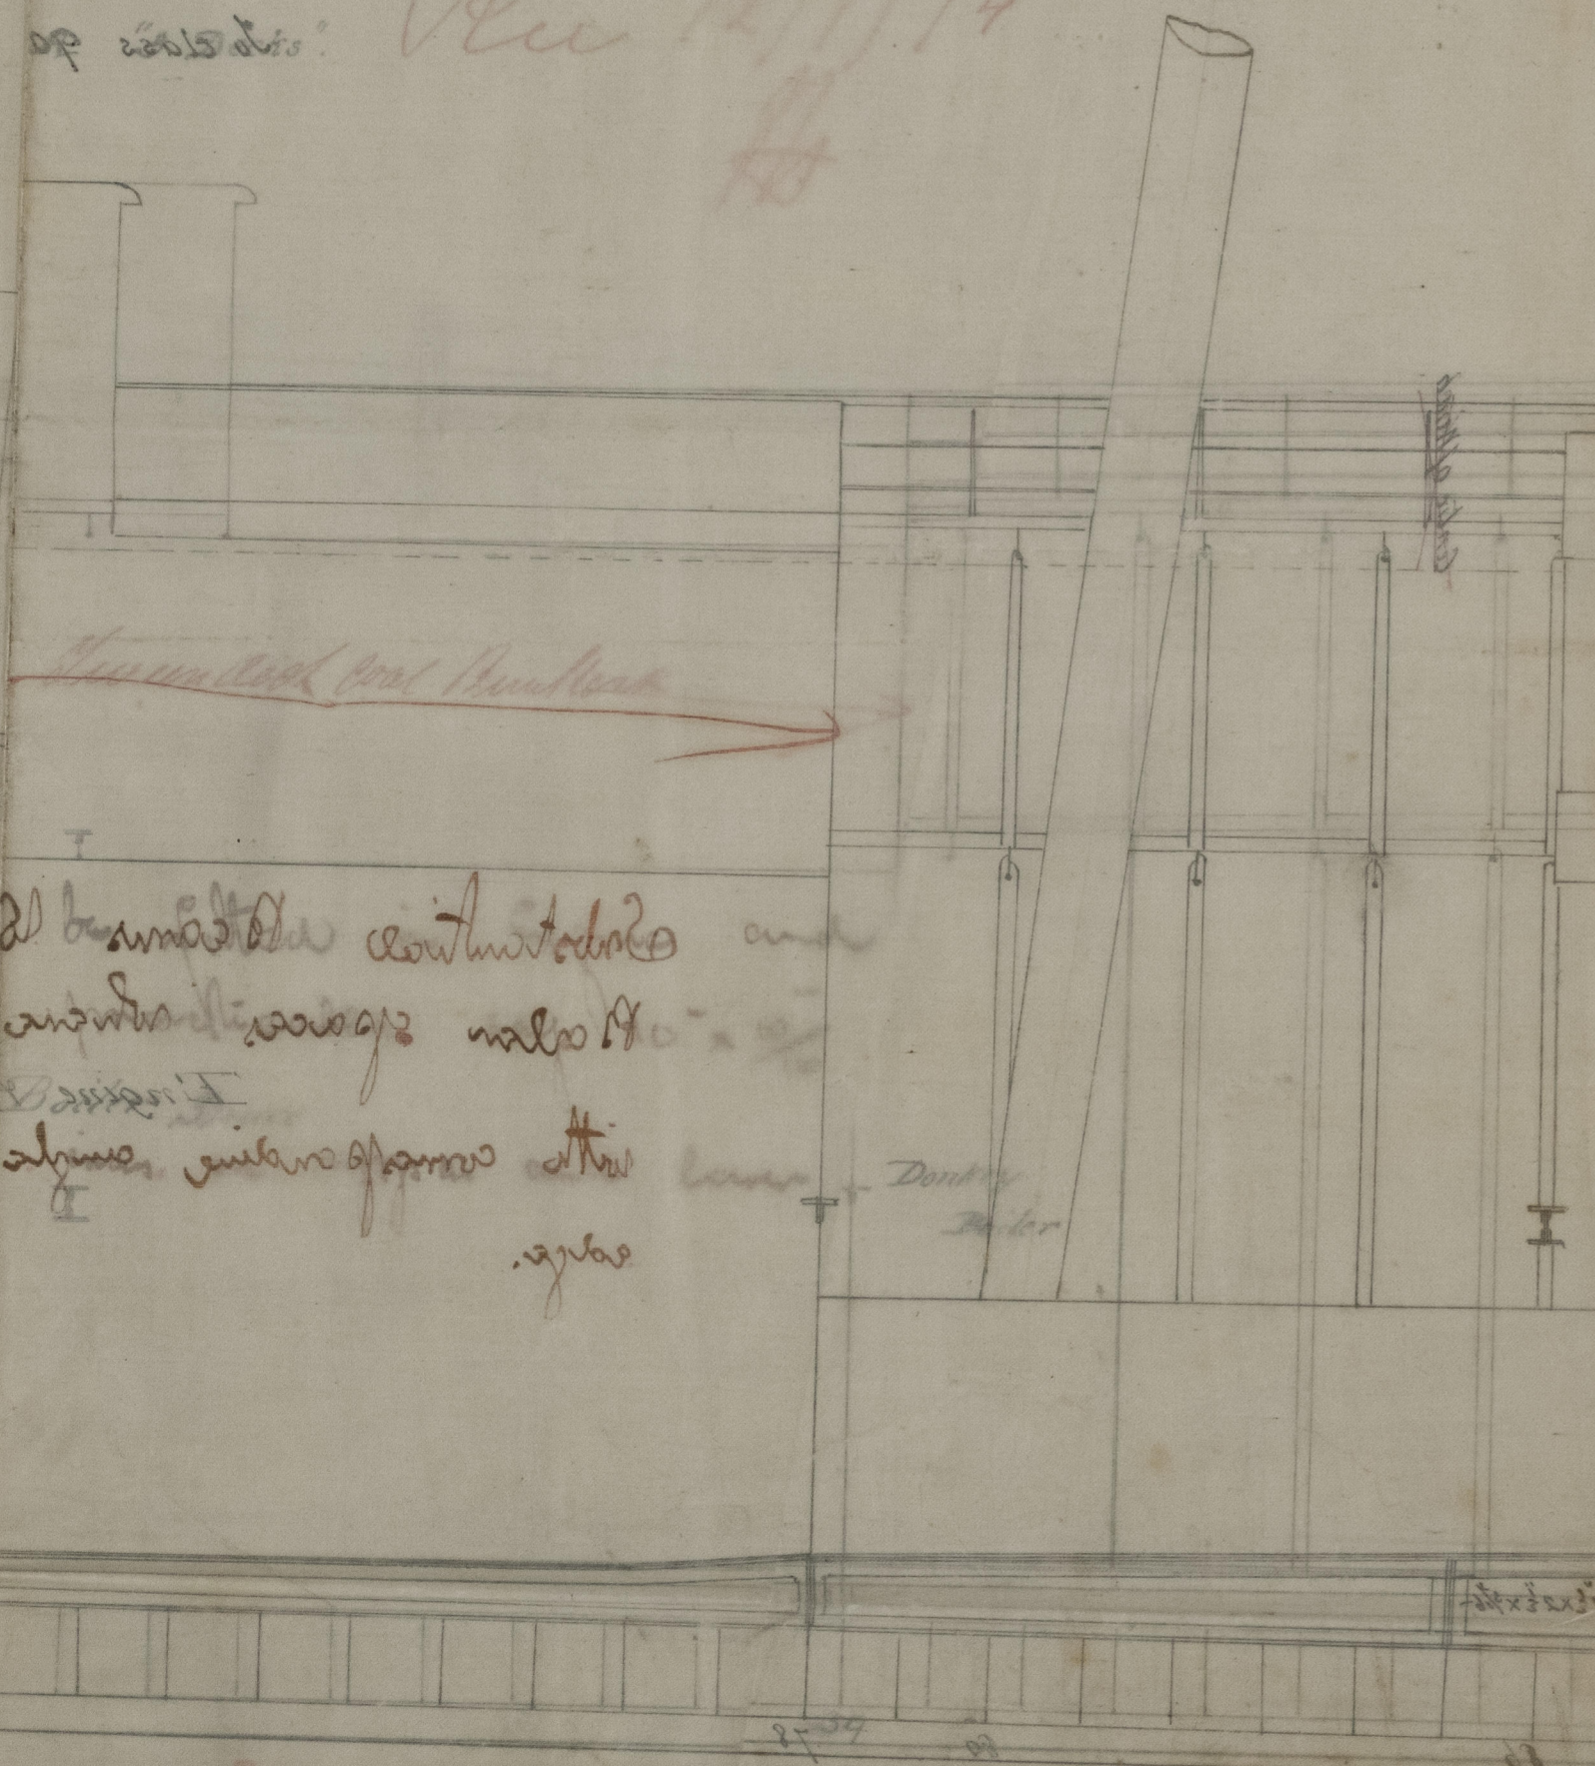

21 beams to be continued and
intermediate beams also
Design I
shown in the plan
above

Double
Bulkhead

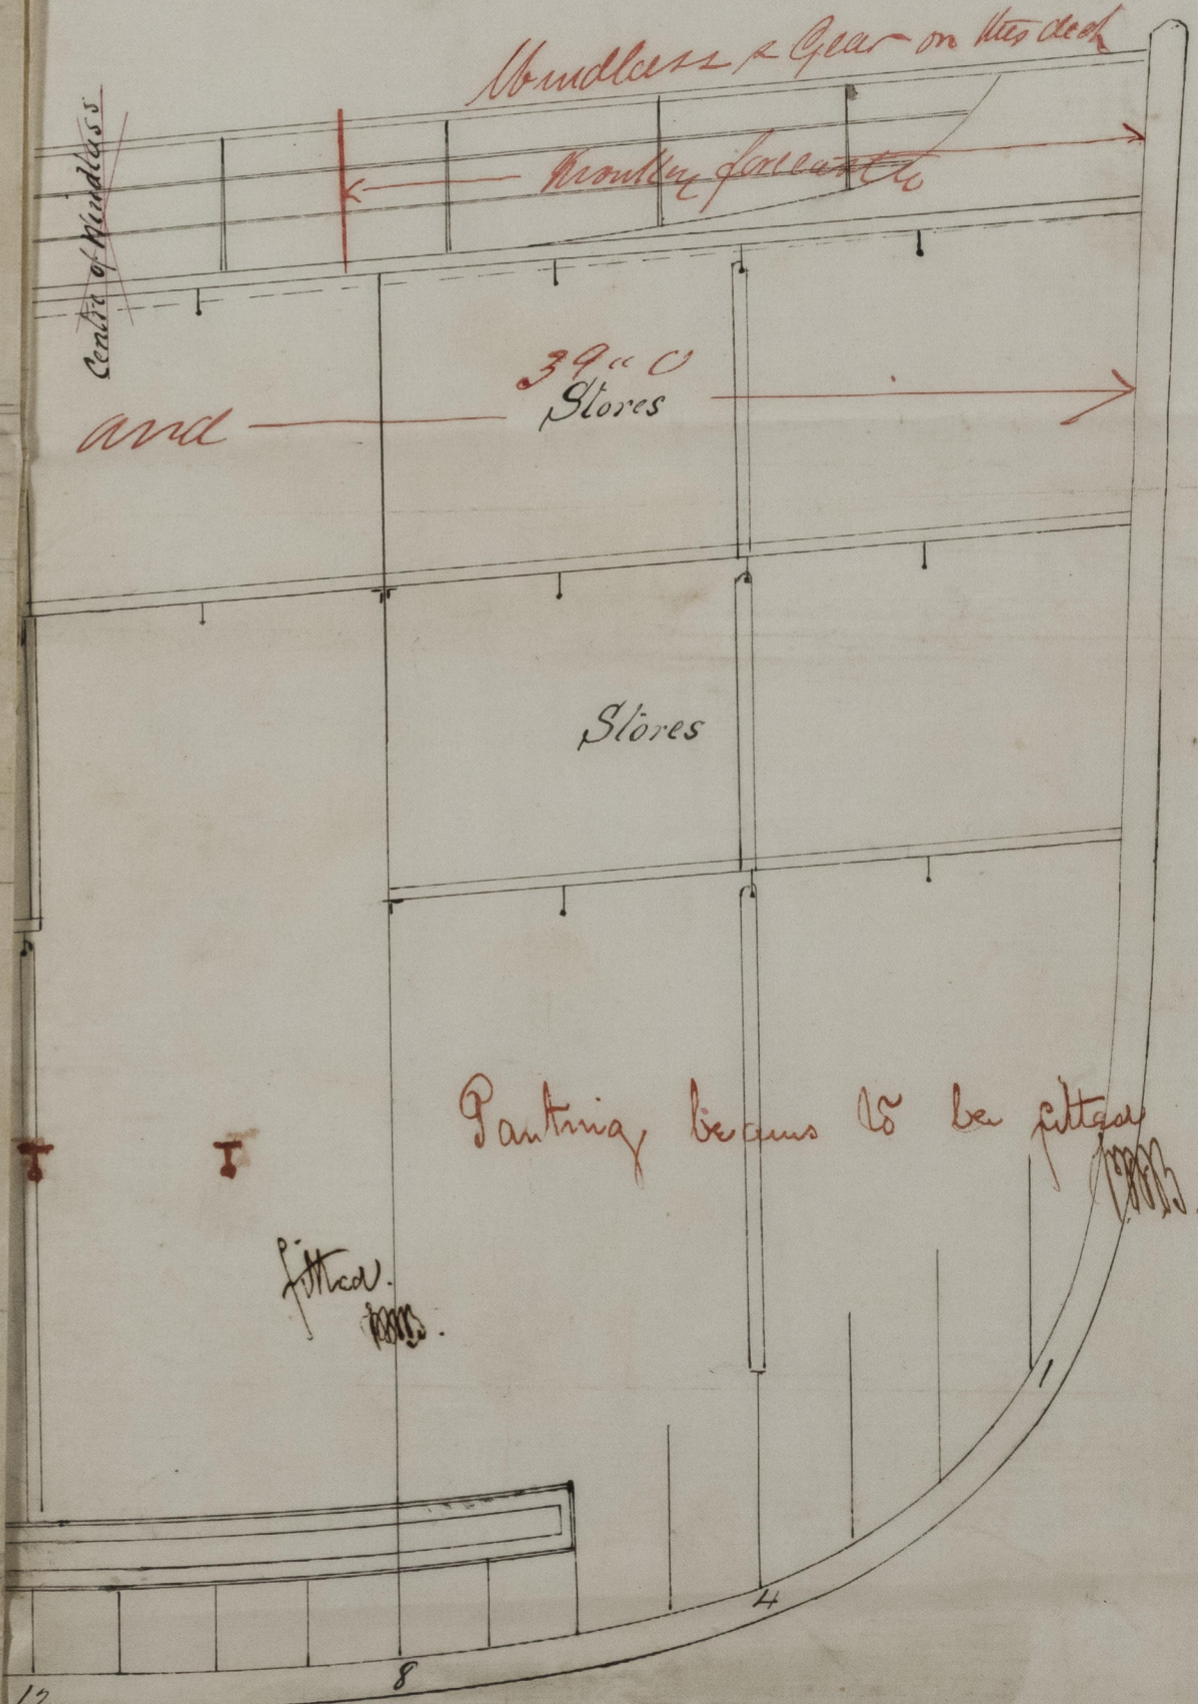


fitted
pantry

120509-0229