

6/1/74



S.S. "Unity"  
Report No 3363

The Rules for  
Strength of  
Hull & Machinery  
of H.M.S. & other  
Steamships will be  
observed.

Longitudinal Plan No 3885.  
Scale 1/4" = 1 ft.  
Messrs. Turnbull & Son, Whitby, Jan 3<sup>rd</sup> 1874.

Rec 6/1/74  
HA


Length on Main deck 222' 9"  
Breadth Extreme 30' 0"  
Depth to Top of Keel 18' 8"  
Displacement on Tons 1450

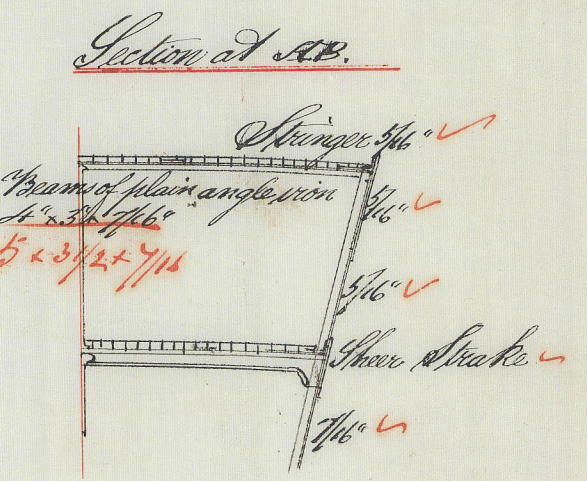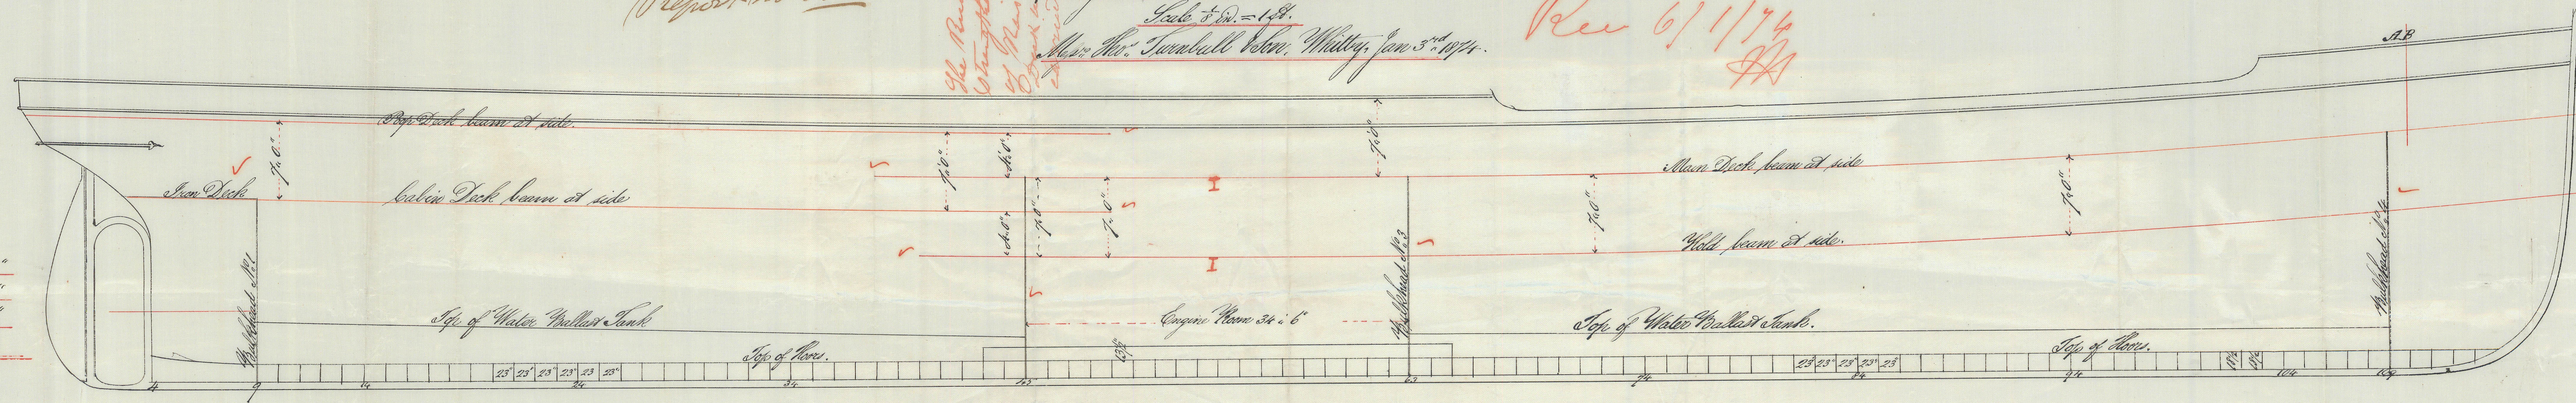

IRON 509-0256



Section at AB.

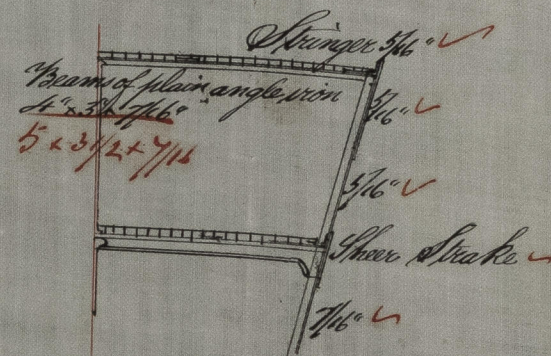

Lloyd's Register  
6/1/74 4/9/75  
Foundation 1109