


13408 Jm

7012632

4

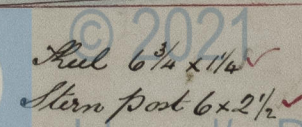


1200509-0270

N. J.
3/3/74 J. H. A.

13408th Len

IRON 509-0270

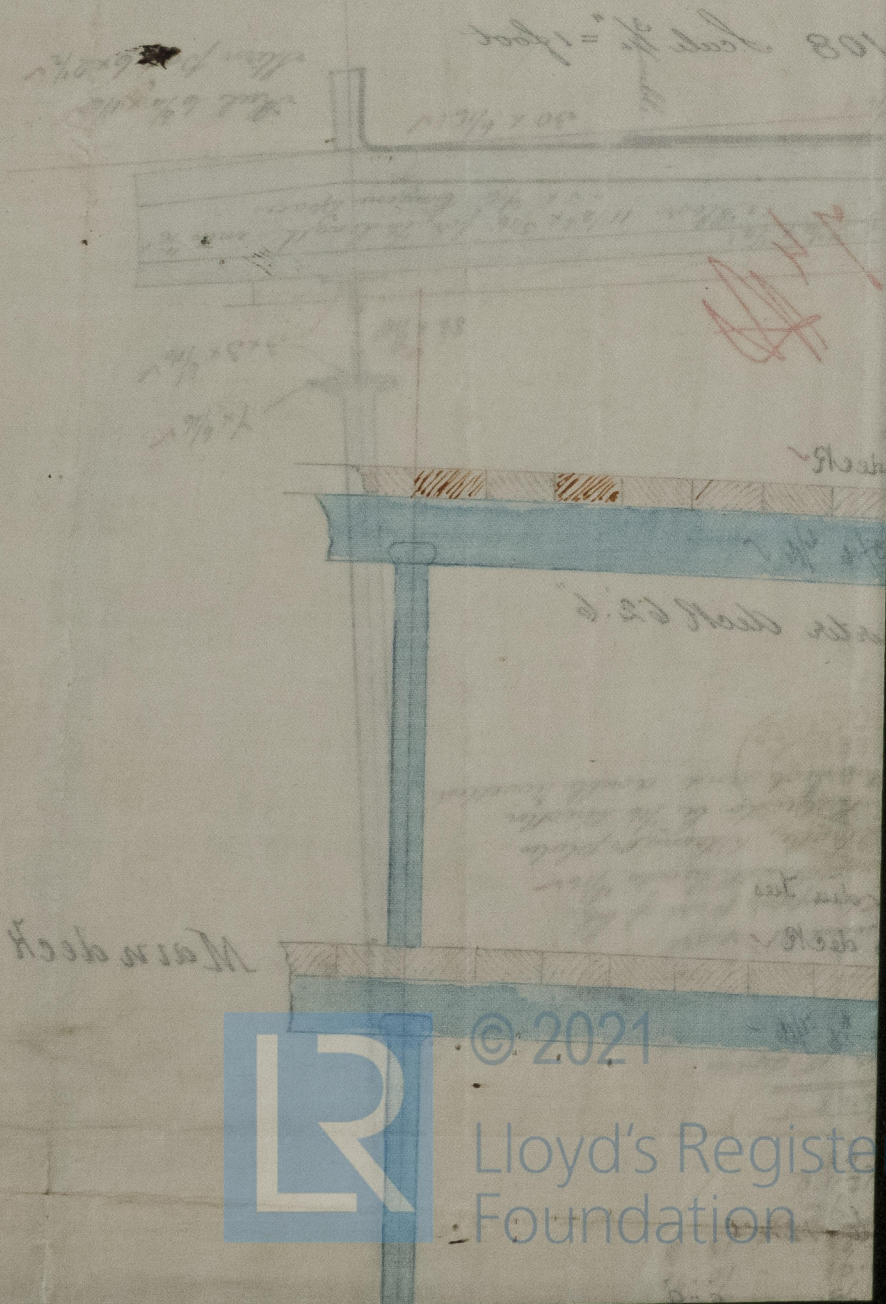

© 2021

Lloyd's Register
Foundation