
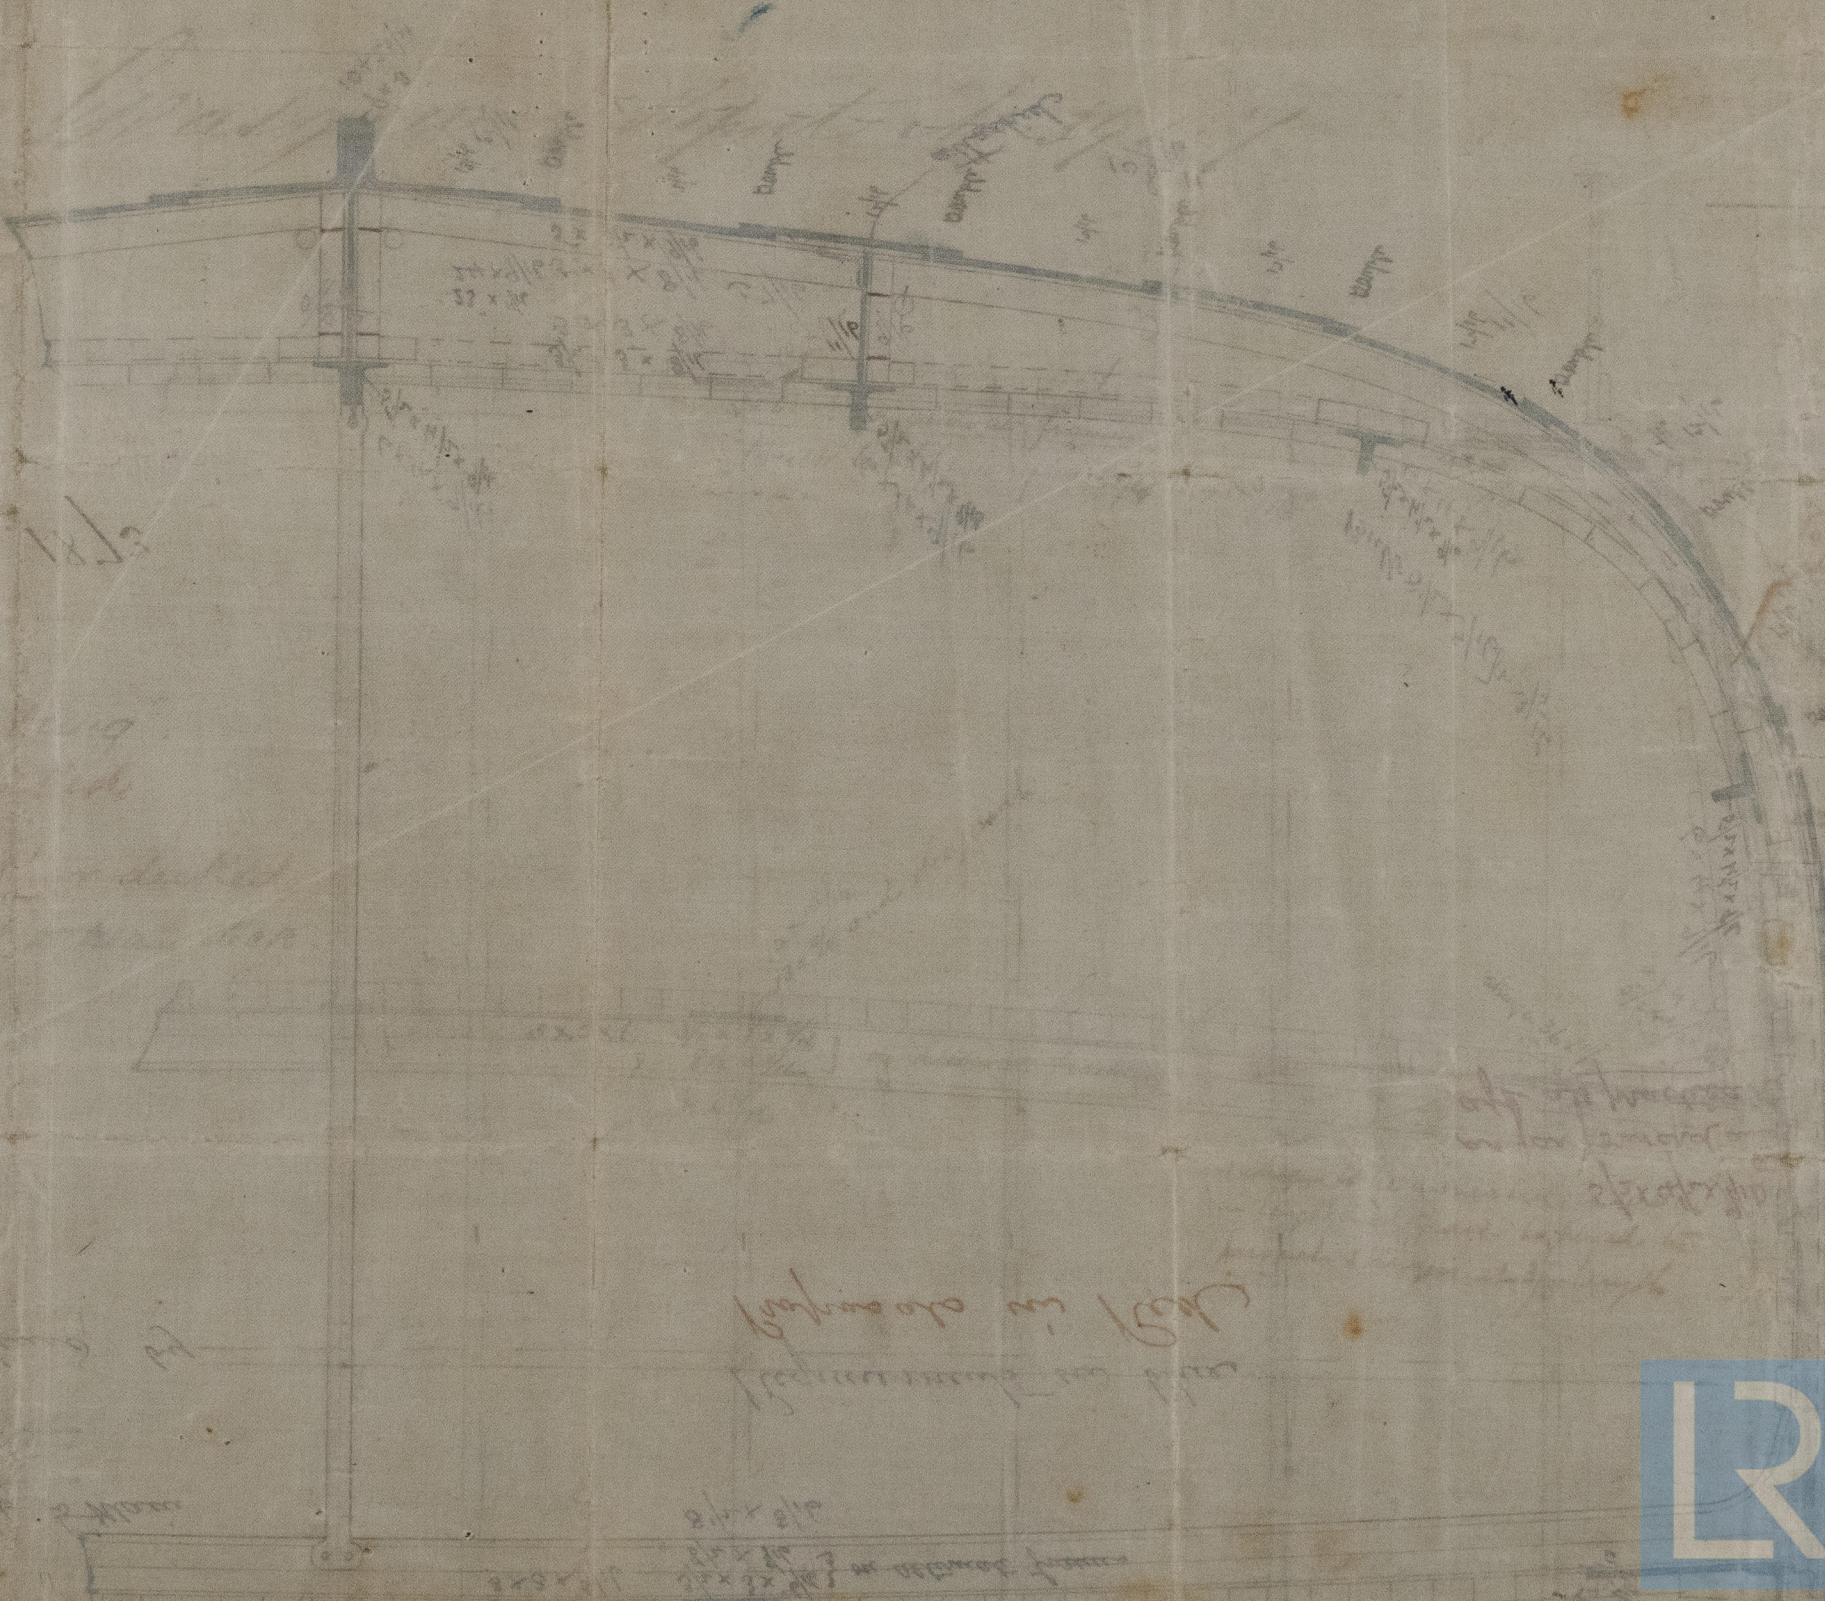


Lloyd's Register
Foundation

55/6/73
W.S.

Mr. C. J. L. Litten
1st Sept/73
Litten Litten 23 Sept/73

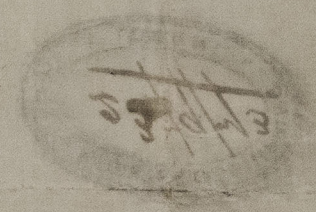

12th Sept 1873
ENGINEERS & SHIPBUILDERS

at present under construction
proposed to be constructed
at present under construction

IRONSID - 0046

at present under construction
proposed to be constructed
at present under construction

at present under construction
proposed to be constructed

13280 Jan



©2021
Lloyd's Register
Foundation