



IRONS10-0097 3/4

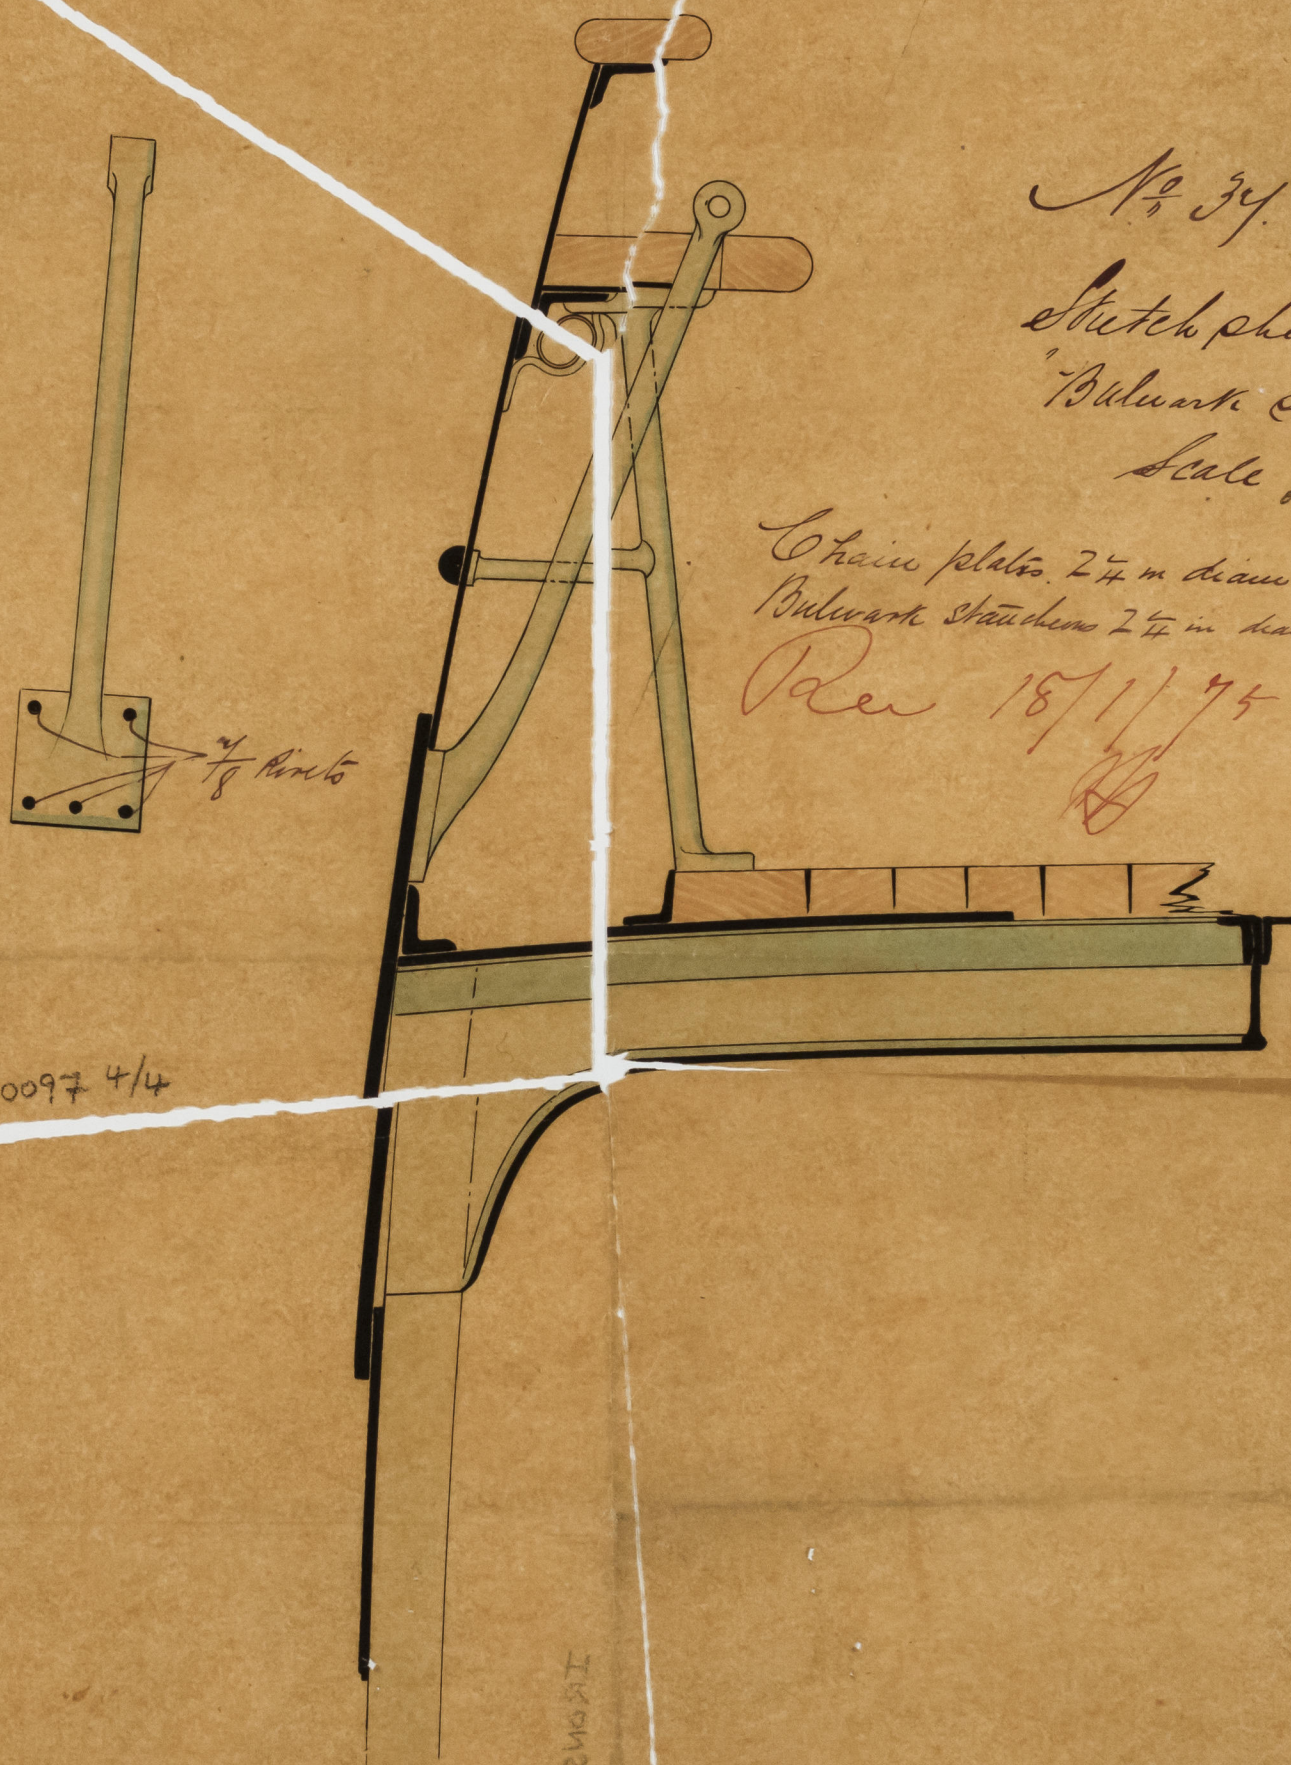

No 34. "Compaction"  
Sketch showing "Chain plates"  
"Bulwark Stanchions" etc  
Scale  $\frac{1}{4}$  inch = one foot.

Chain plates  $2\frac{1}{4}$  in diam  
Bulwark Stanchions  $2\frac{1}{4}$  in diam

Per 18/1/75  
JH

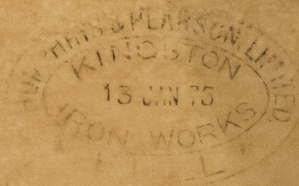

IRONS10-0097 4/4

Jan 13/31.  
Compaction

IRONS10-0097 1/4

IRONS10-0097 2/4

IRONS10-0097 1/4





Lloyd's Register  
Foundation





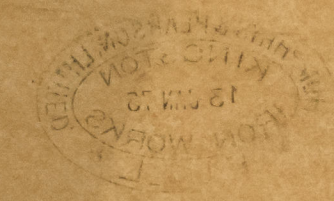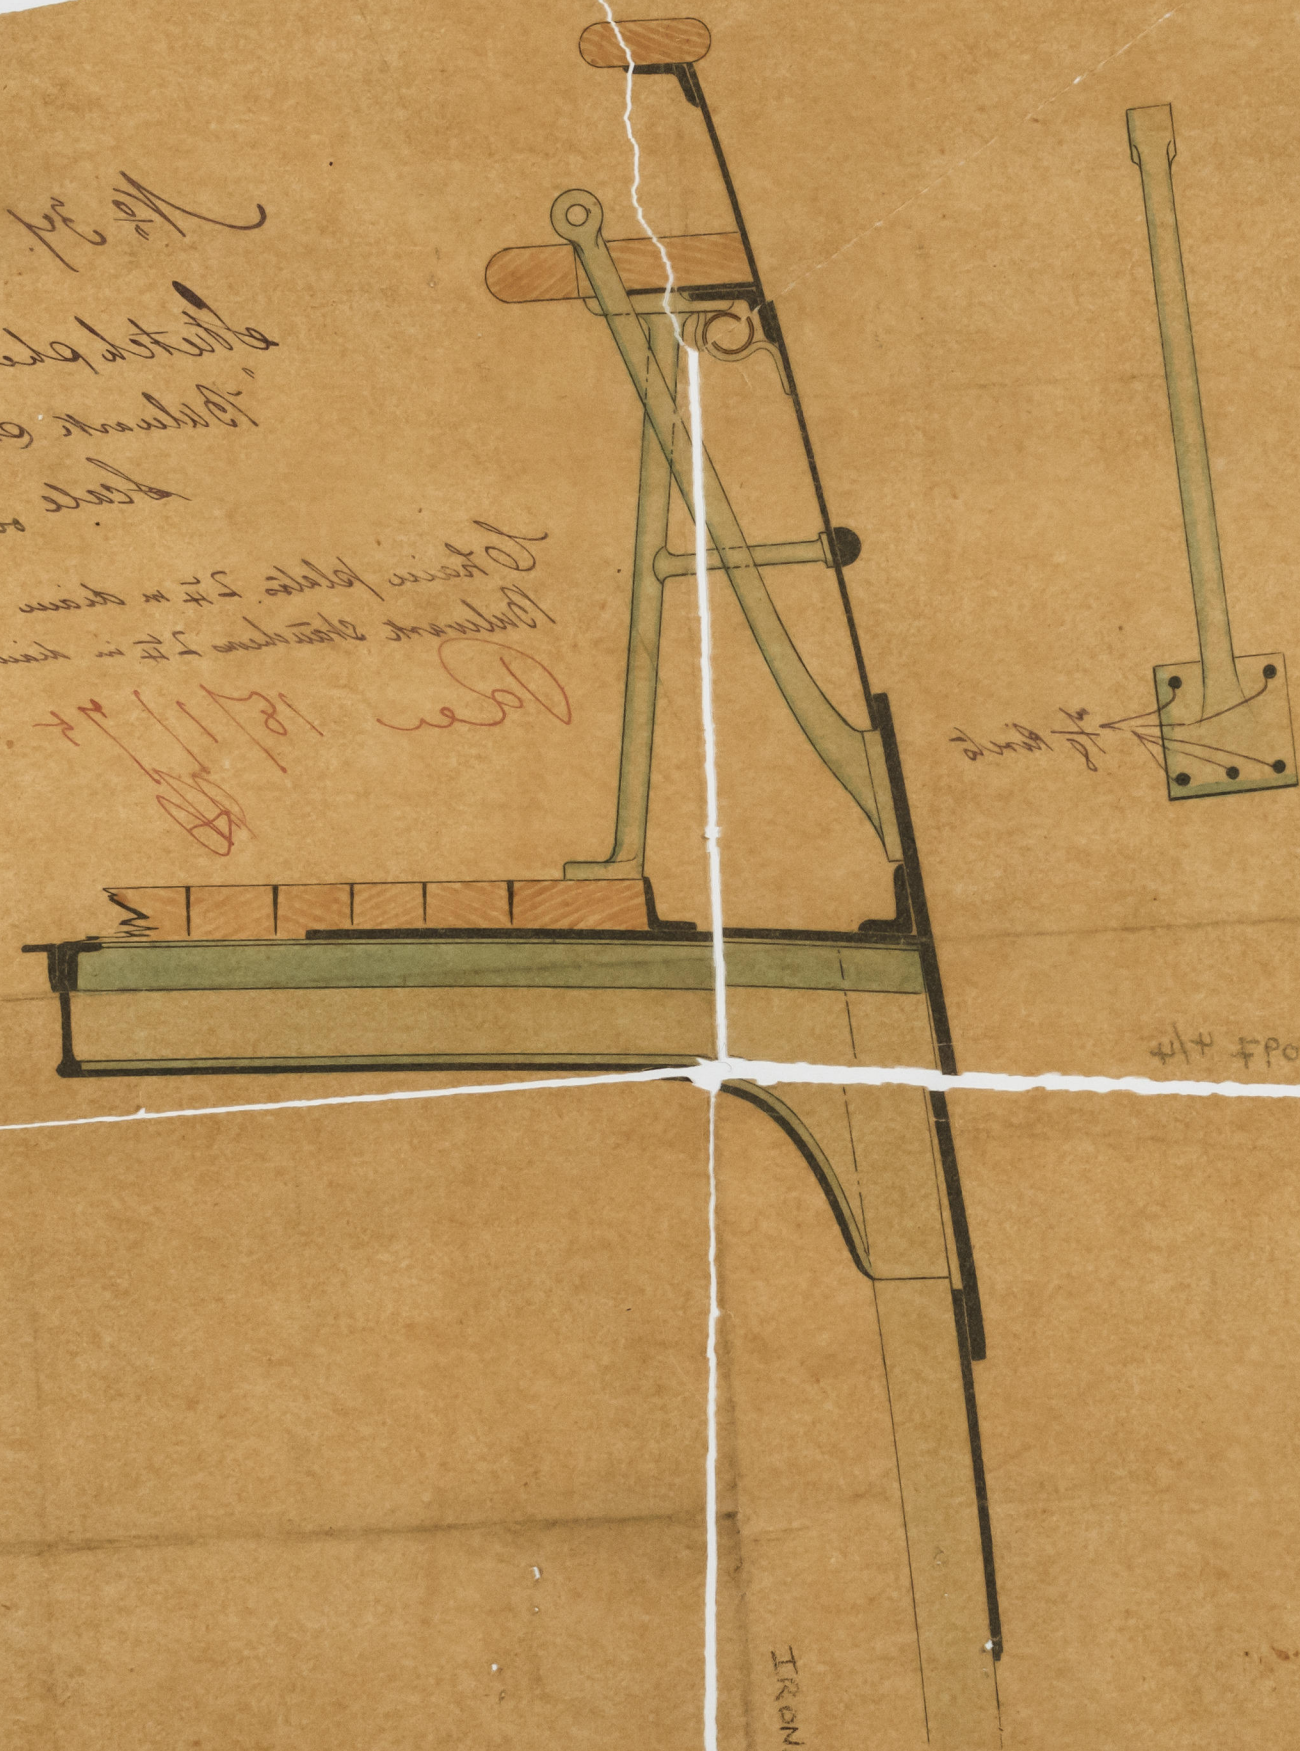

 Jan 13/35