

"Trident" Report No 12670.


Midship Section

Nos 311-312-313

Scale 1/2 inch

Revised by Mr
No 12670

Rev 13/1/74 & 14/2/74

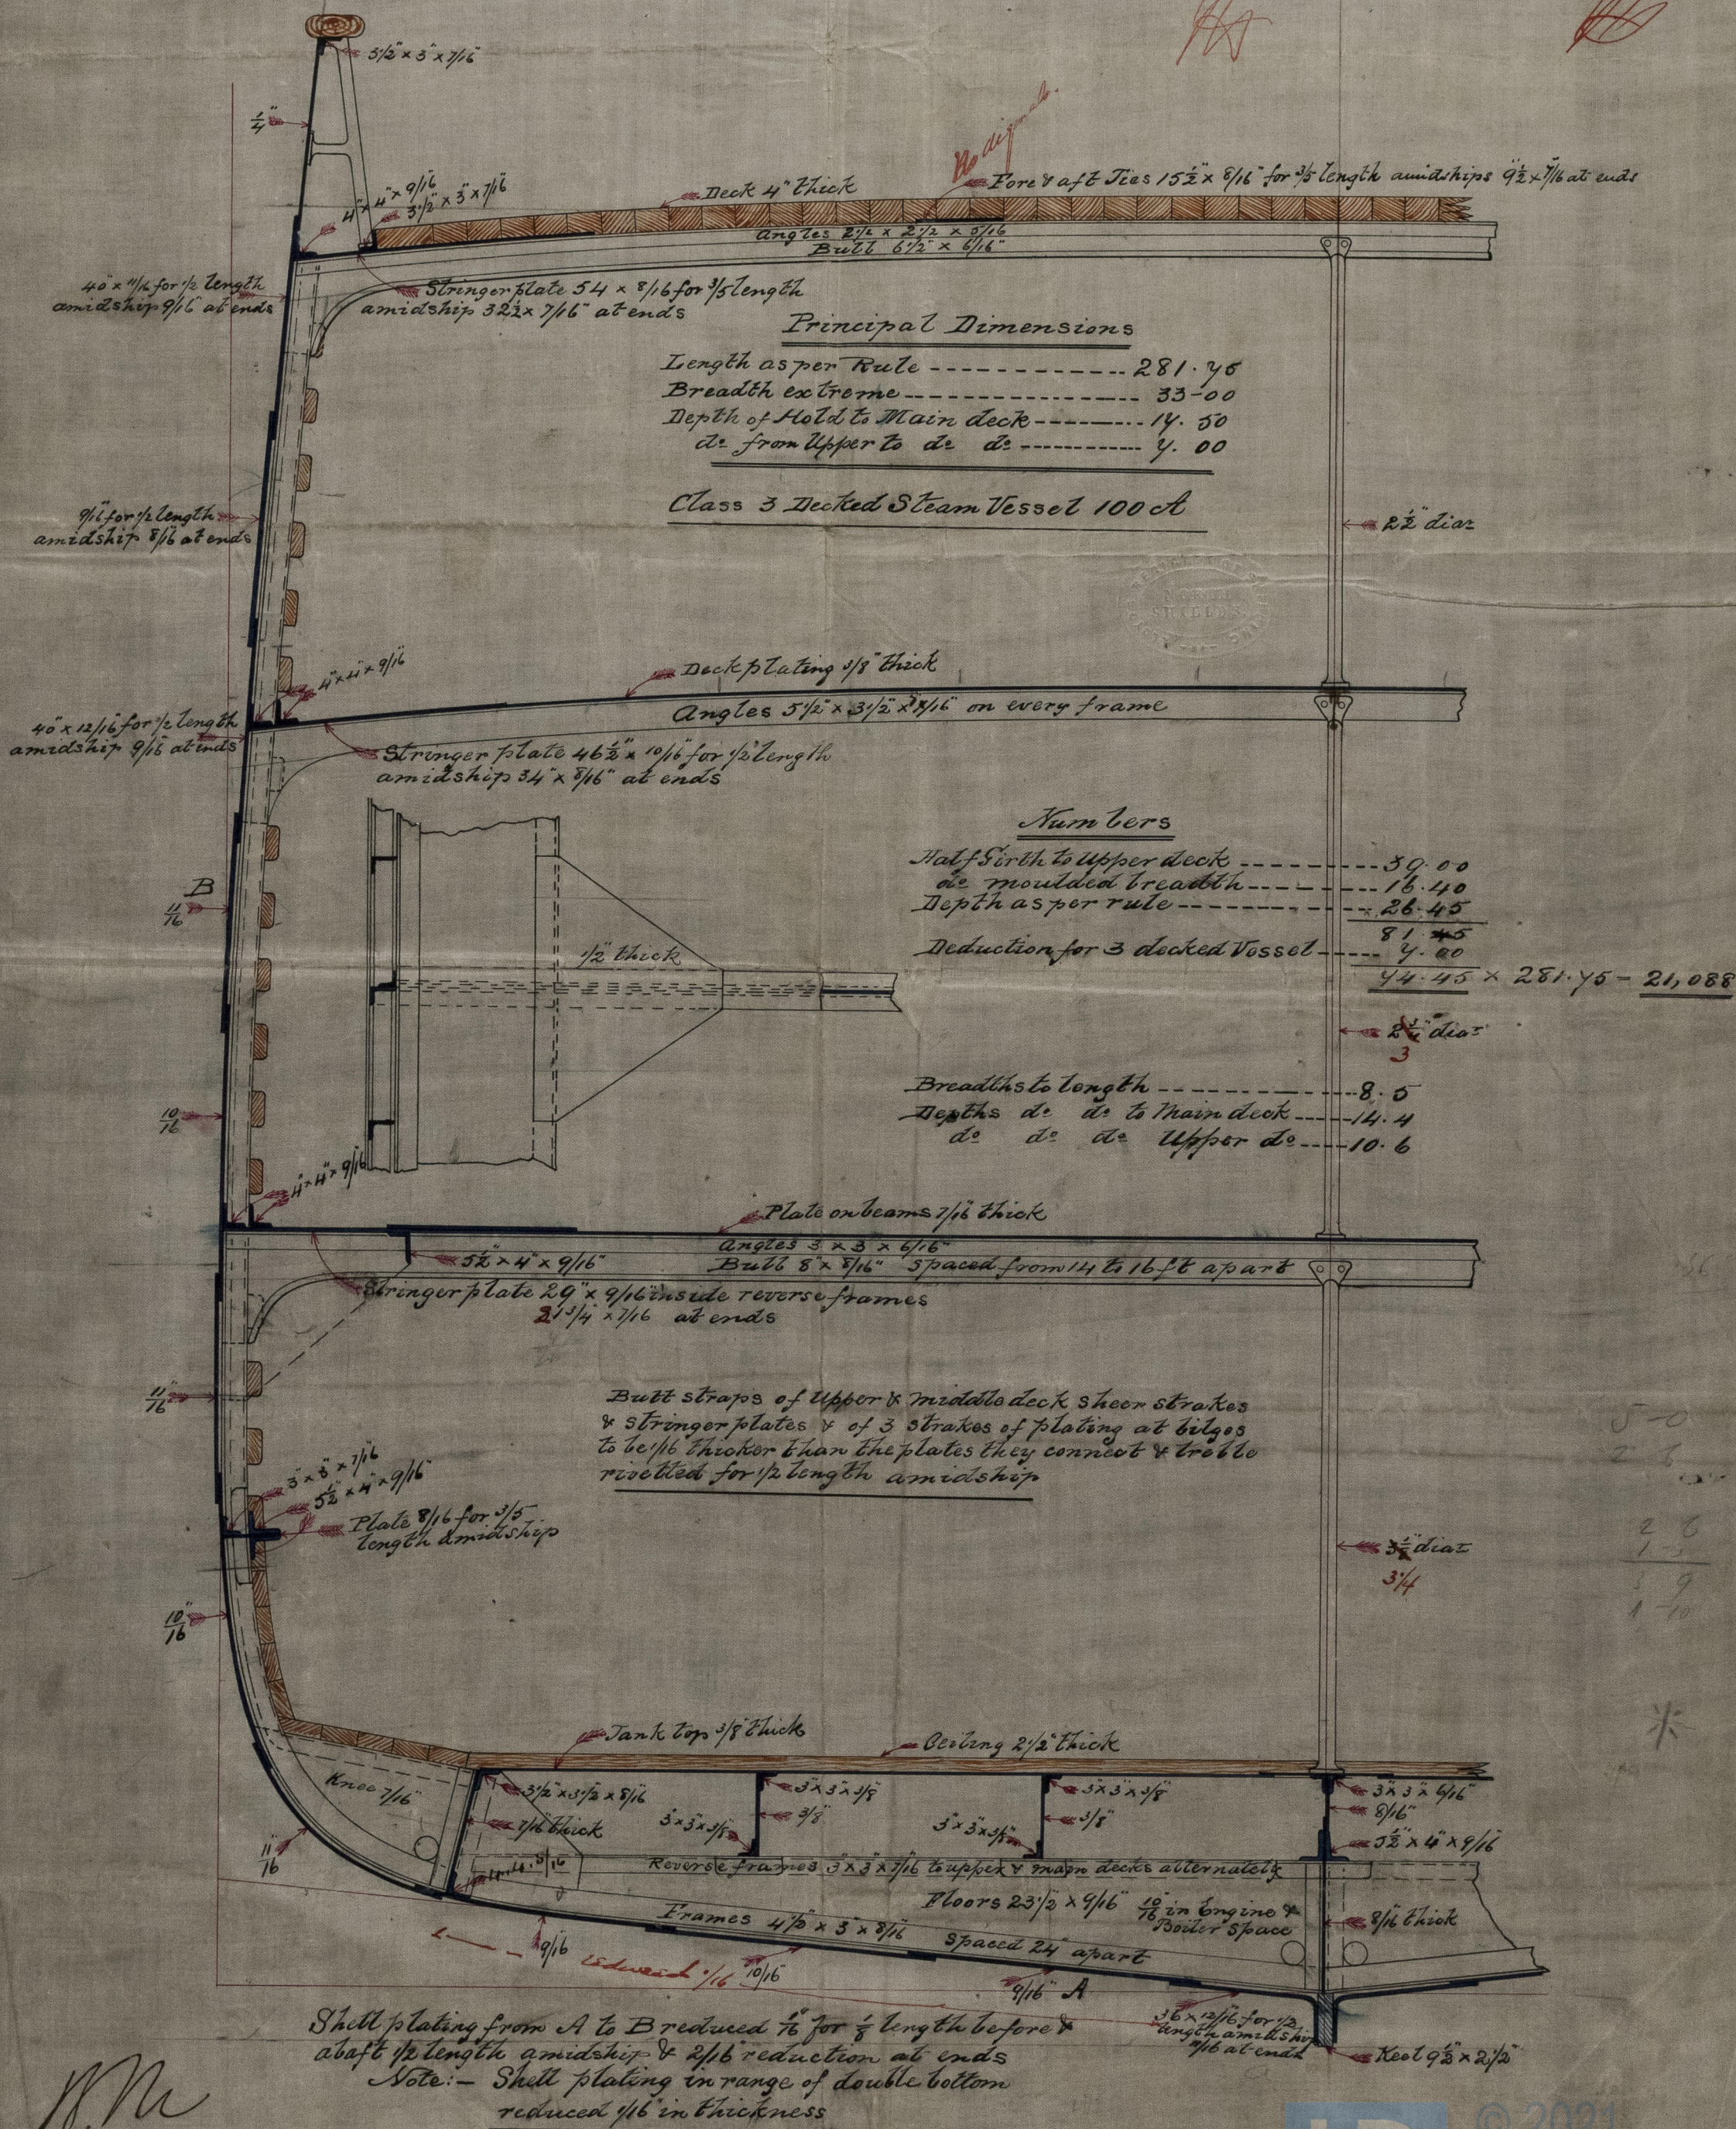

M. M.
24/1/74

10/10

10/10



IRONSIO-0133



© 2021
Lloyd's Register
Foundation