

SCOTT & CO.
22 JAN 1874
CARLSDYKE GREENOCK

Midship Section.
Sailing Ships No. 15849.

Length. --- 230 ft.

Breadth moulded. 35' 10".


Depth. do. --- 22' 3".

do. from top of keel to top of main deck beam. 23' 3".

Index Nos. Lloyd's Rules. 45' 6" + 14413.

To Class A. 100.

Scale 1/2 inch = 1 foot.

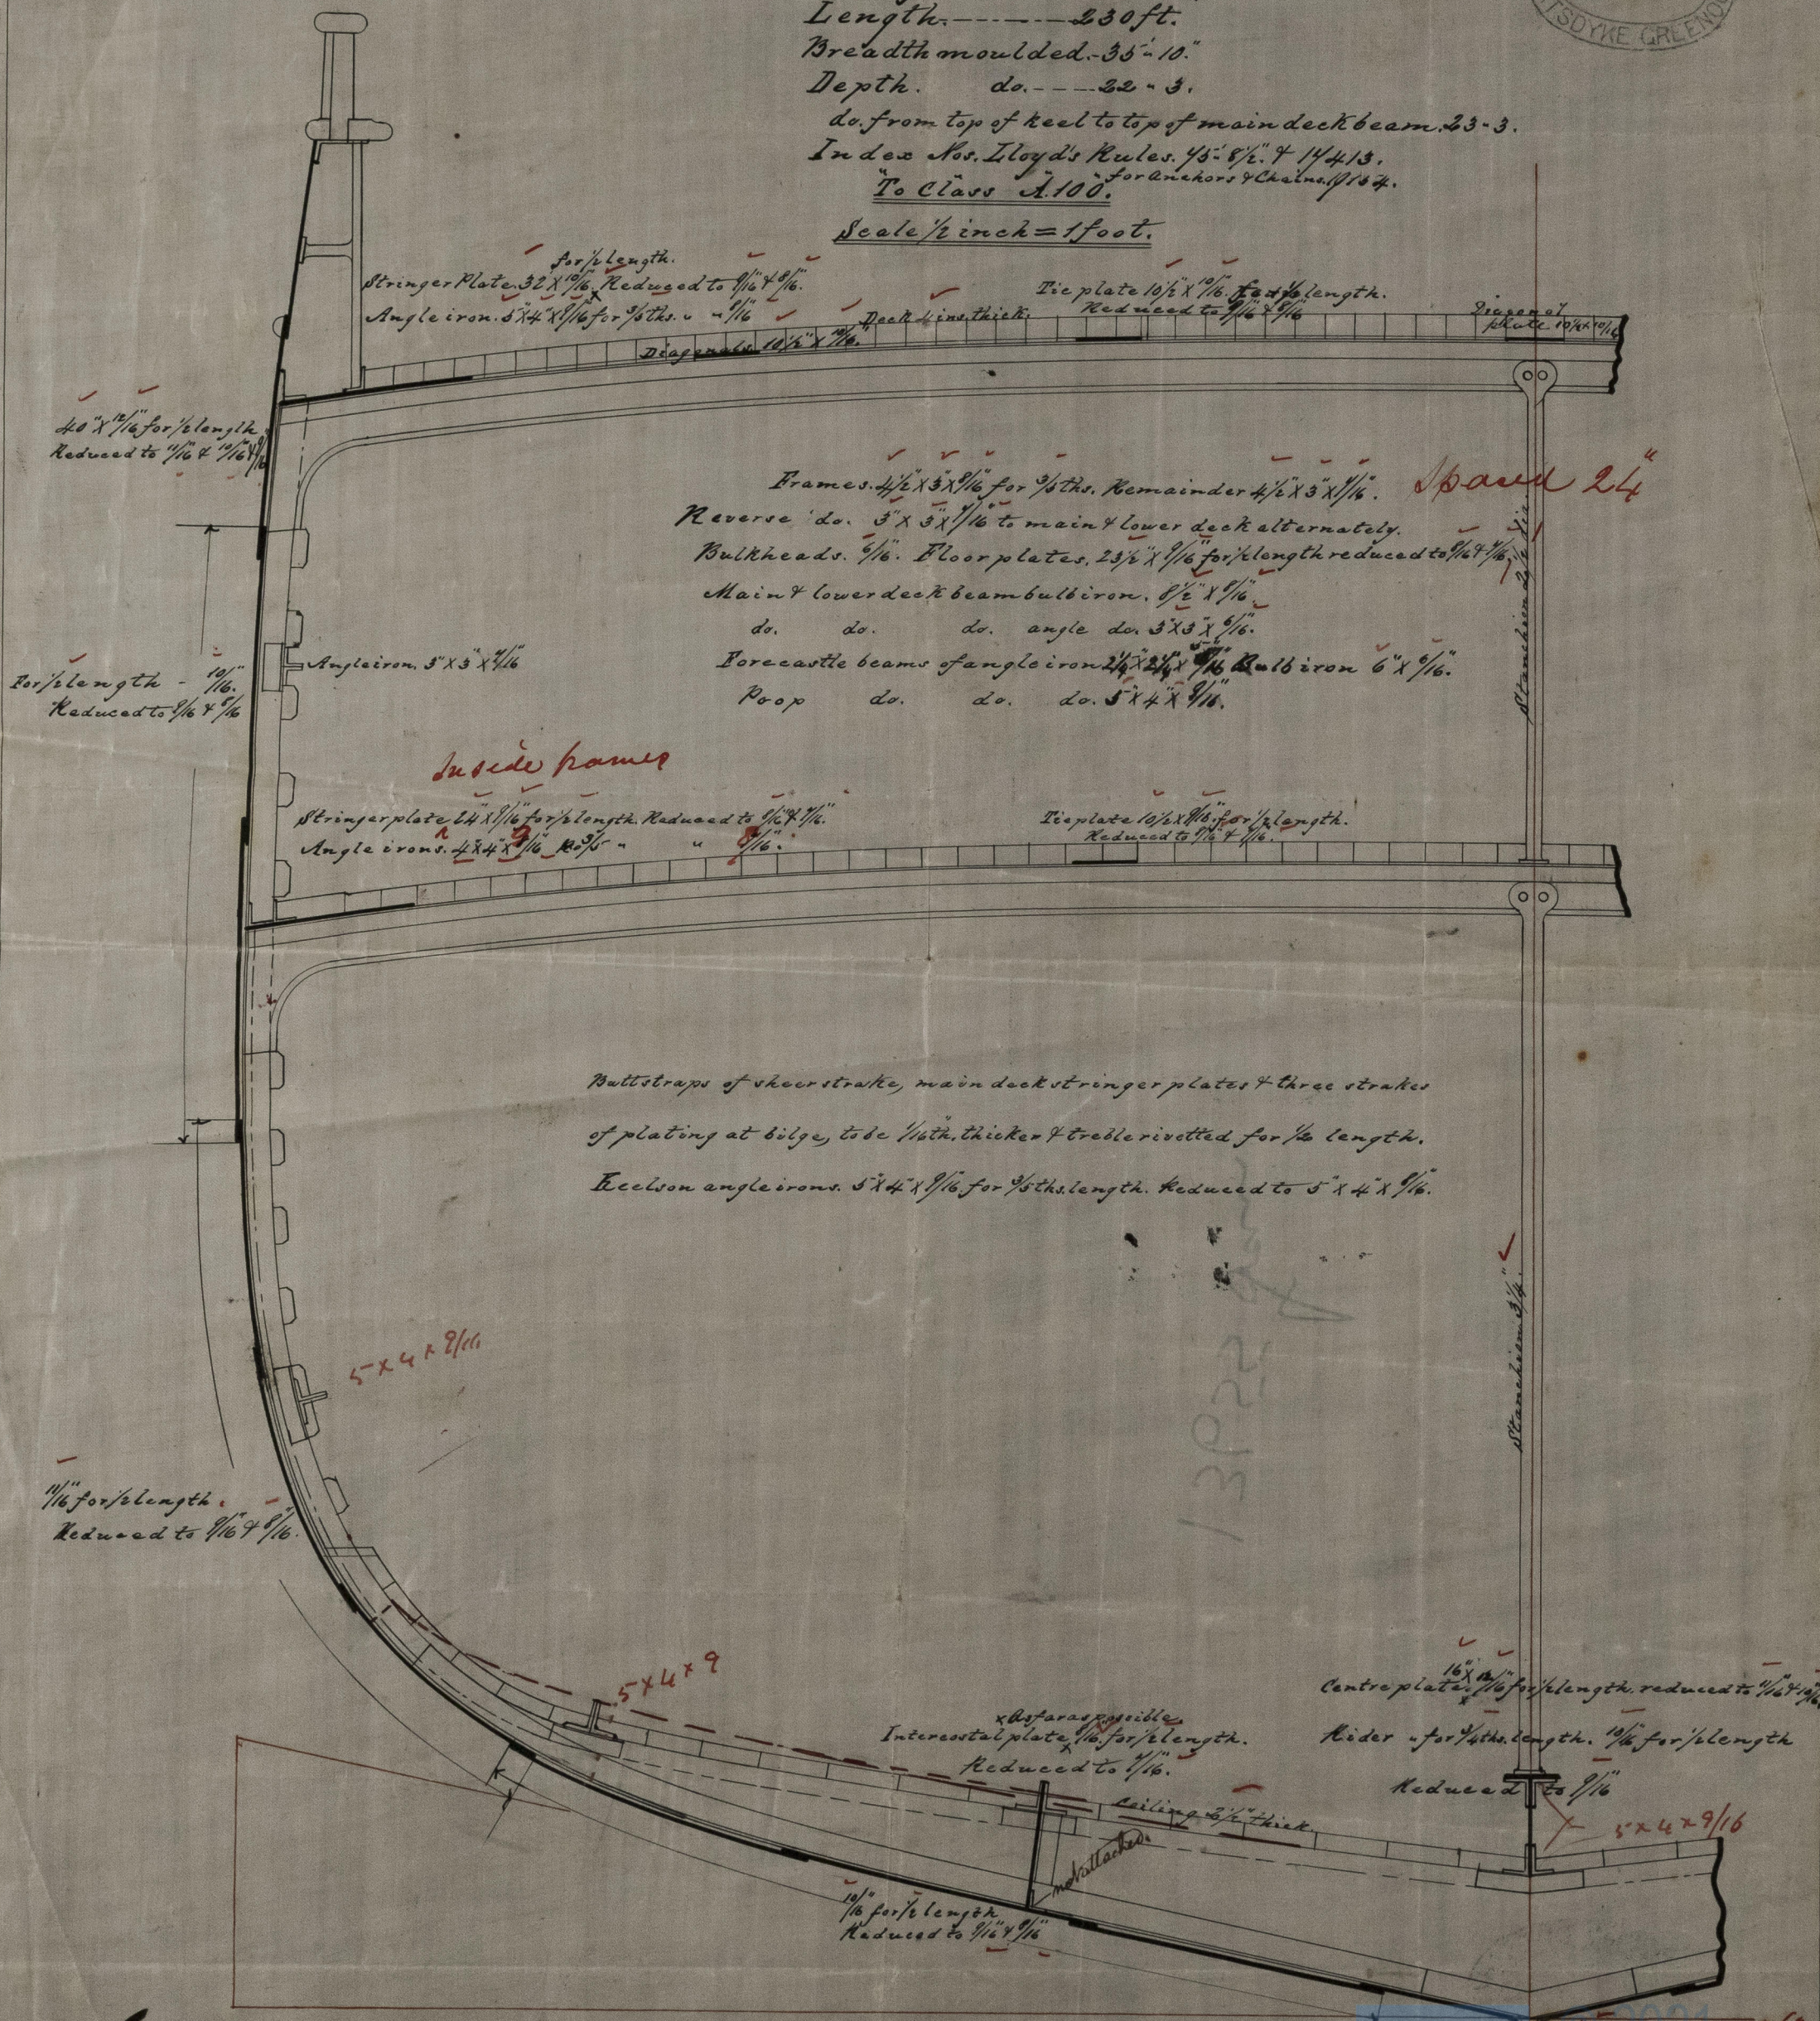

Scott & Co.

Ex & N/13 27.1.74

36

Lloyd's Register
Foundation

IRON 510-0140

13655 Jan

IRONS10-0140



© 2021

Lloyd's Register
Foundation