

Proposed
 Bull 6x4 3/4
 Double angles 3x2 1/2
 angle from 3x3 1/2


Half Breadth plan showing Stringer in Engine & Boiler Rooms N^o 125 Vessel
 Scale 1/2" = 10 feet

Scarf of Bull & angles 16ft through in Fore Hold

Scarf of Bull & angle to Cabin Deck Stringer

this stringer to be carried to the Smoke box of Boiler

this stringer to rough & frame and attached to the outside plating this whole length

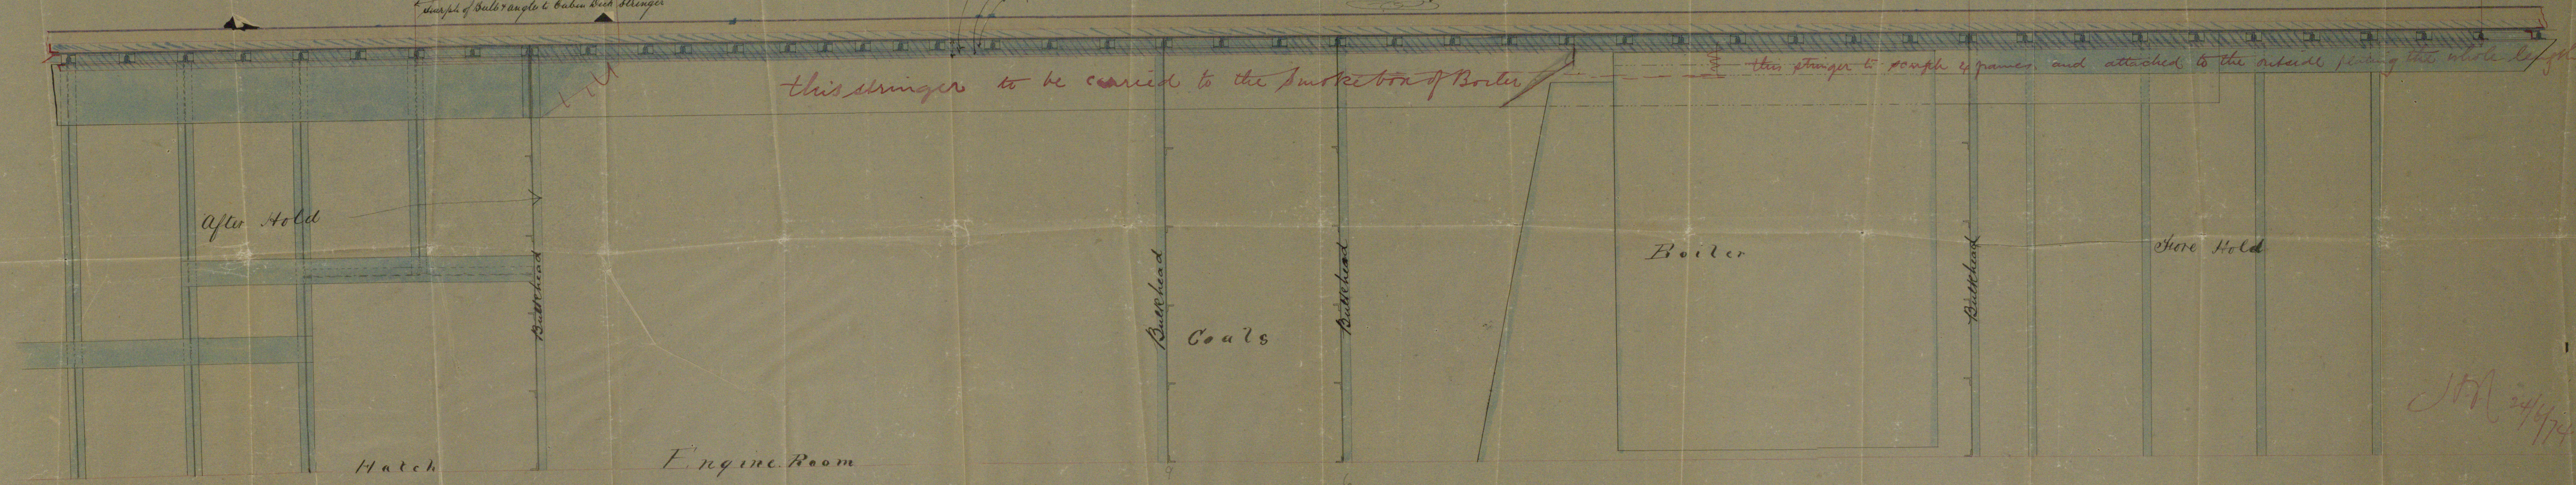

After Hold

Bulkhead

Hatch

Engine Room

Bulkhead

Coals

Bulkhead

Boiler

Bulkhead

Fore Hold

J. H. 24/4/74
 1053

