


Proposed Continuation of Cabin  
Deck Stringer through  
Engine Space of No. 125 Vessel  
Scale 3" to one foot

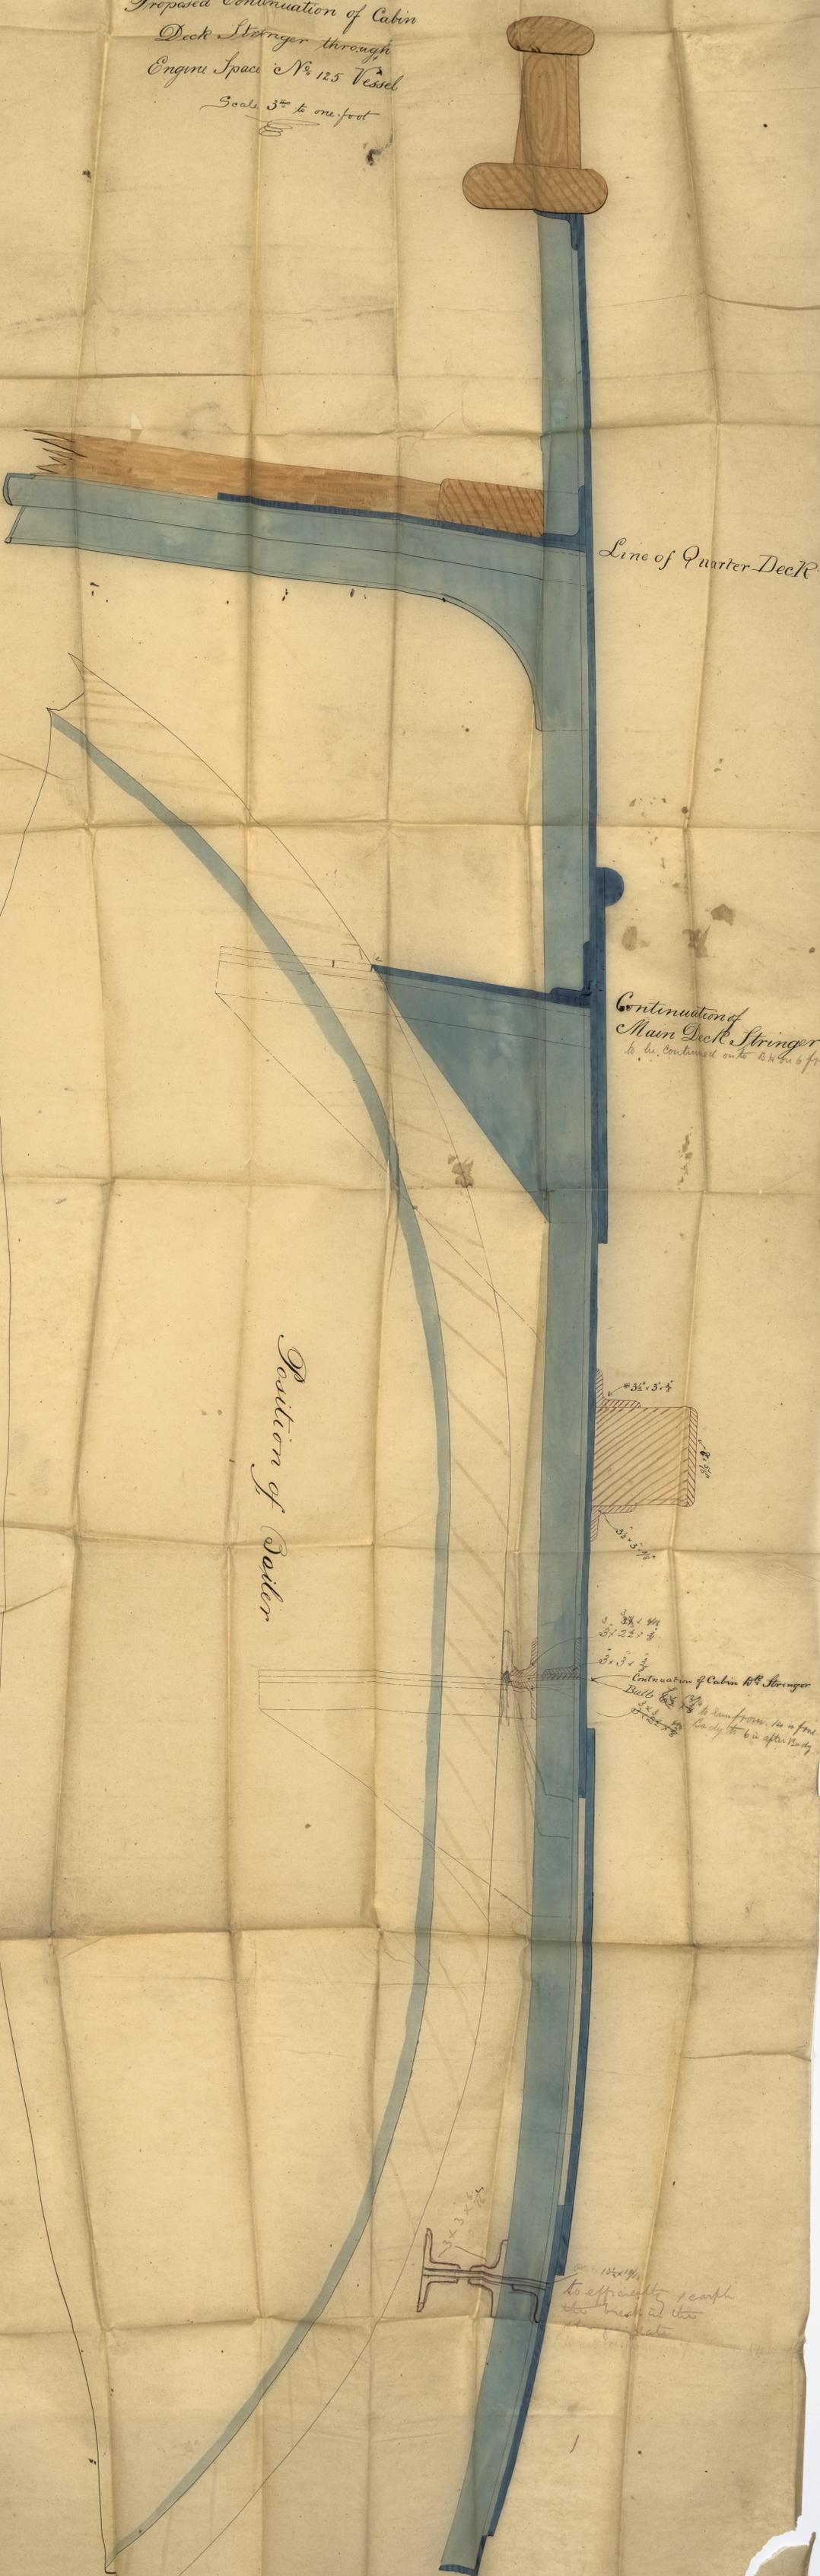

Position of Boiler

Line of Quarter-Deck

Continuation of Main Deck Stringer  
to be continued onto 18 1/2 ft from

Continuation of Cabin 10' Stringer  
Beams to be removed, as in plan  
ready to be in after Body

to apparently scaph  
the mesh at the  
of the plate


IRON 510-0154