

DIMENSIONS. 240' x 38' x 22.7."

DIMENSIONS. 240' x 38' x 22.7."

*Scramblings to Lloyd's for 100 A. Class*

Na 23, 05, 06

Rudder Stock 6" diam - Mast 3 1/2"  
Forward Bulkhead 7/16" to Deck

Forward Bulkhead  $2/16"$  to Deck

Half Girth = 38.38  
 " Breadth = 19.00  
 Depth = 27.83  
Numeral = 87.41  
 240  
 325640  
 16212  
Numeral = 1953840

In Breadth = 19.00

$$\frac{\text{Depth}}{\text{Number}} = \frac{21.8}{91.1}$$
$$\begin{array}{r} 817 \\ 2 \\ \hline 1634 \end{array}$$

16282

Numeral = 19538

Proportions { Beams 6.315  
Depths 9.665

Depths - 9.665 -

Planks  $5' \times 3\frac{1}{2}' \times \frac{9}{16}'$  spaced 24 inches apart.  
Reverse do  $3\frac{1}{2}' \times 5' \times \frac{9}{16}'$  — Floors  $24\frac{1}{2}' \times \frac{10}{16}'$

Reverse do  $3\frac{3}{4} \times 3\frac{8}{16}$  — Floors  $24\frac{1}{2} \times 10\frac{16}{16}$

*Equipment (between 1400 and 1600 Tons)*

2 Bower Anchor 34 cwt. ex. Stock Post 31<sup>12</sup>/<sub>20</sub>

1 Dec Dec 29 " " "

1 Stream " 13 $\frac{1}{2}$  " with Stock


1 Ridge " 6<sup>3</sup>/<sub>4</sub> " "

1 D. 3 1/4 " "

240 Fathoms Silver Chain Cable  $1\frac{1}{16}$

30 " " Stream 1  
30 " " " "

20 " 10 inch Staves

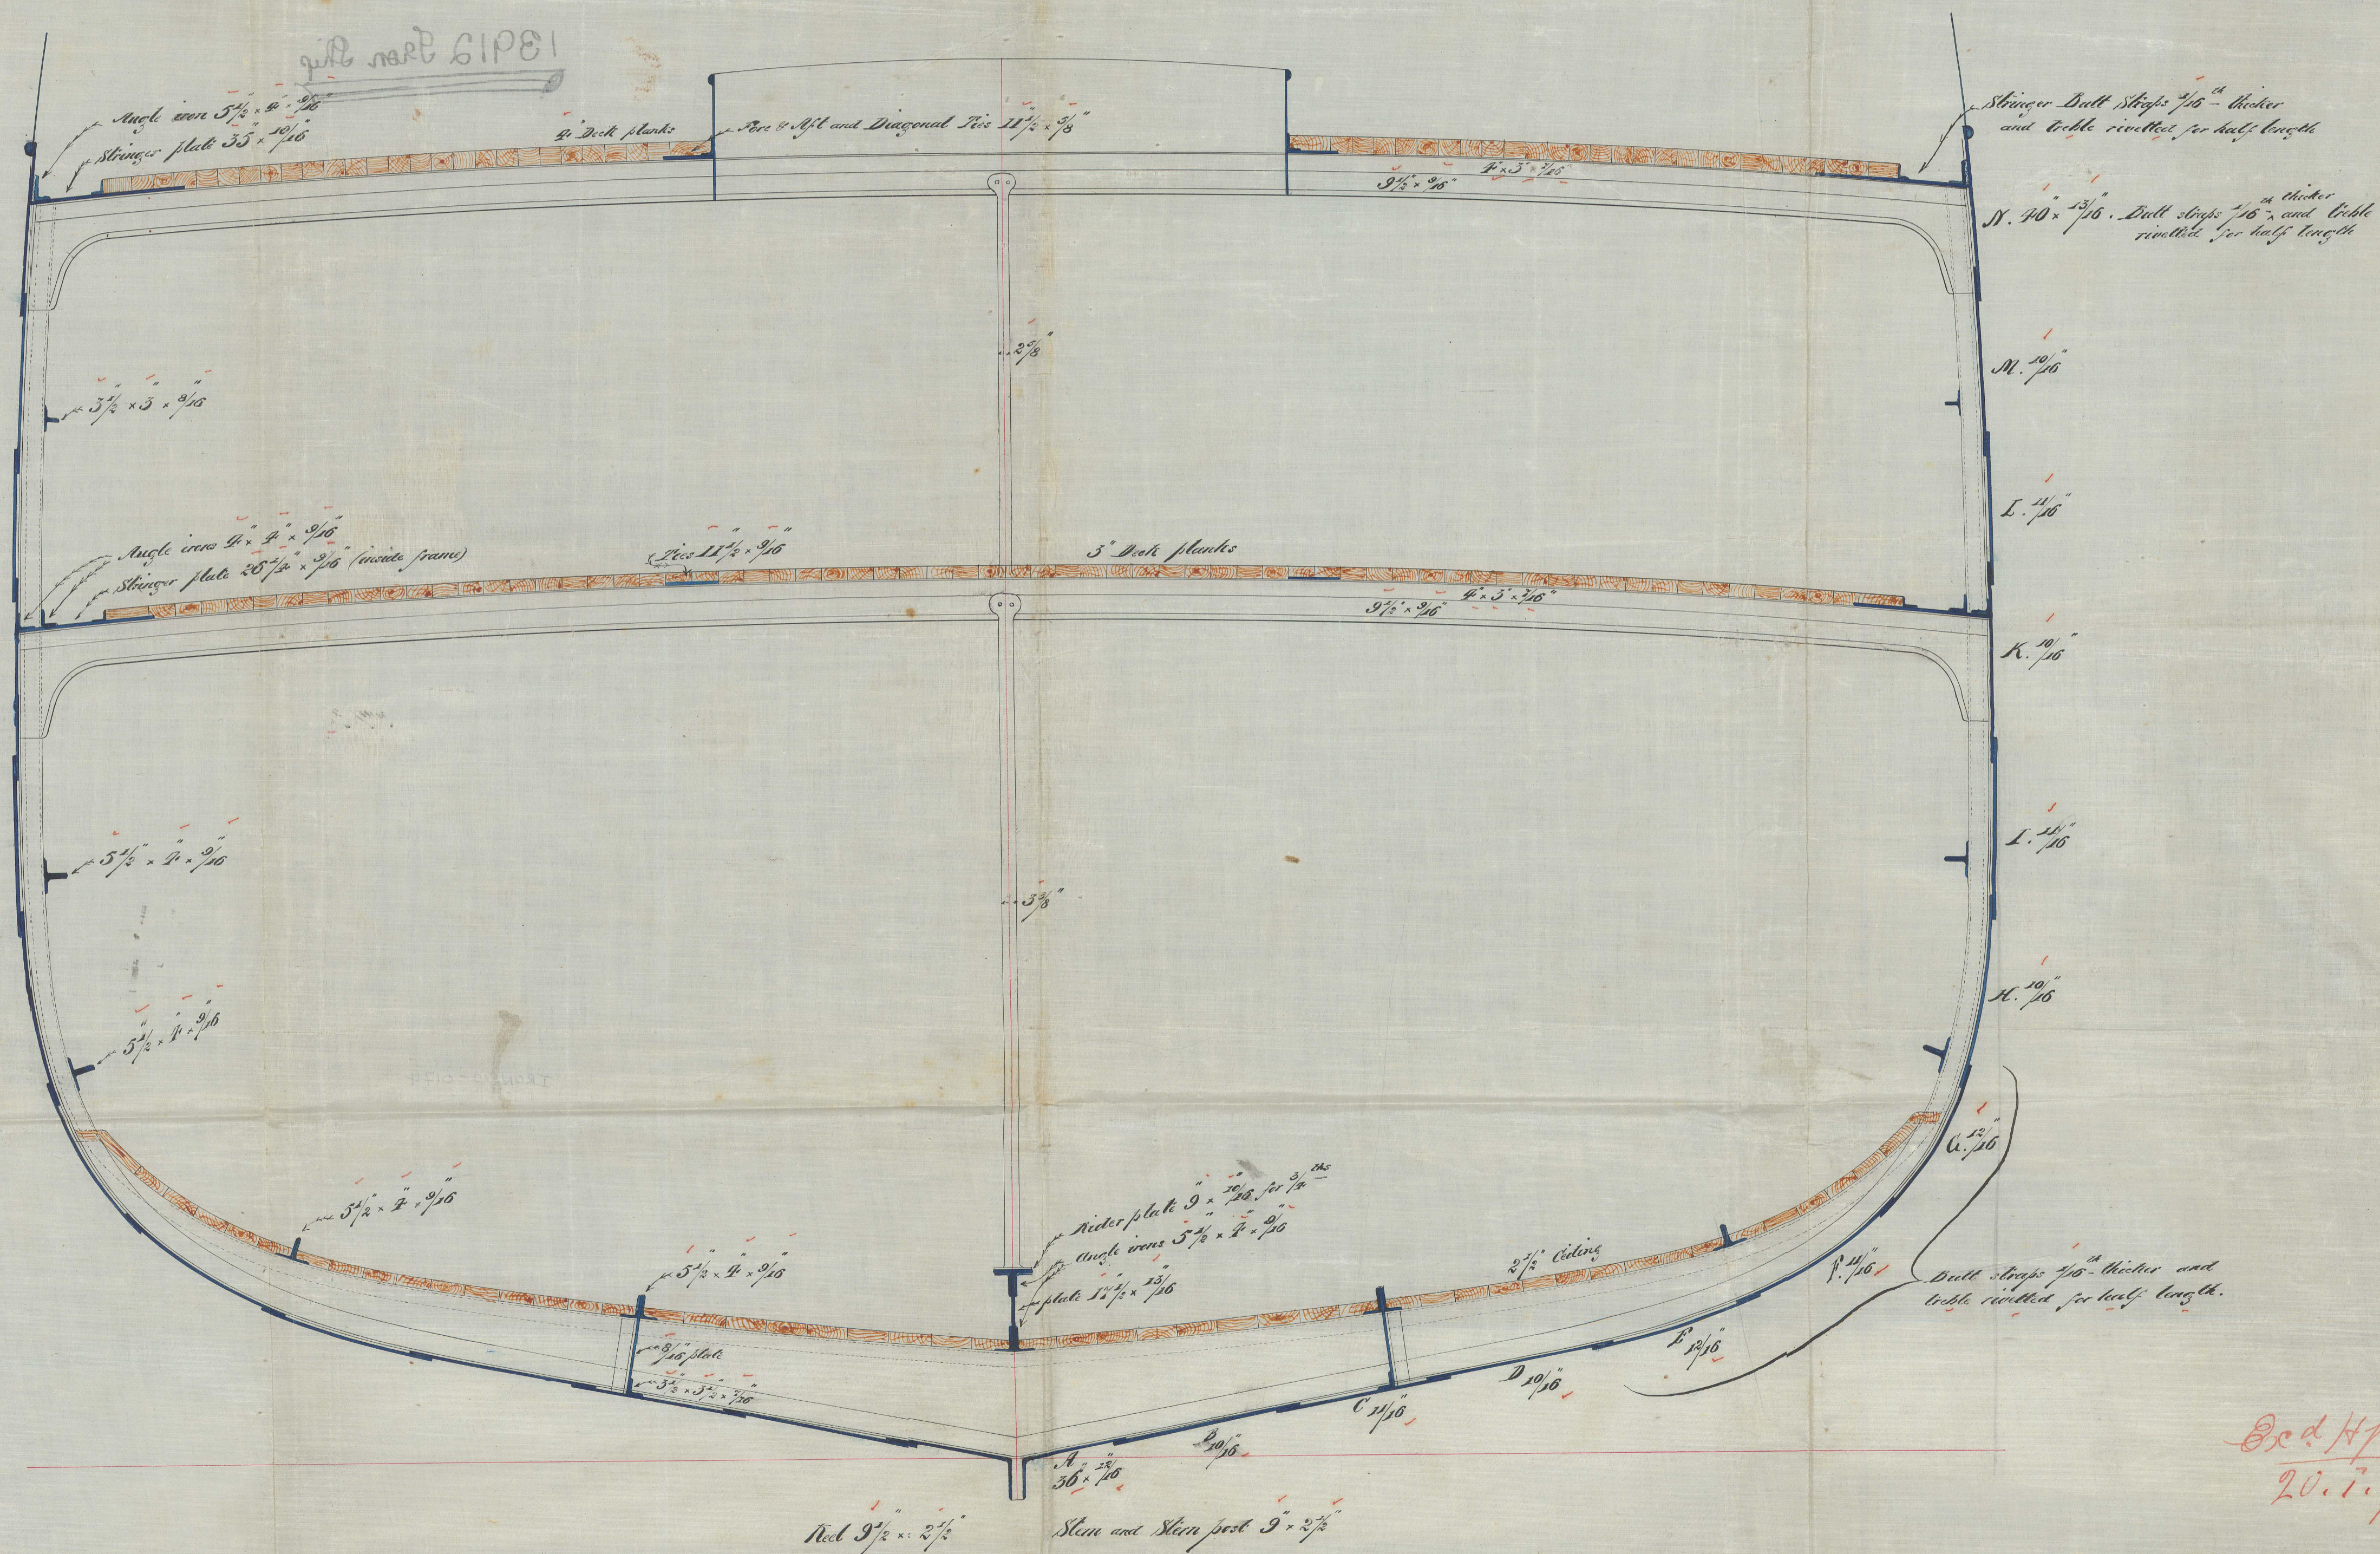

Lloyd's Register  
Foundation  
ONS10-0174

IRONSIO-0174