


13914 Iron

The Jib, topst. & Royal stays only
are attached to the Bowsprit.
The Topmast & Fore staysail stay are
secured to ships.

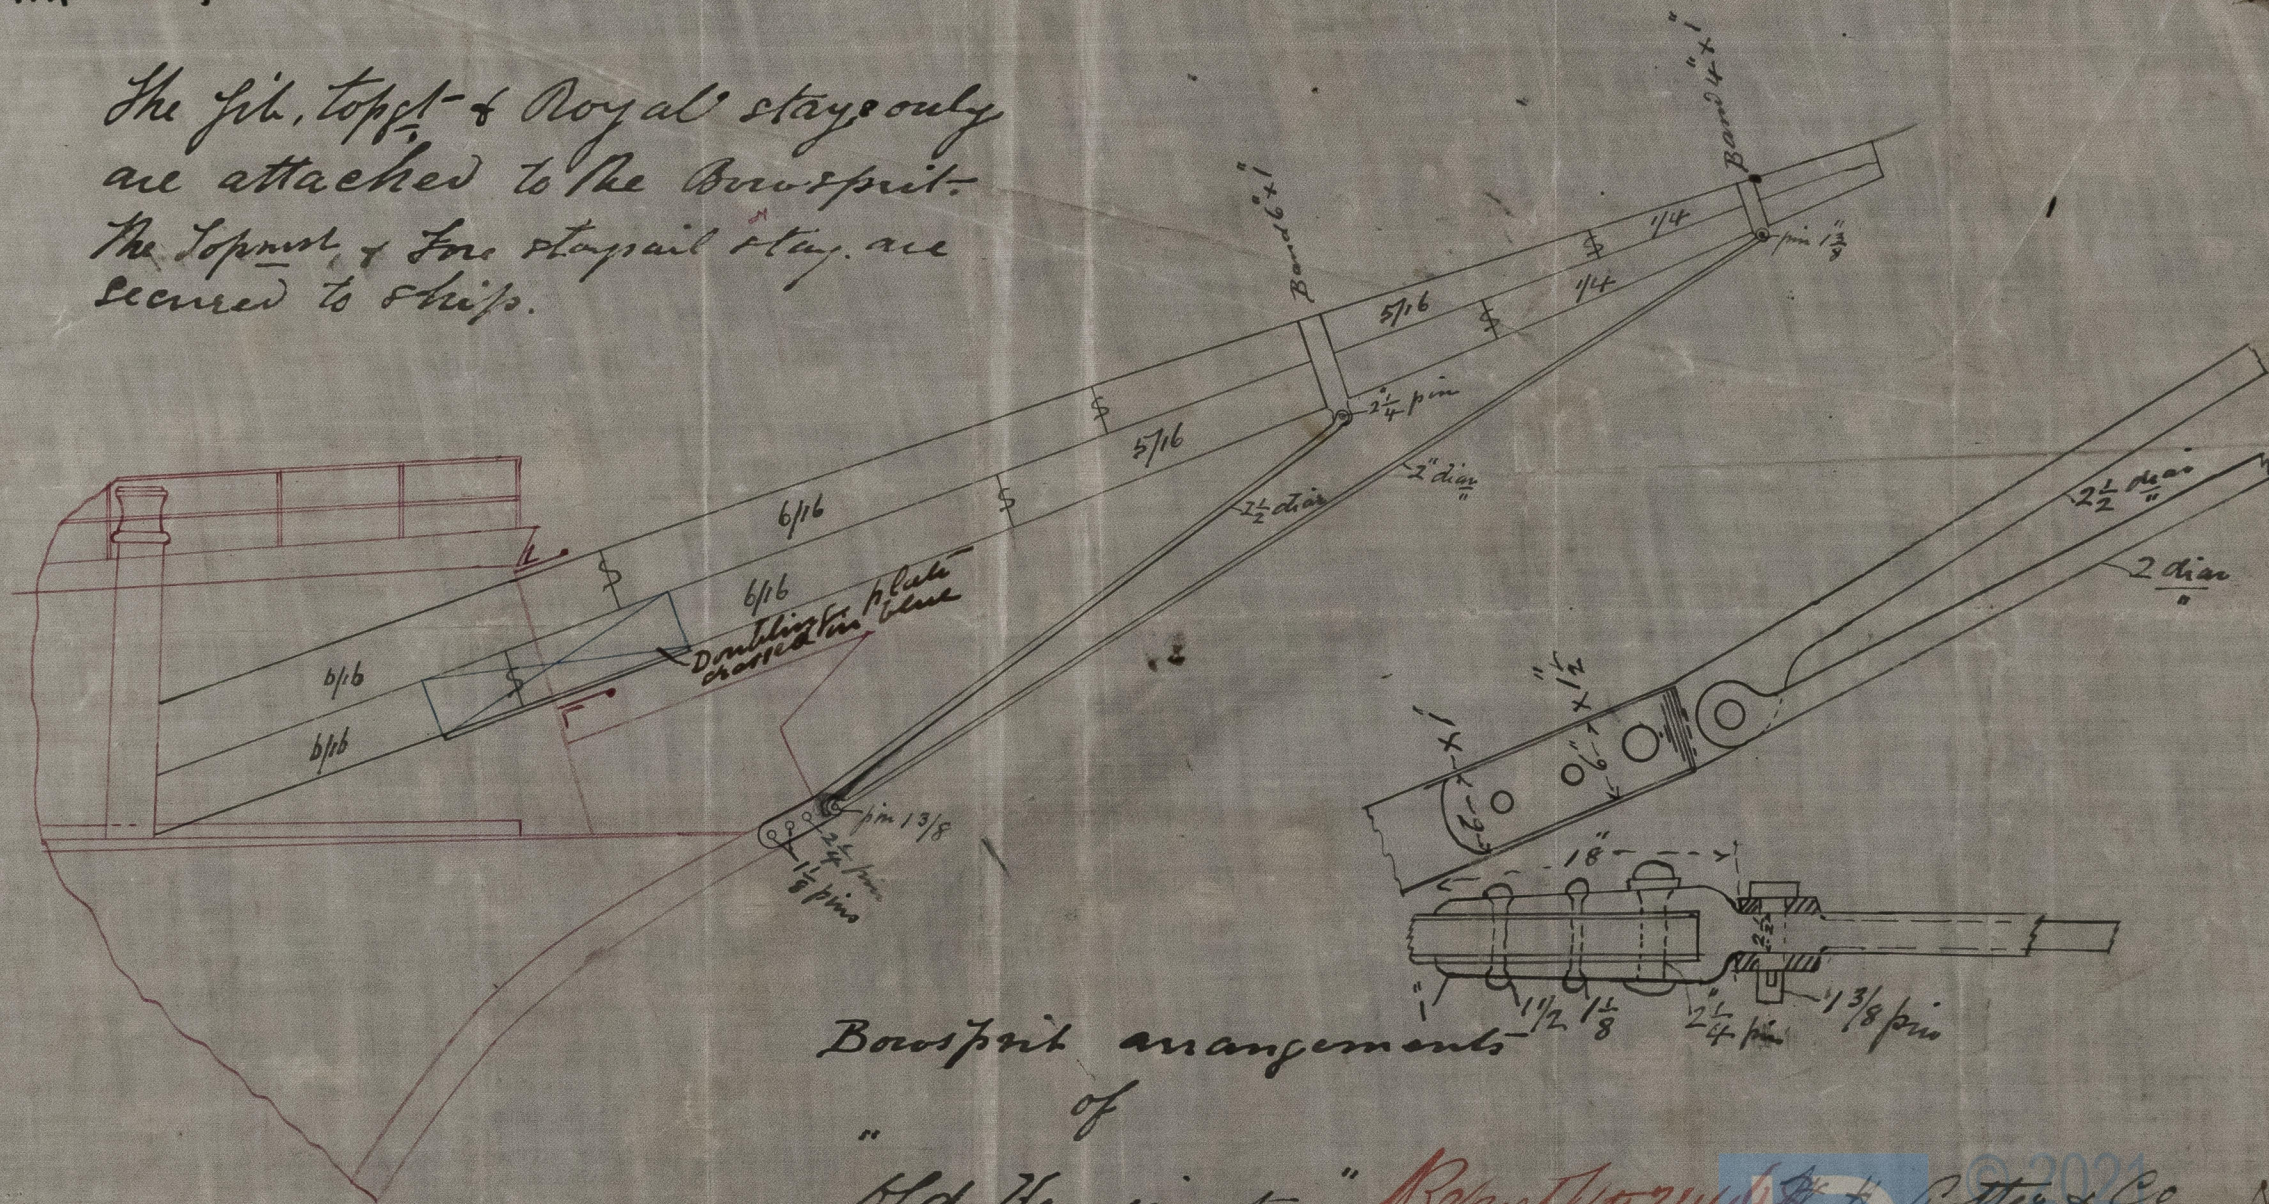

Bowsprit arrangements
" of

Old Kensington

No 50 Ships

Scale $\frac{1}{4} = 1 \text{ foot}$

Report No 2448 H. H. Potter & Co.

R. L. Orr
Nov. 28/175

Ship Builders &c
Lincoln's Inn
Per. R. 7

IRONSD-0175

