


S.S SUMIDA
13932 Exons

S S . N^o 69 & 70

2 ~~3~~ DECK STEAMERS 100A

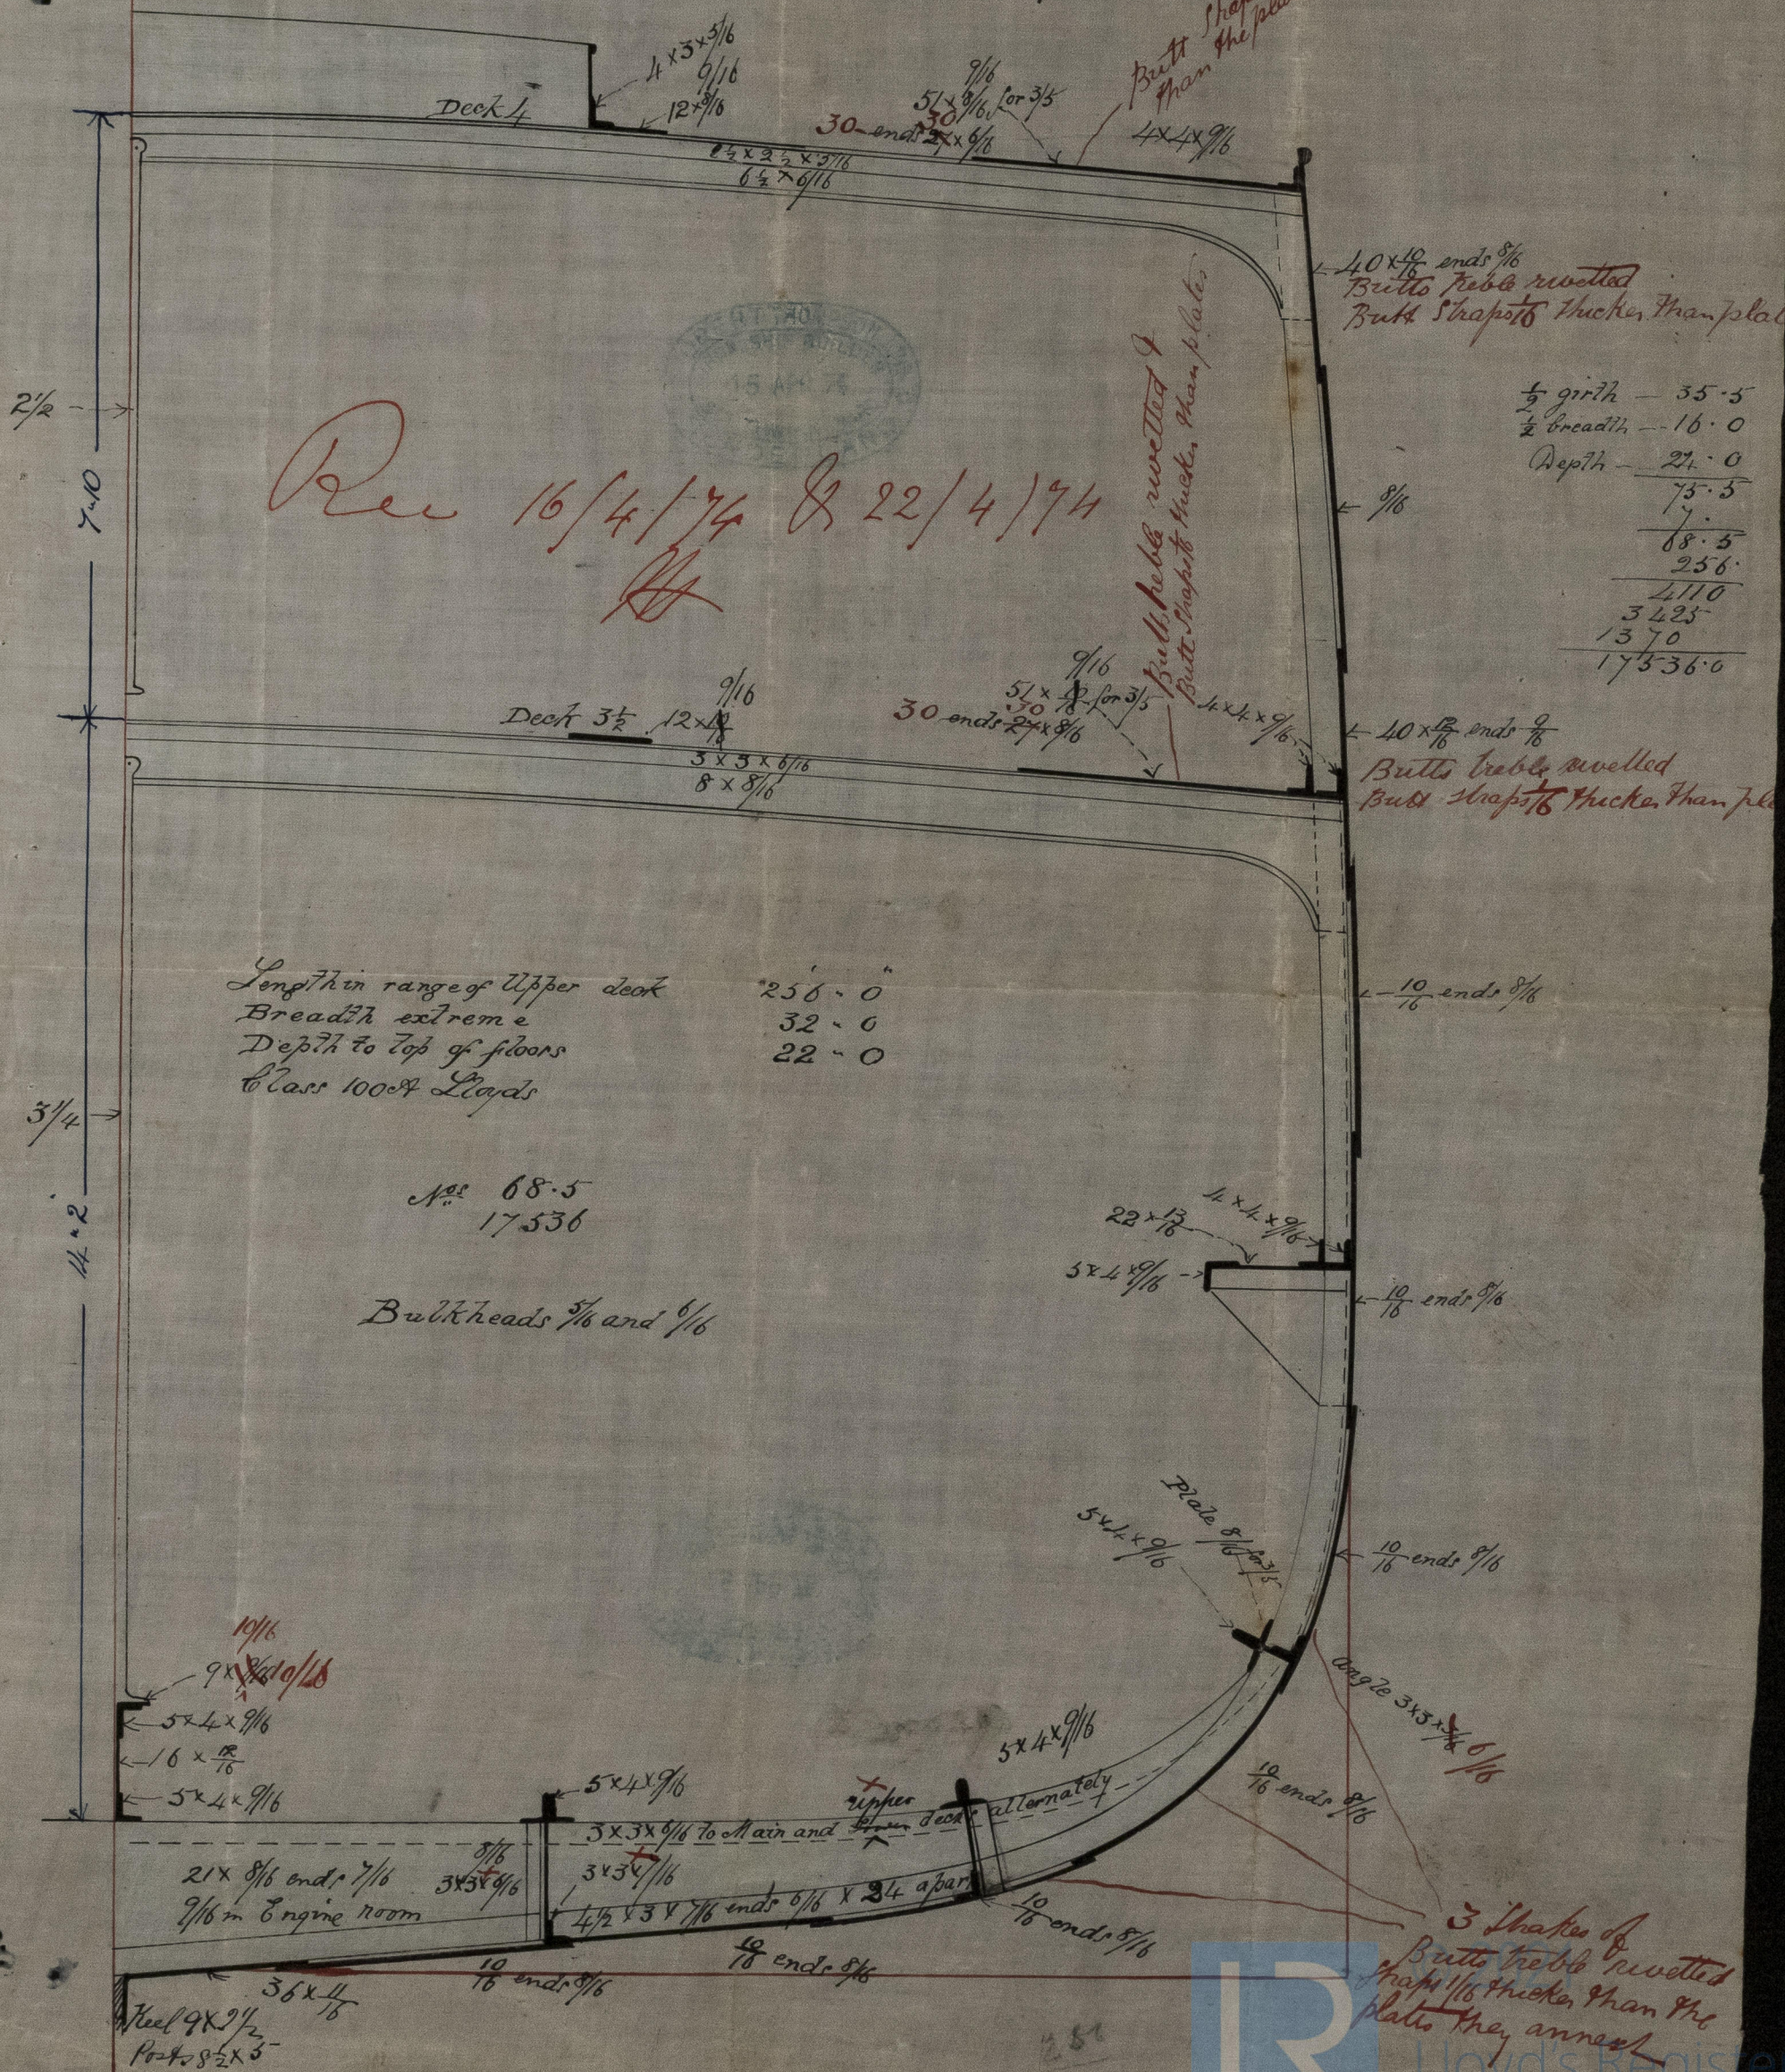

IRON 510 - 0188